
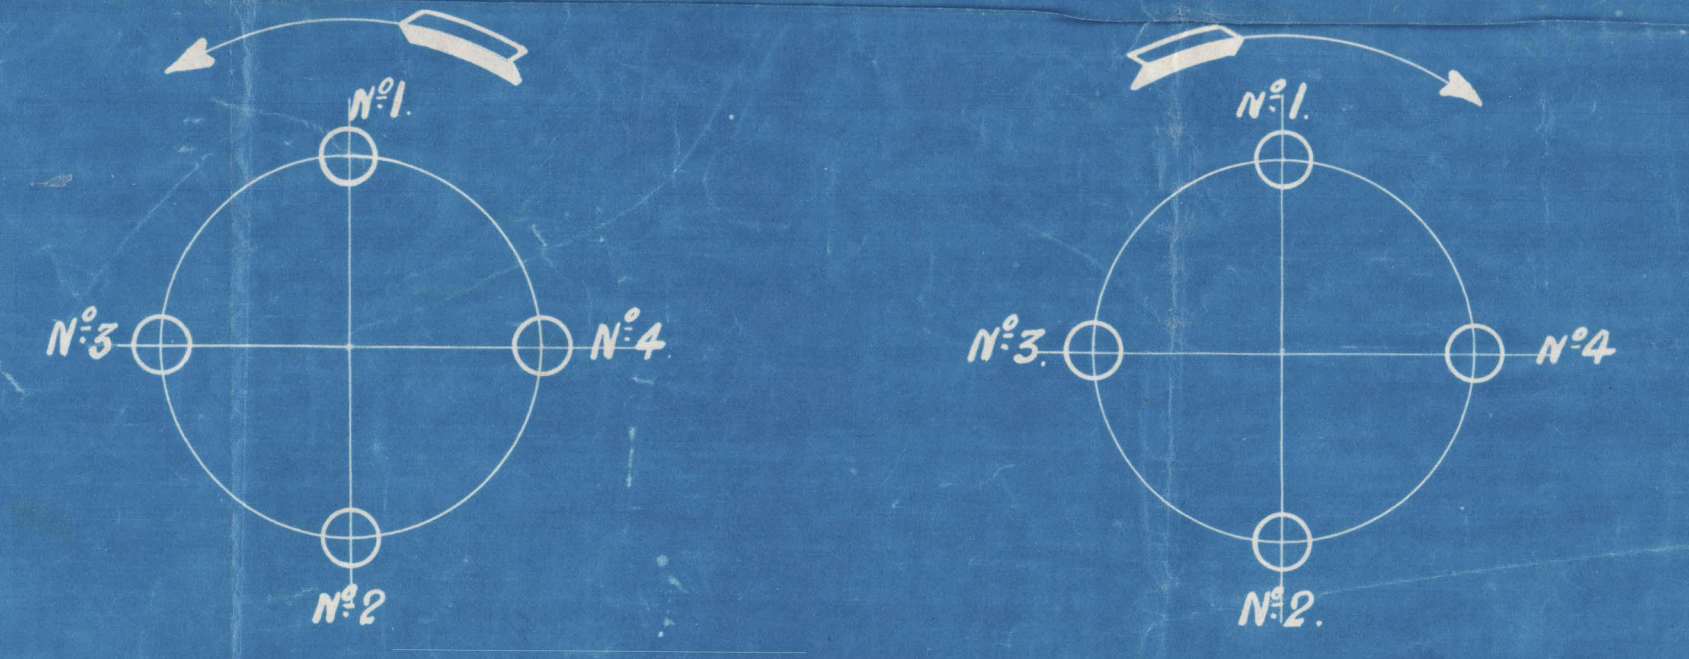
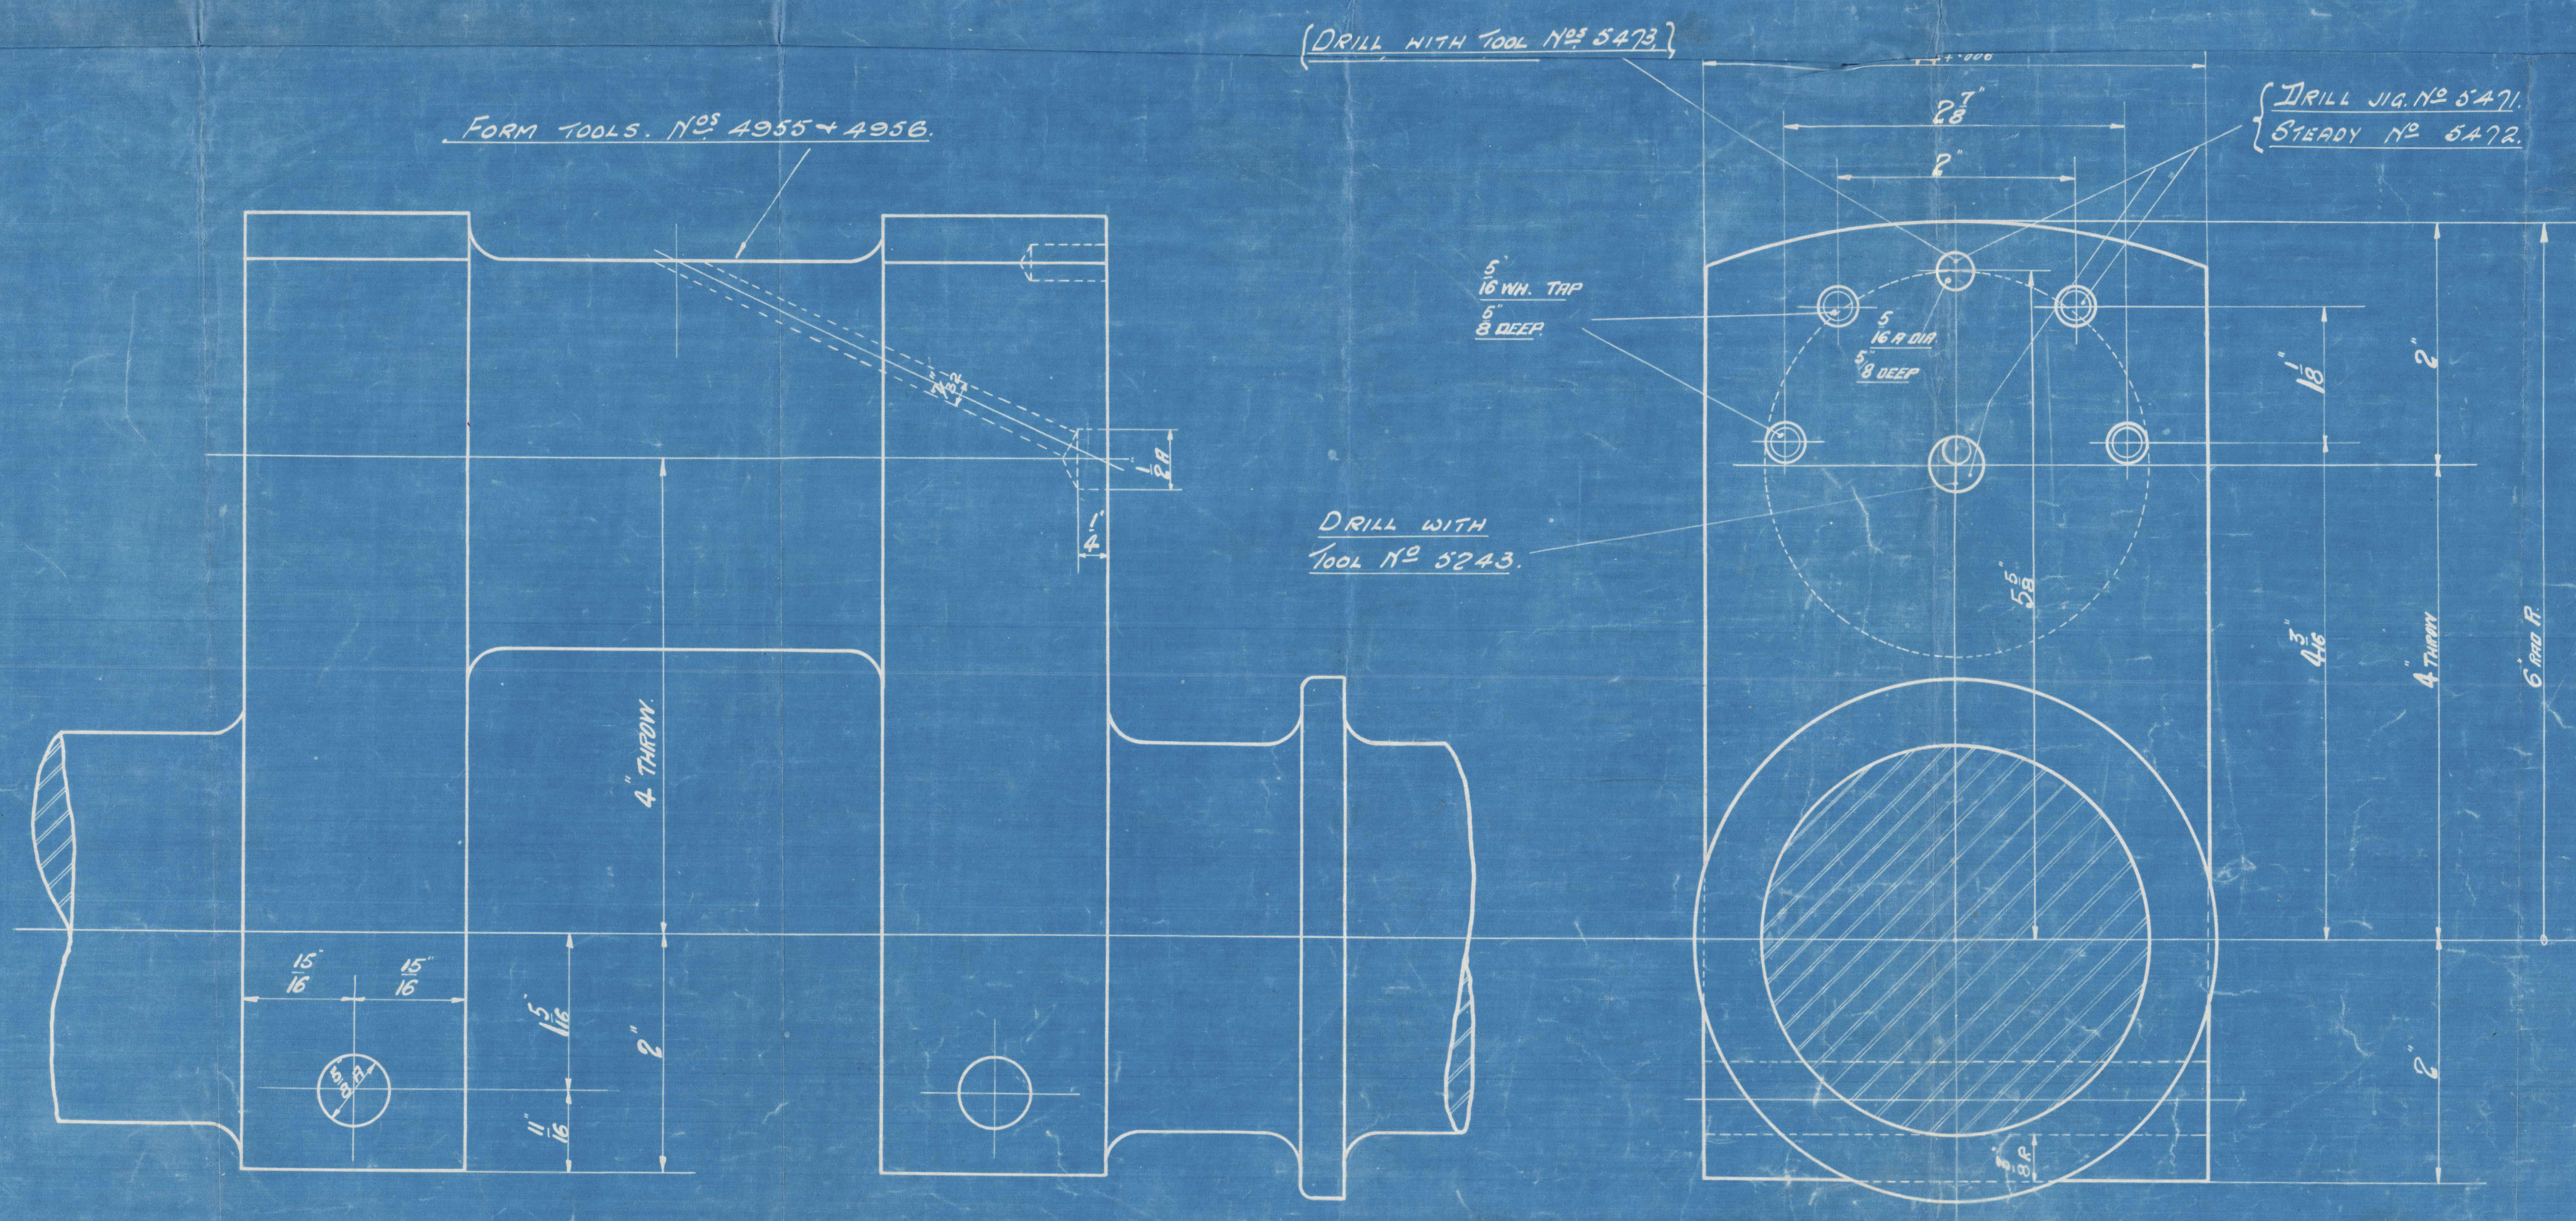


28-3-23

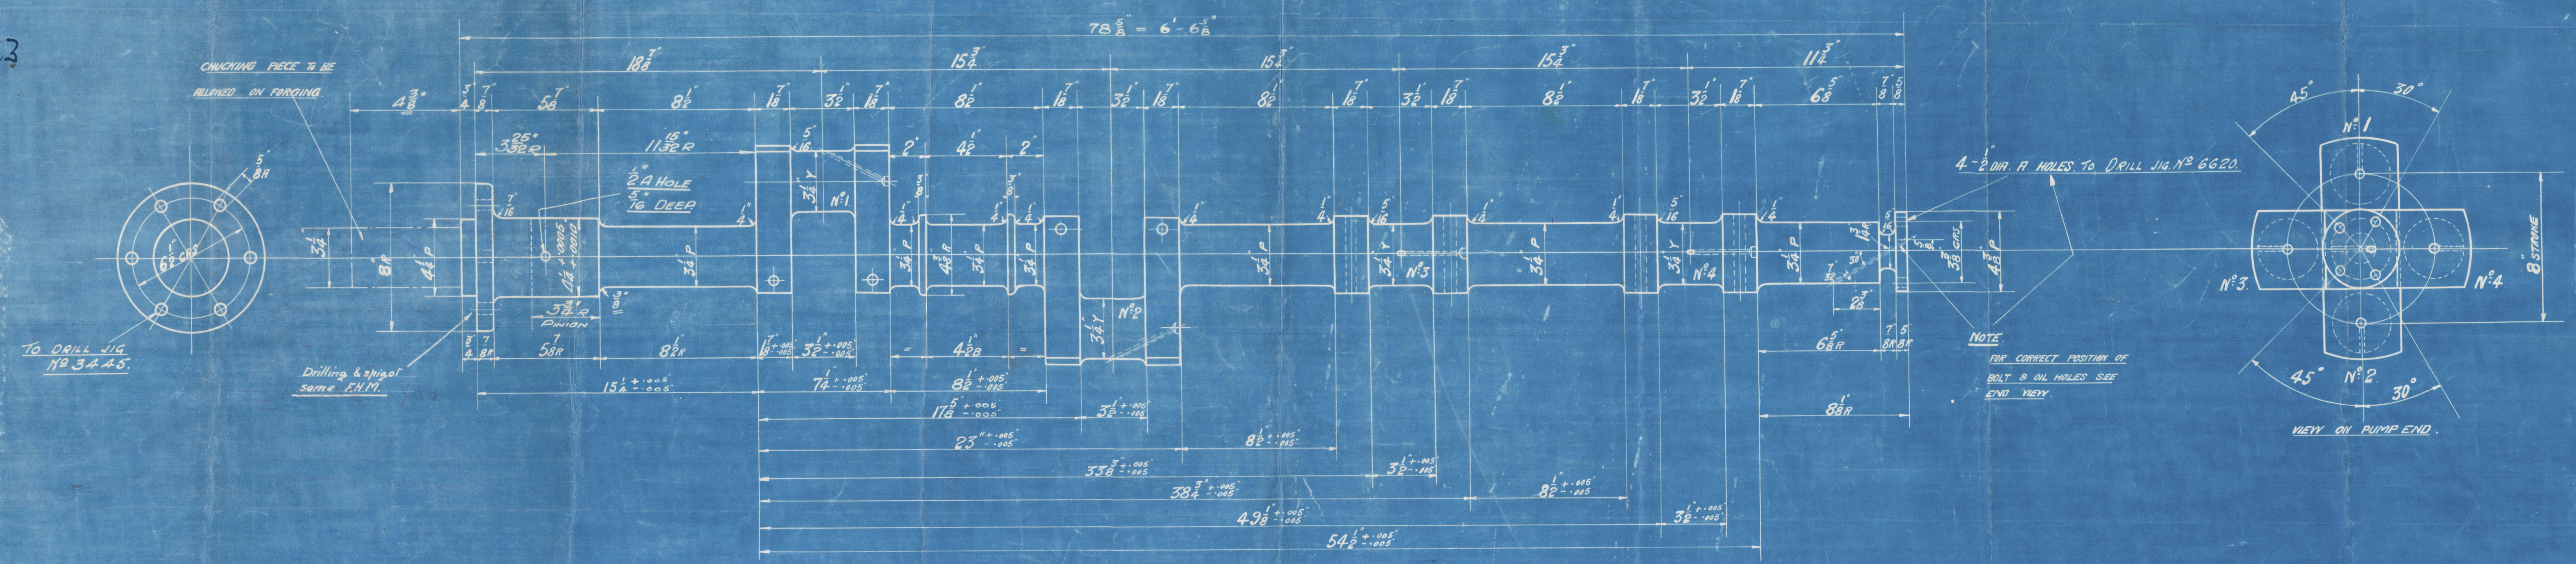

Frying tho  
654 A  
655 A  
656 A  
Firing: 2 long 654 } 6.6.23  
655 } (W)  
656 }

C.M. 4  
26-3-23

FOR CRANKSHAFT FORGING SEE DWG. N° 4372.C.

DWG. N°	TYPE 4 T 4 ENGINES (STANDARD & STARBOARD)	PART N° C5337
DESCRIPTION CRANKSHAFT	MATERIAL MILD STEEL 28-32 TENS	MACHINED ALL OVER
SCALE 1/4 & FULL SIZE	DATE 15-5-22	SUPERSEDES 19/27
		SUPERSEDED BY
		DRAWN BY
		TRACED BY
		CHECKED BY
L. GARDNER & SONS, LTD. PATRICROFT.		DWG. No. 4100



MANCHESTER.

Norman Hardy & Gardner Ltd

Sancti Spiritus. Amalg.

Engine  
for

Furness S. B. Co

S. H. 46

Crank Shaft

ENGINE Nos.

<sup>2</sup>35628, <sup>2</sup>35629, <sup>2</sup>35630

TYPE. 4T4.

Cert. C1608

S.S. Princess

MDB. RPT. No. 11920.



©(5)17.3.23

Lloyd's Register

W317400915