

2/1172/36. *1542*

PROFILE & DECK.  
TWIN SCREW MOTOR YACHT.

TO CLASS LLOYDS 100 A1 YACHT RULES.


SCALE  $\frac{1}{4}$ " = 1 FOOT.

PRINCIPAL DIMENSIONS

LENGTH ON W.L. 118'-0"  
BREADTH MLD. 21'-0"  
DEPTH MLD. 11'-6"

LLOYDS NUMERALS

NETT = 121.16  
= 10.5  
D = 11.5  
TRANSVERSE N° = 22  
= 10.53  
22 x 100 = 52.3  
LONGITUDINAL N° = 2665.52  
RATIO FACTOR 1.0021  
CORRECTED LENGTH N° 2671.12.

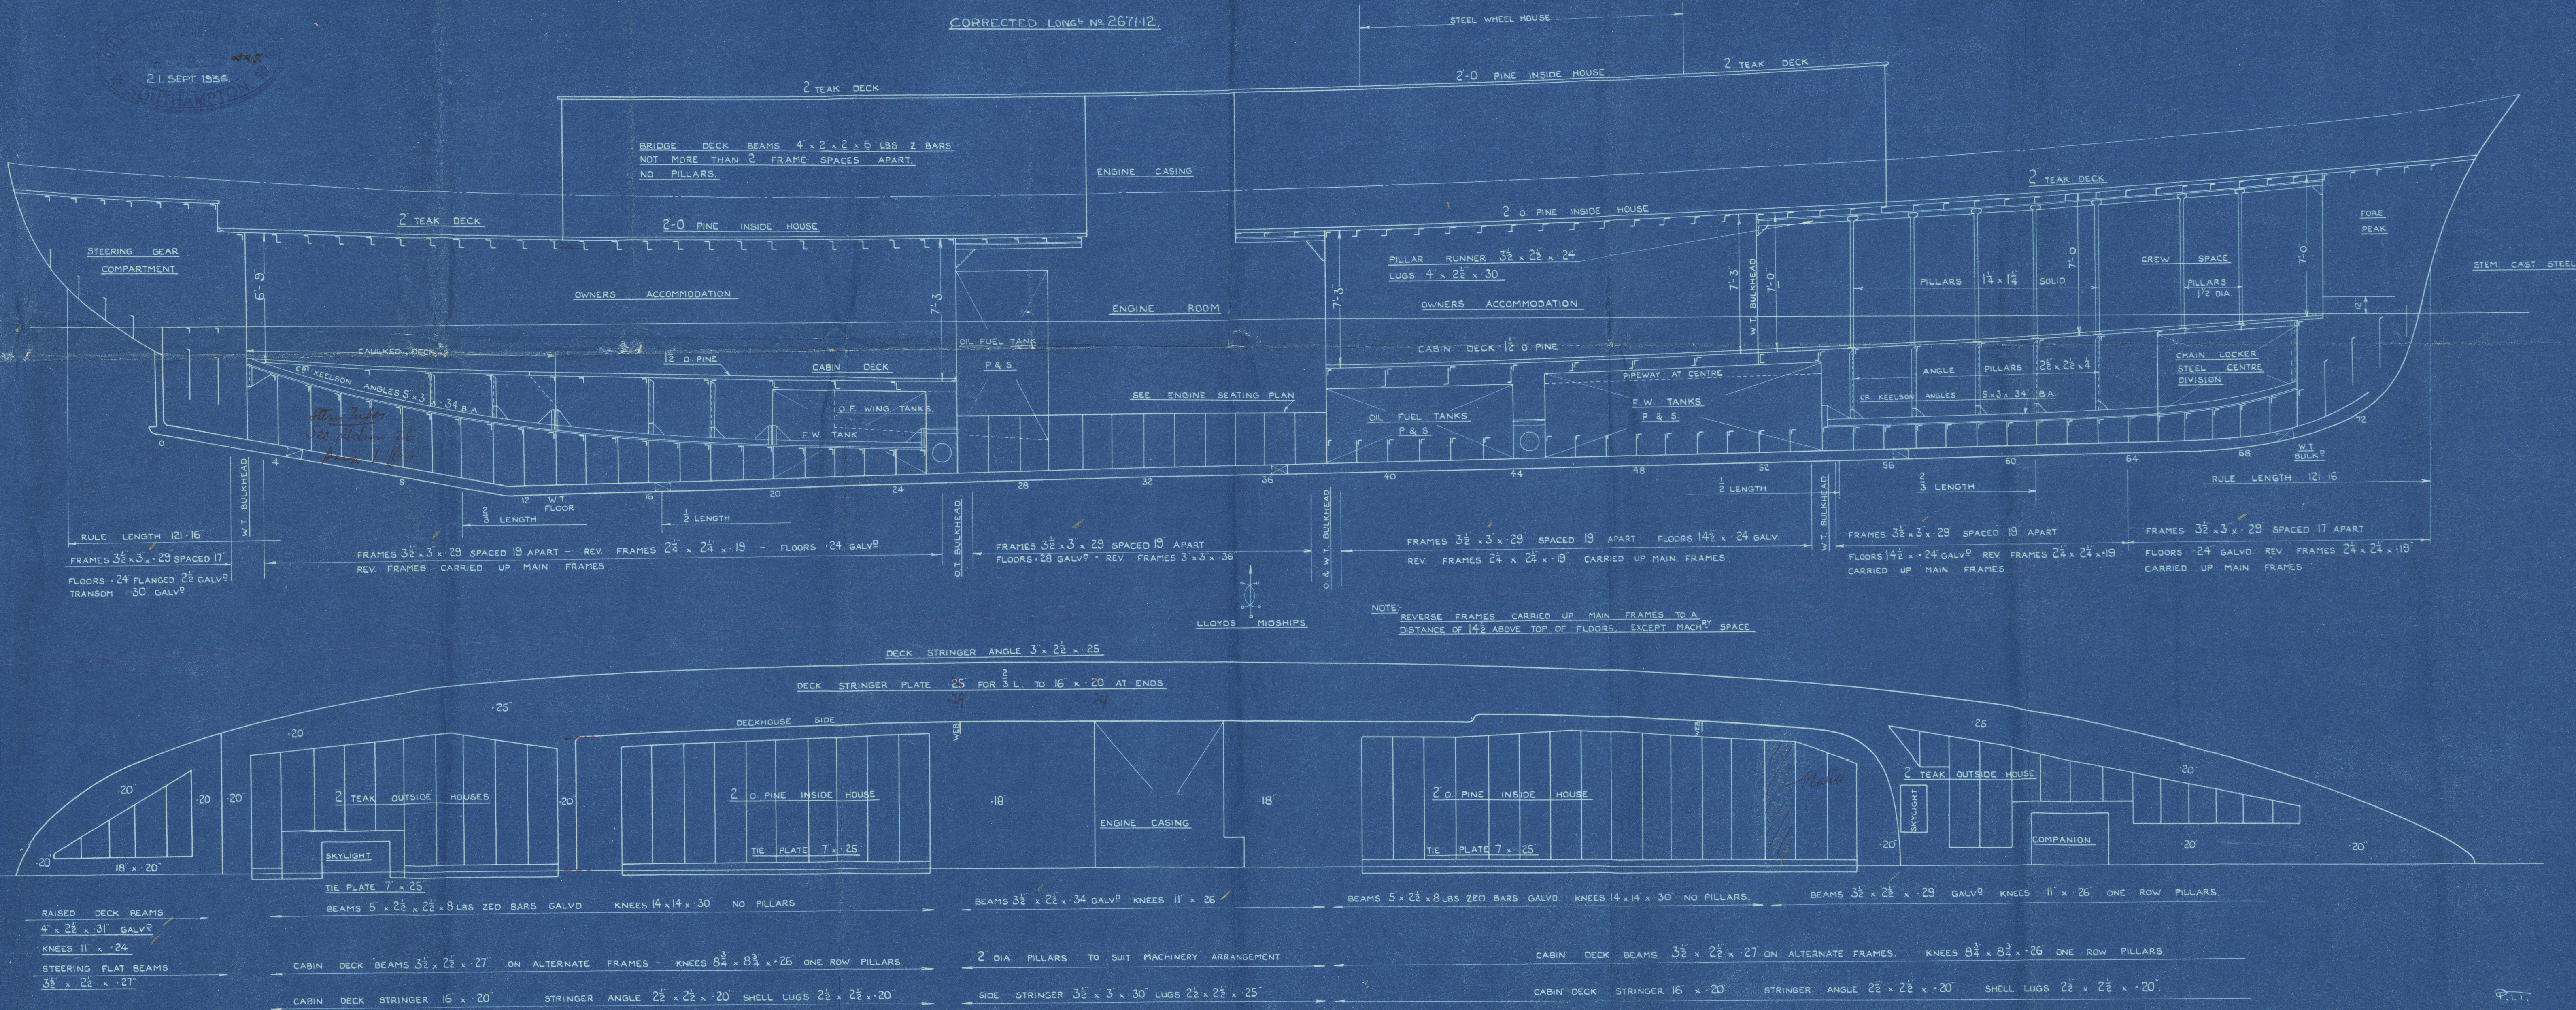



STEEL T.S.M.Y. N° 1172.  
J. I. Thompson & Co. Ld.

PROFILE + DECK.

Moh. Yacht Tadorua.  
Son. rept. No 16791.

W319-0025



© 2019

Lloyd's Register  
Foundation