


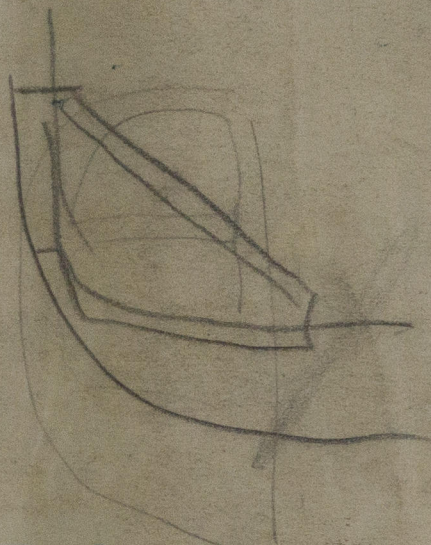

Hawthorne + Co 91  
Amended Profile Plan.  
S/S "Surf".

Report no. Lth. 10126.

W 5705.



© 2019

Lloyd's Register  
Foundation

W319-0095