

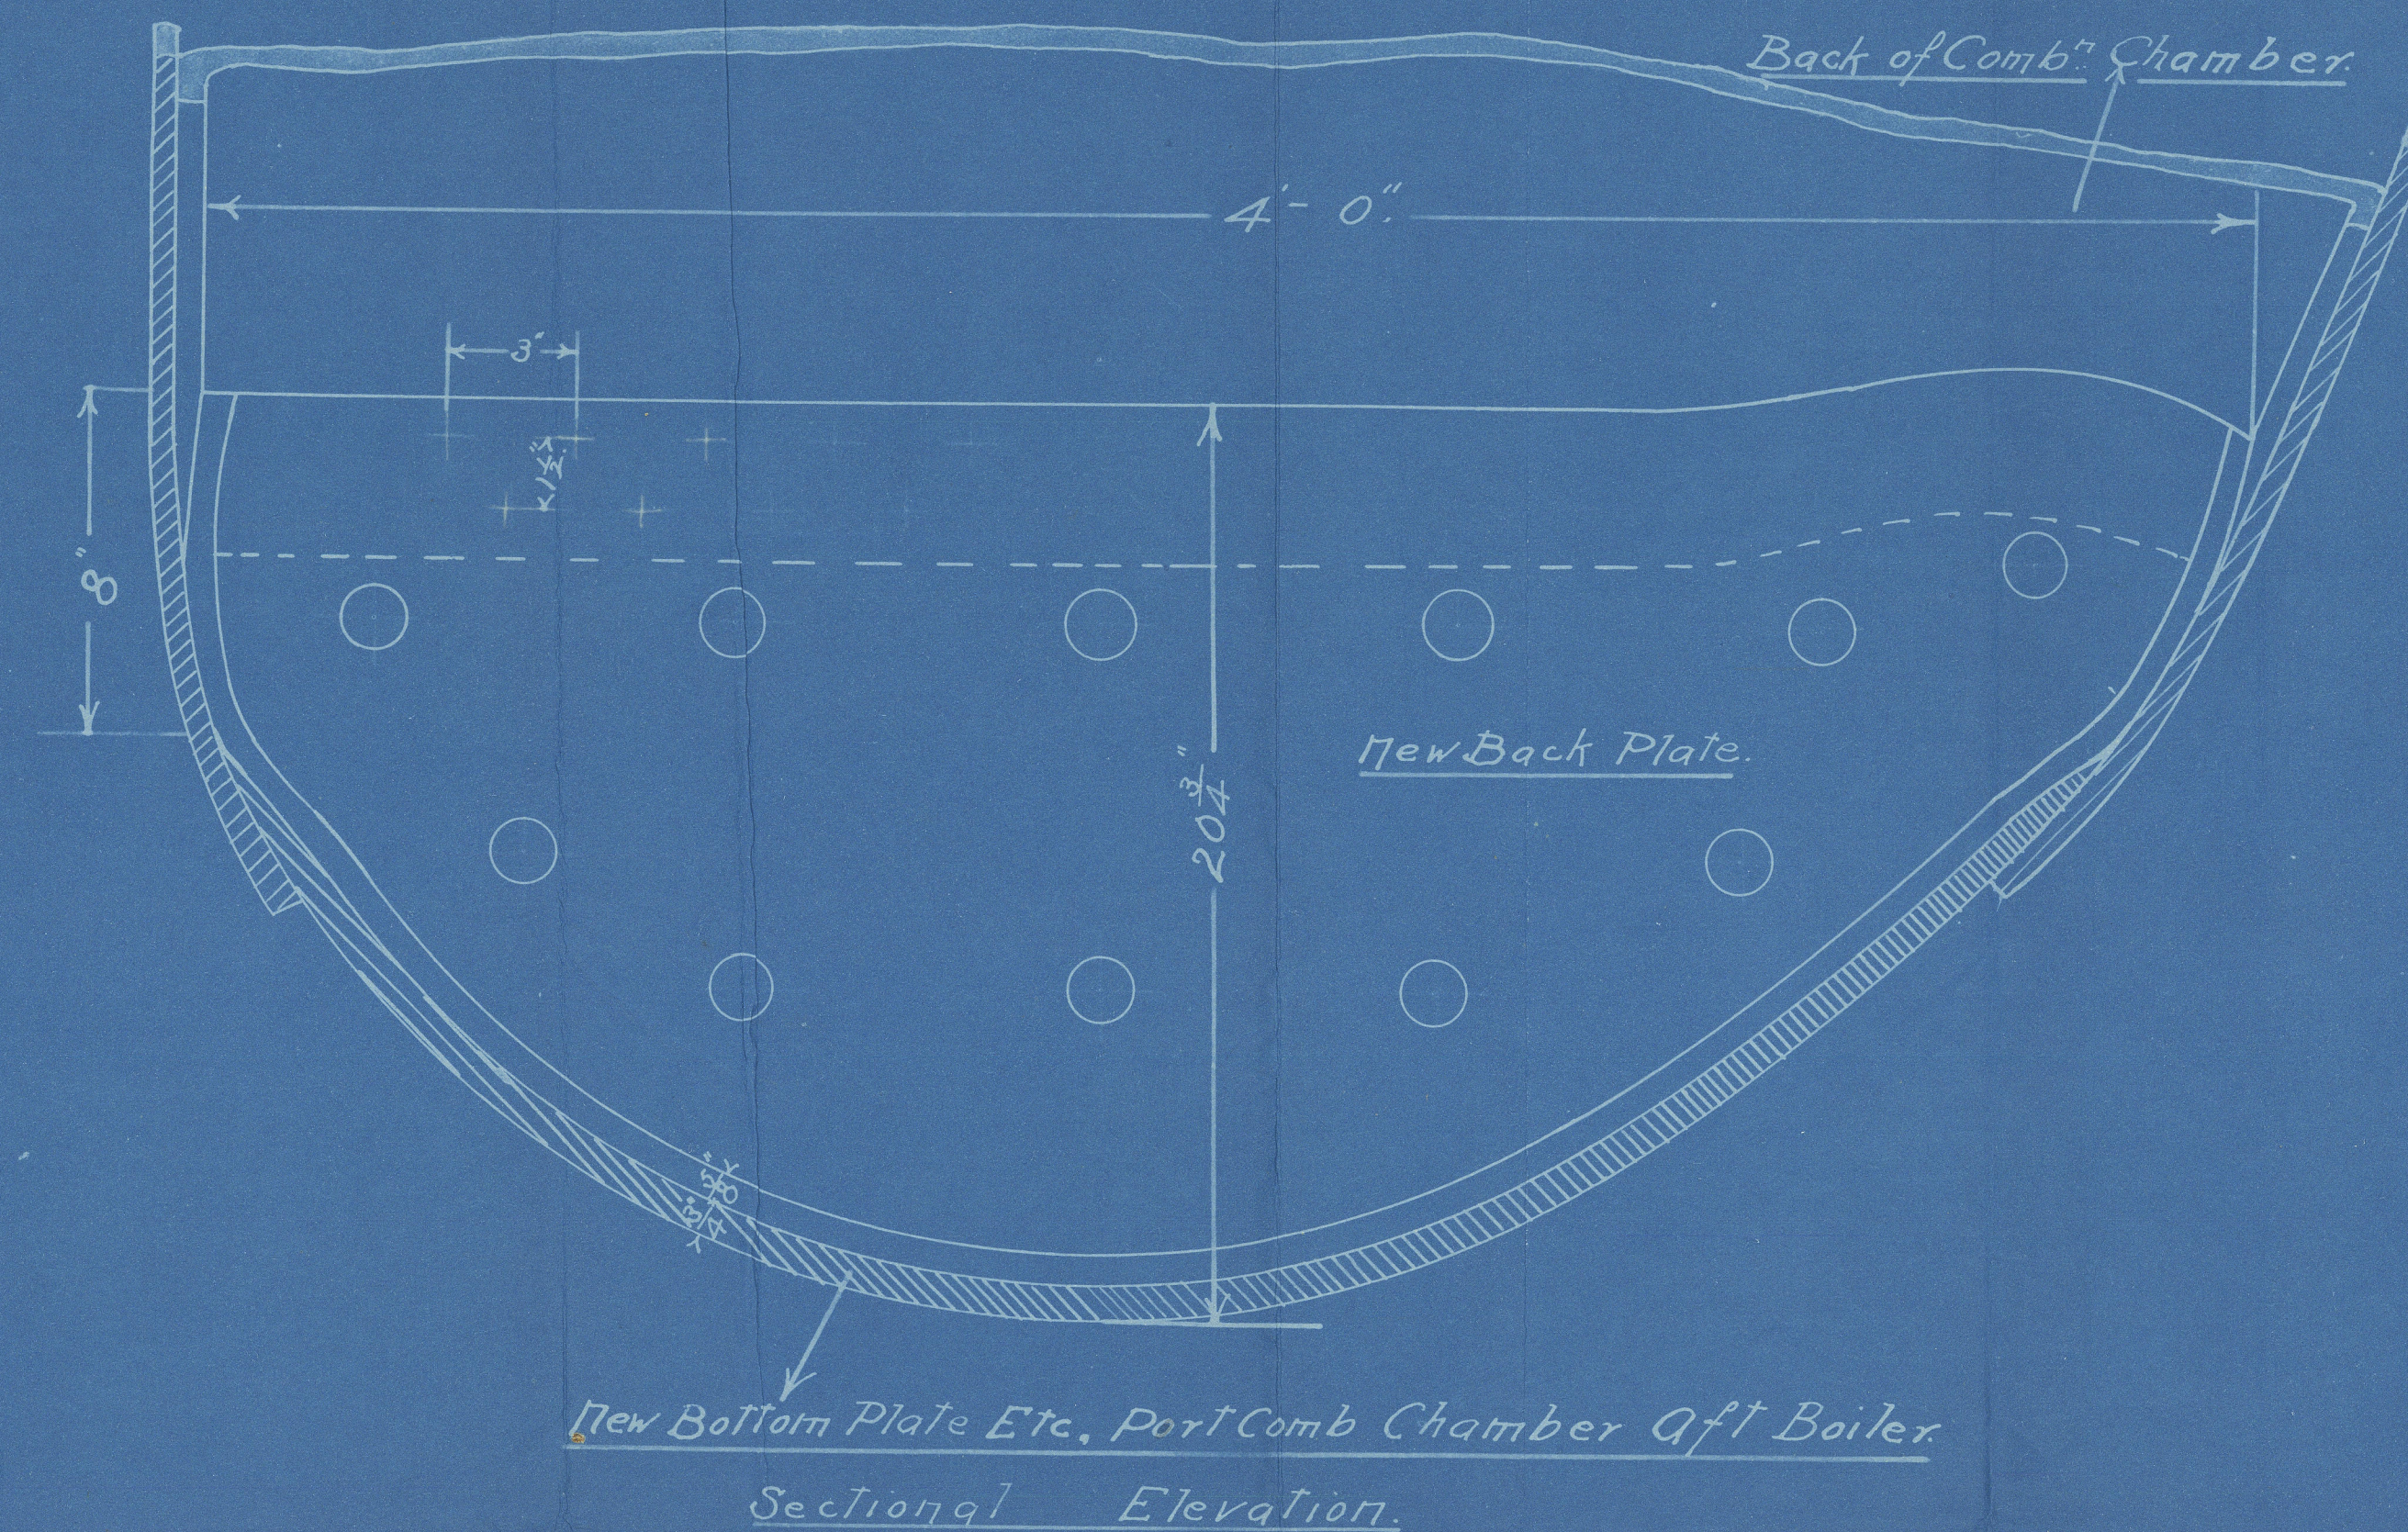


Section Thro AA.

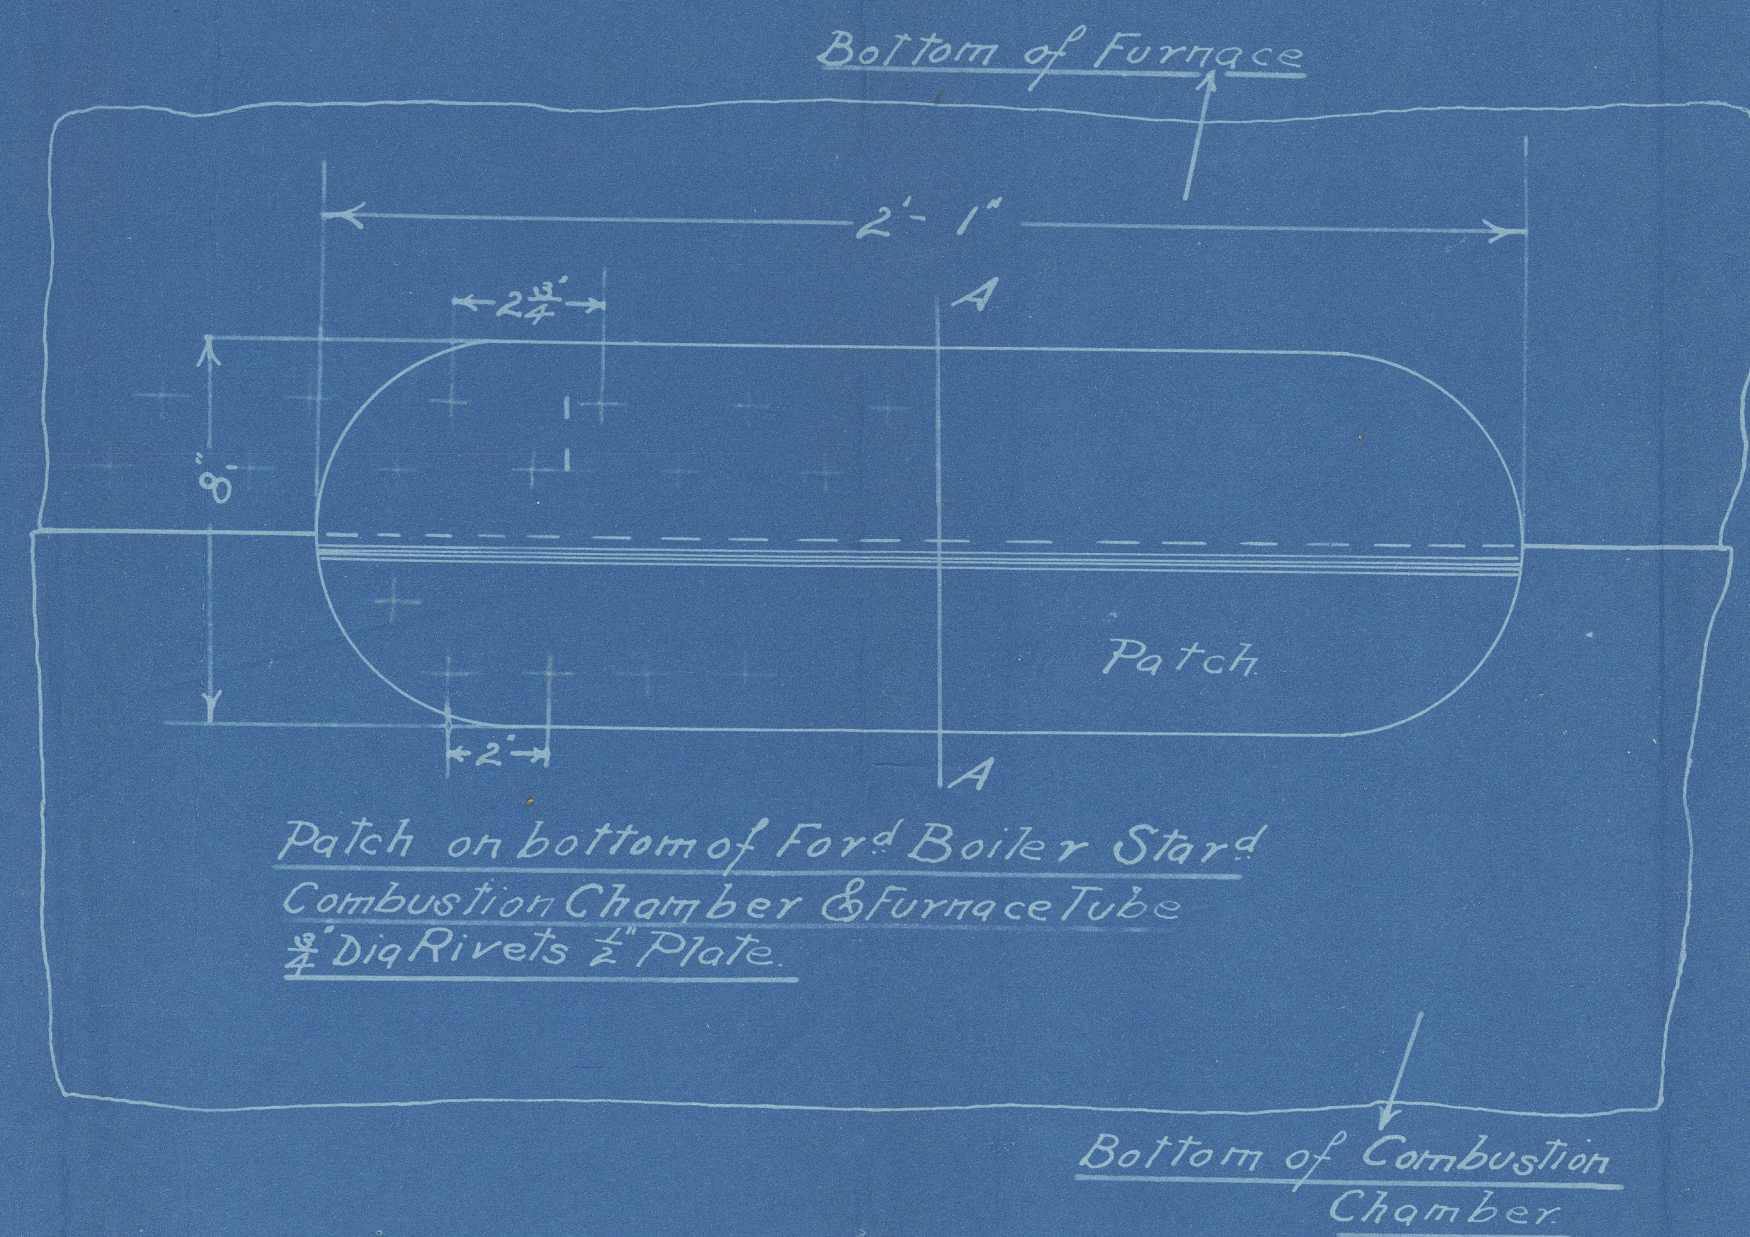

H. M. Y. "Surf"
3rd Lt. 22-8-16.

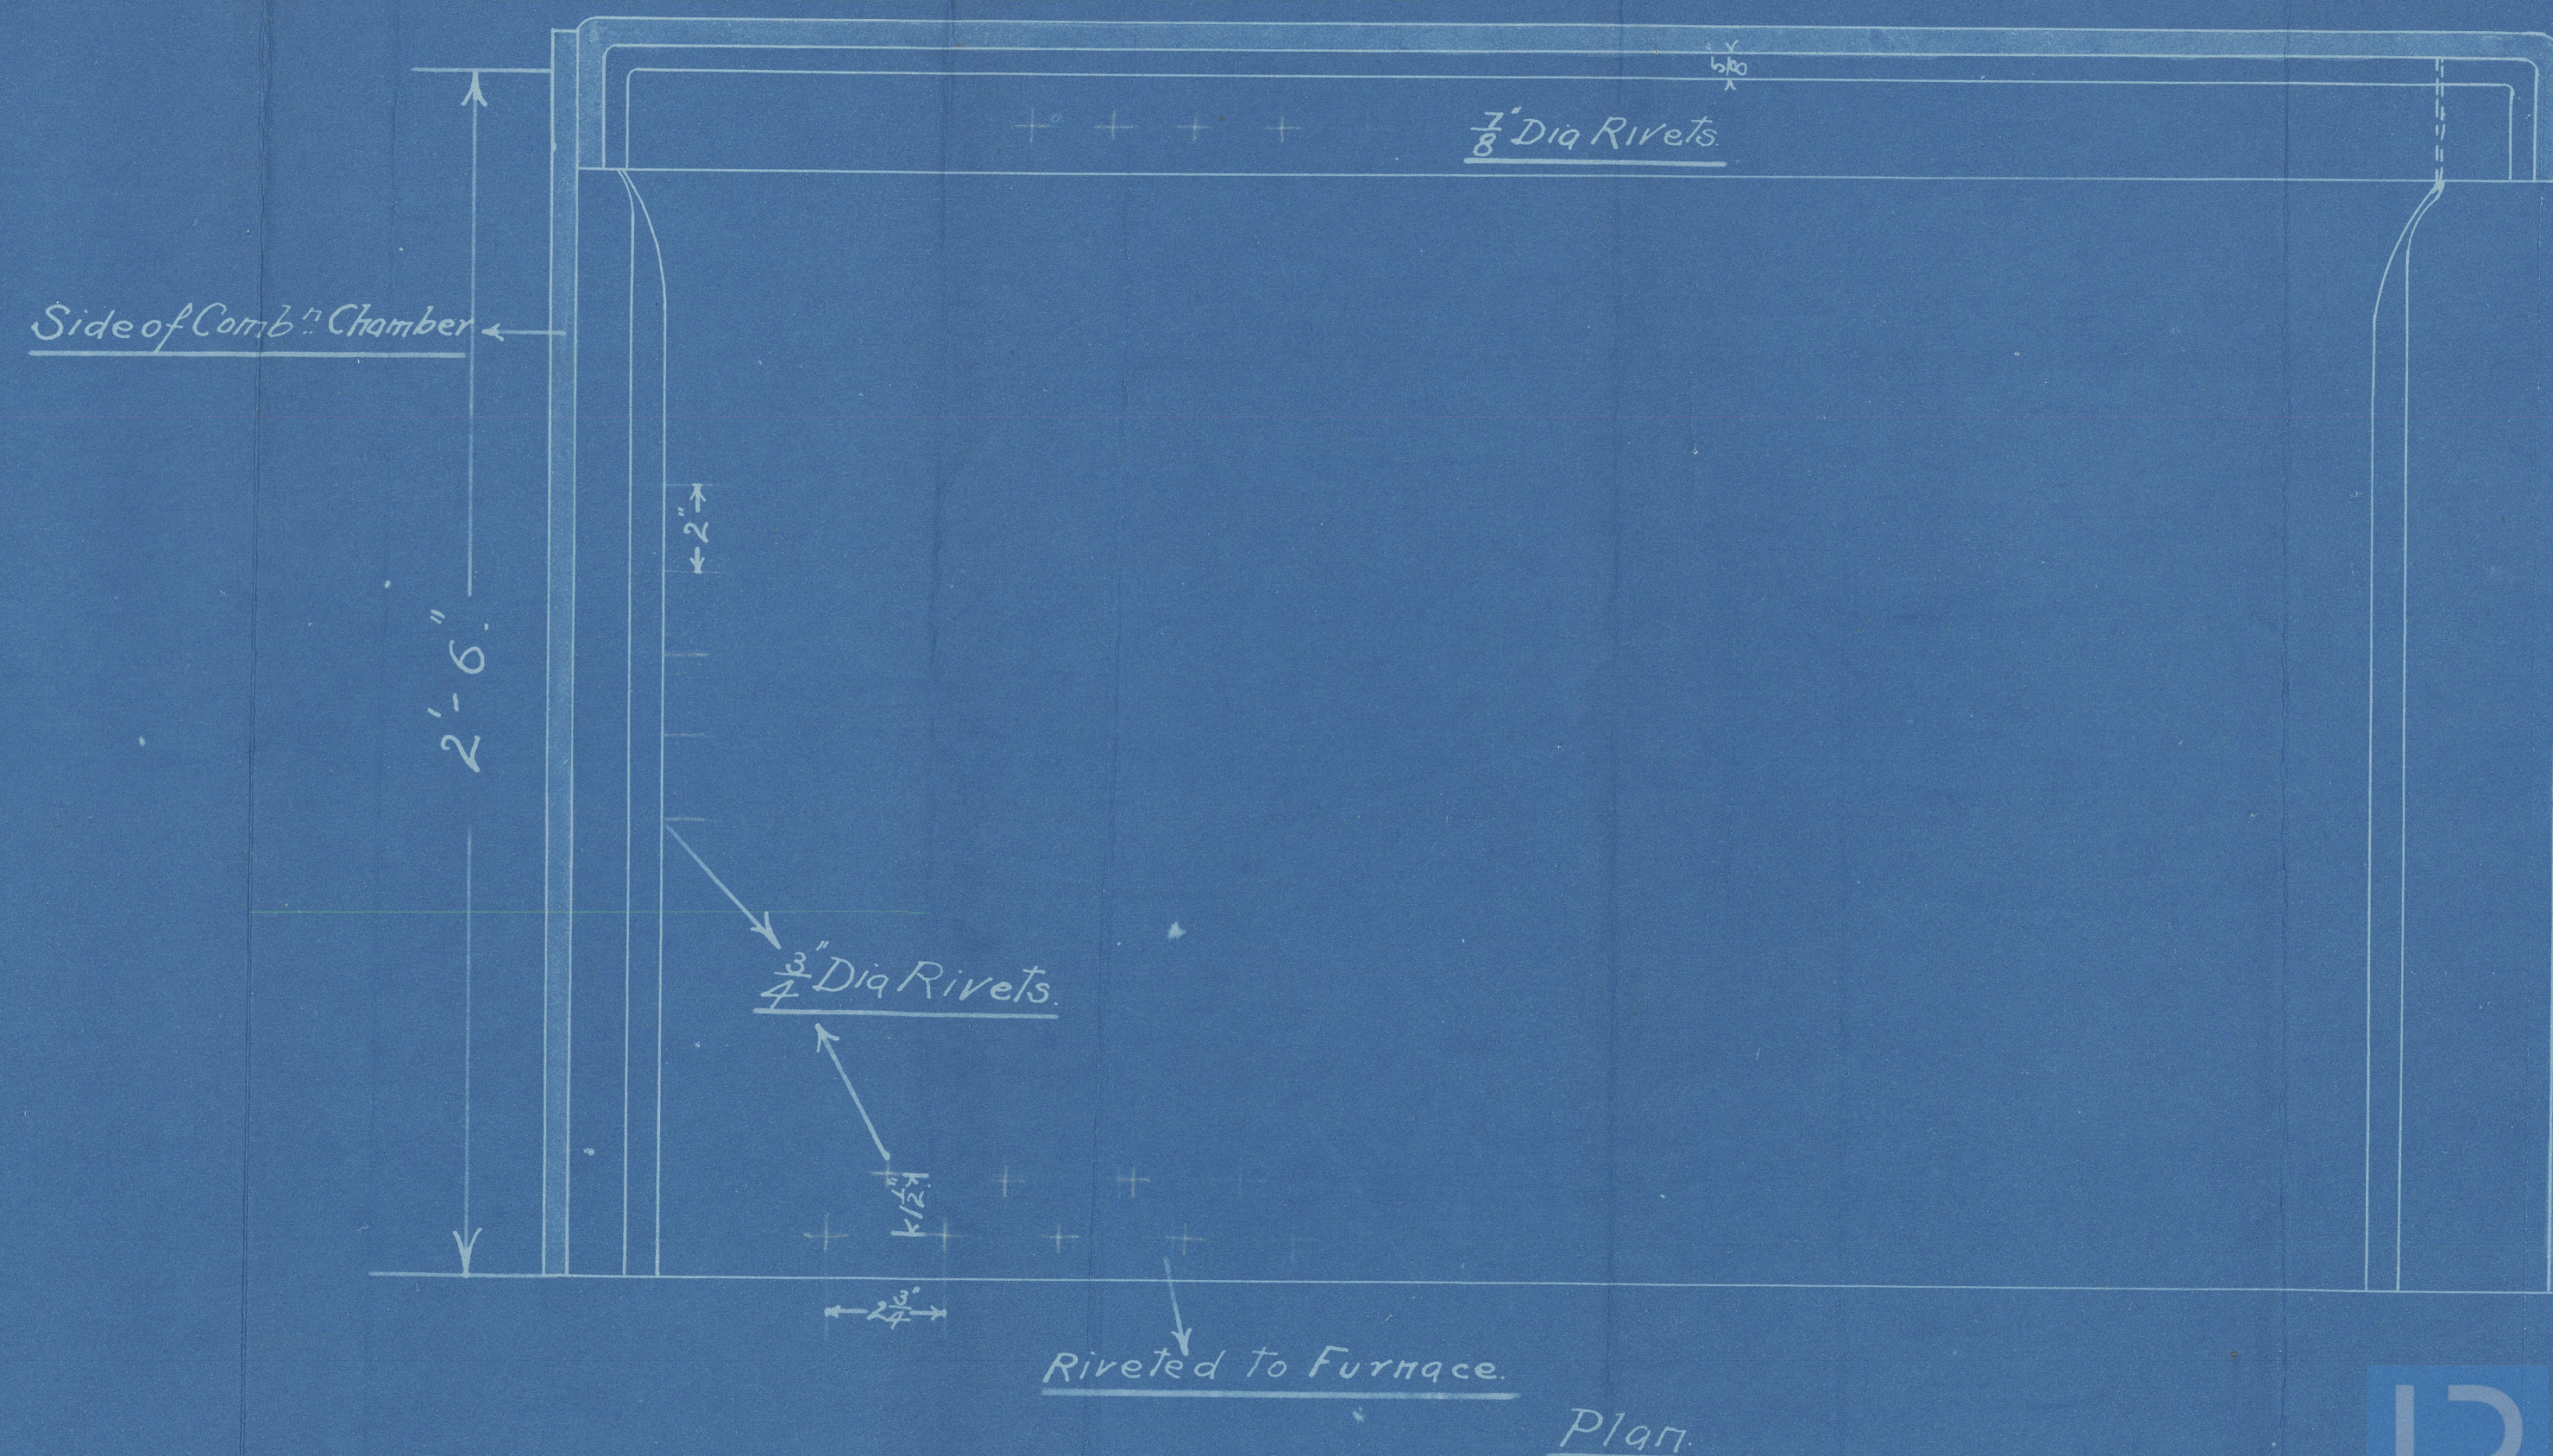

Yacht
"Surf"


Rept. no. Lth. 10126

Sketches of Repairs
to Main Boilers
Aug 1916



Dub
28/8/16
Jmw

W319-0099

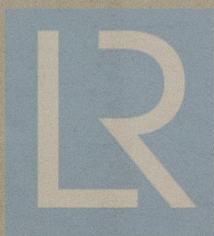

© 2019

Lloyd's Register
Foundation