


5.3.21

Twin Screw Motor Yacht — No 307.

Steel Arrangement.

Scale  $\frac{1}{4}" = 1 \text{ Foot.}$

CAMPER & NICHOLSON LTD.  
SOUTHAMPTON.  
DRAWING OFFICE  
No. 2-3-21  
Date 5.3.21

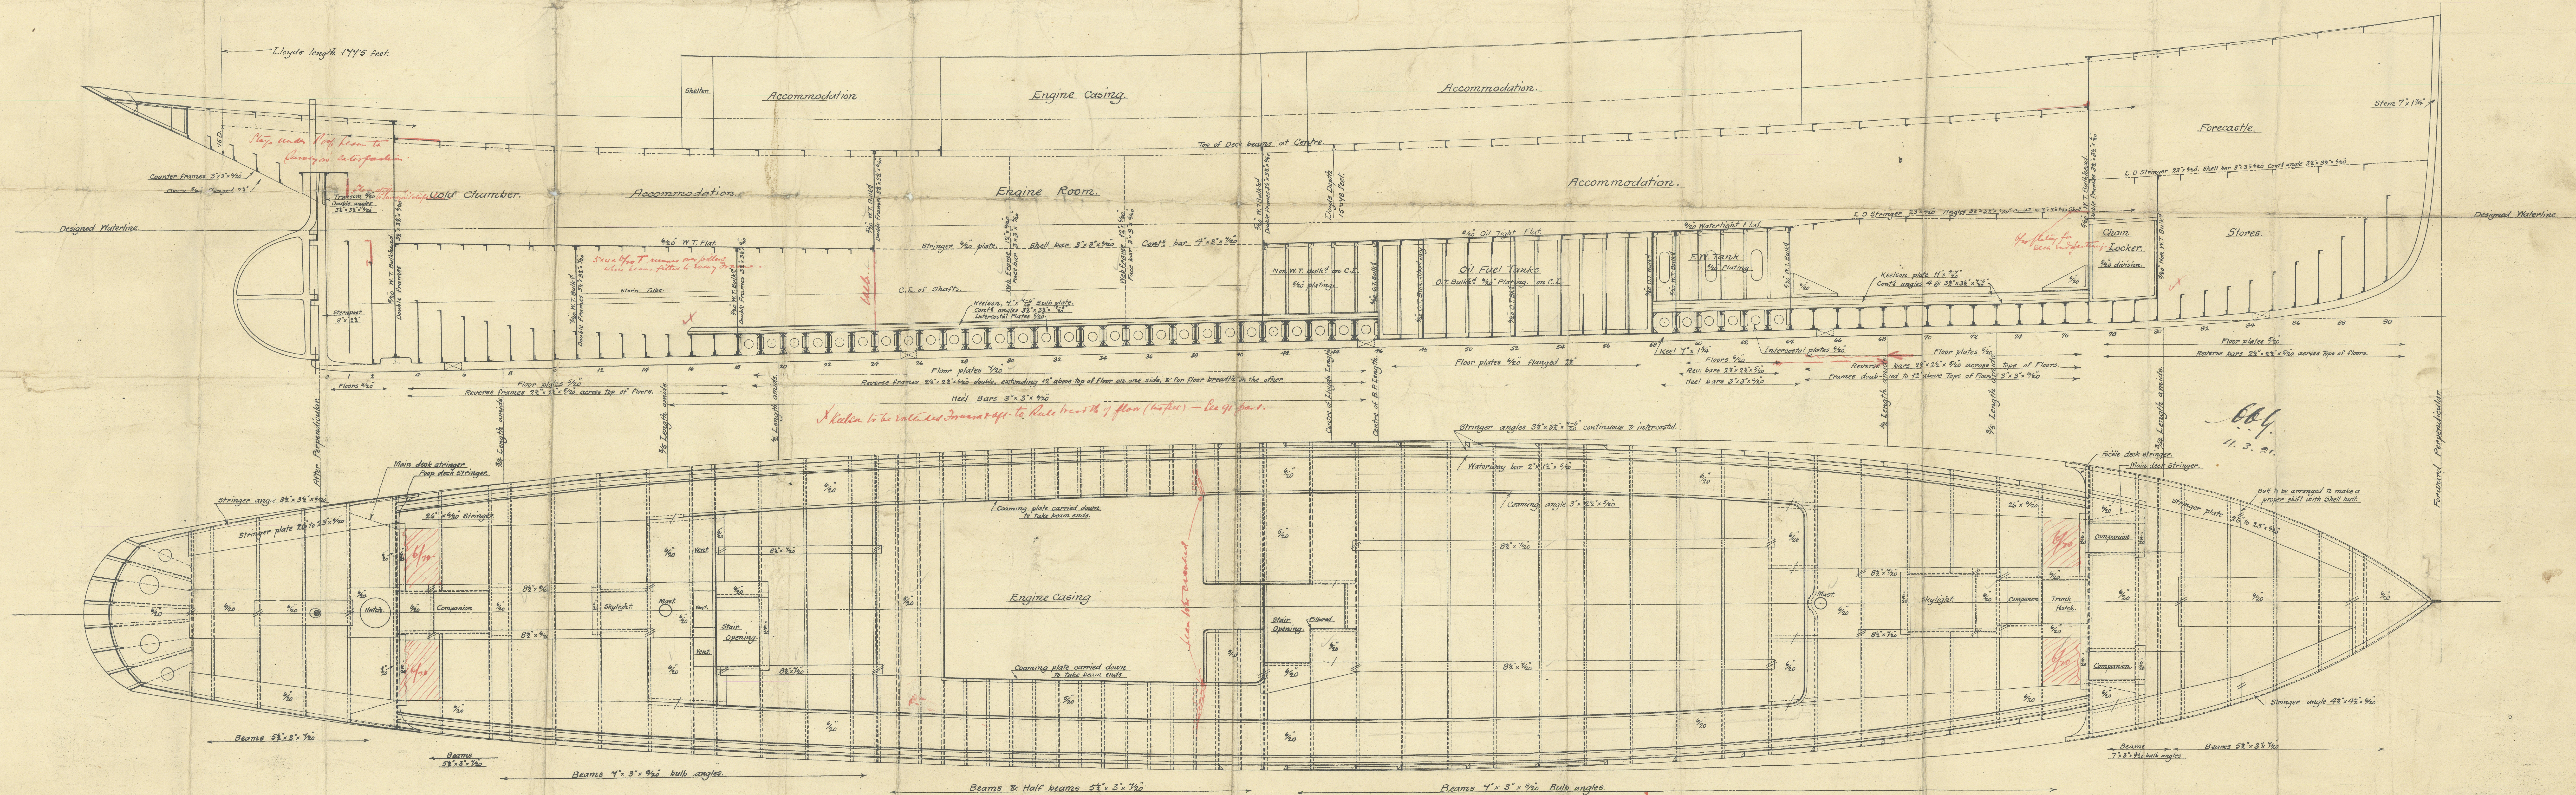

285  
2-3-21

CAMPER & NICHOLSON LTD.  
SOUTHAMPTON.  
DRAWING OFFICE  
No. 2-3-21  
Date 5.3.21

© 2019  
Lloyd's Register  
Foundation



Sonithampton.  
Messrs. Camper & Nicholsons W307  
Twin Se. Motor Yacht  
Perpida - Dutch.

Motor Yacht. Sona.

Sou Report N<sup>o</sup> 11316.

W319-0170



© 2019

Lloyd's Register  
Foundation