


SS "INANDA"

S.E. BOILER


DAMAGE SEPTEMBER 1941

SCALE :- 1" = 1 FOOT.

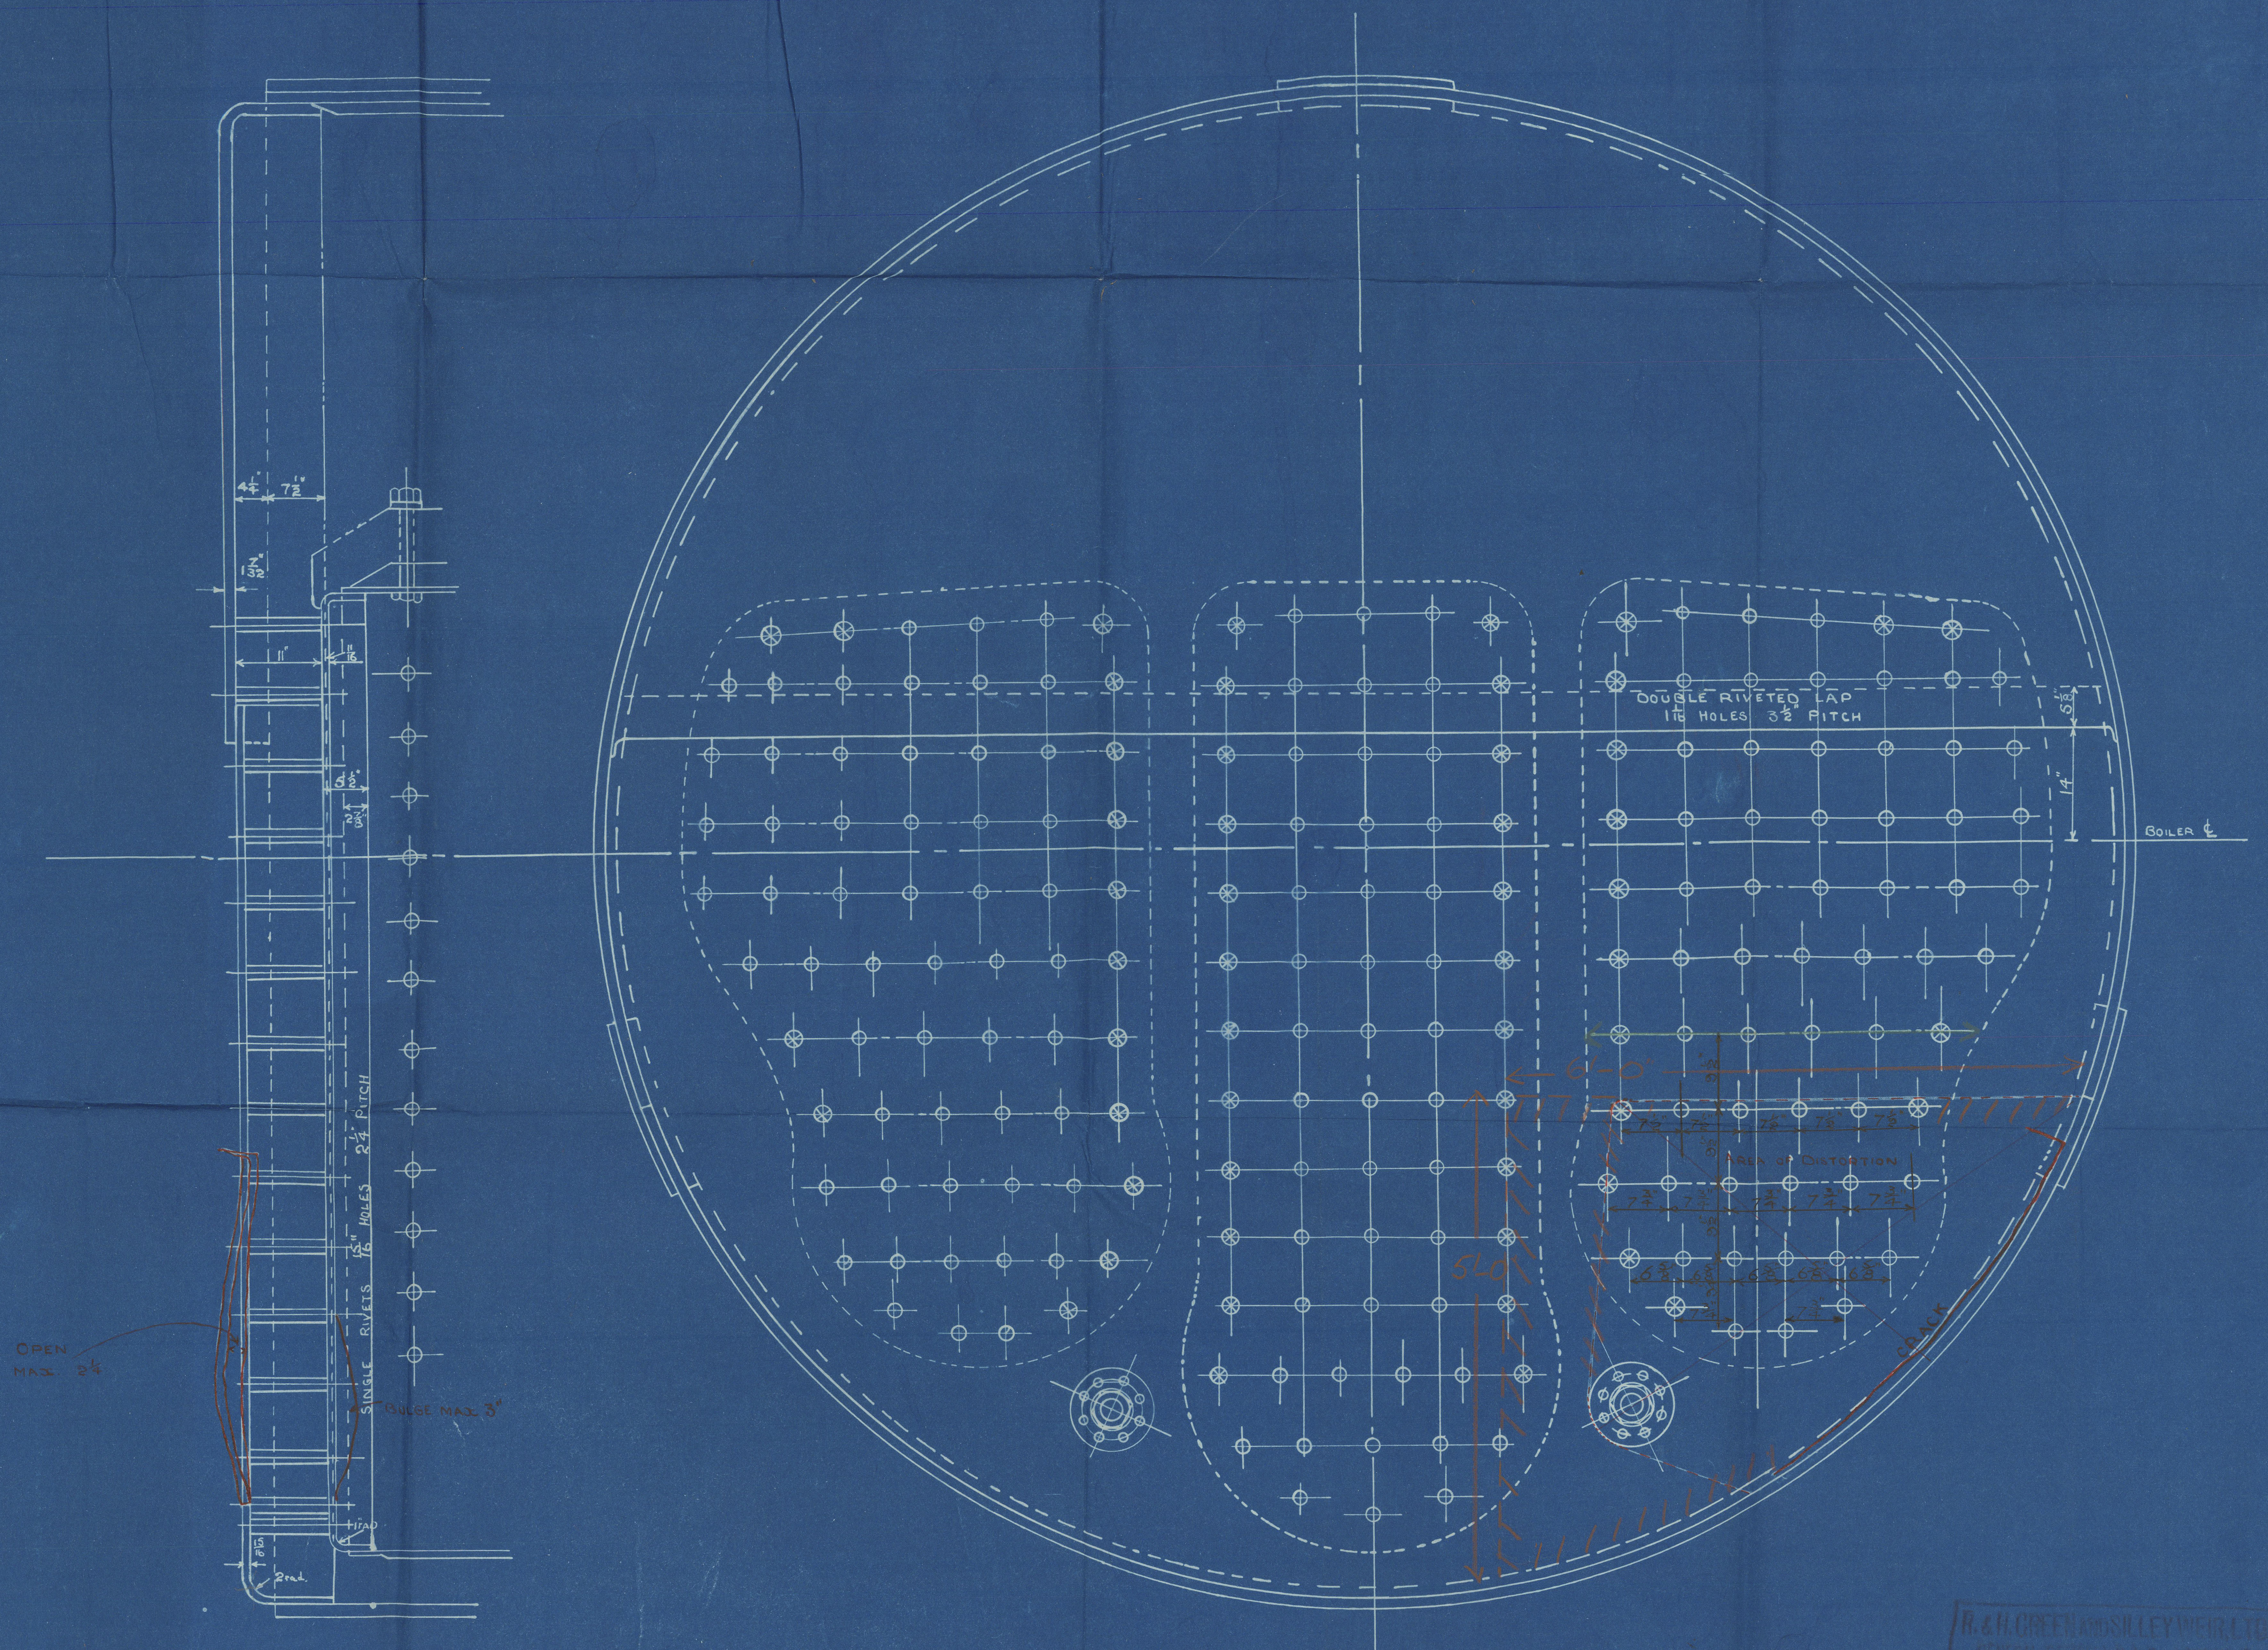

1 1/2 STAYS MARKED THUS - ○
2 STAYS MARKED THUS - ⊗

DESIGN ENGINEERS	
STAY	1941
22047	
DRAWN BY	DATE
19-9-41	

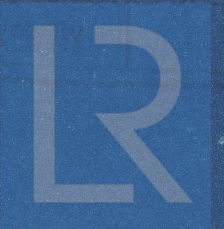

Lloyd's Register
Foundation

W32-0030

Empire Explorer

Lon 110267.

S.E. Bl.,

W32-0030



© 2020

Lloyd's Register
Foundation