
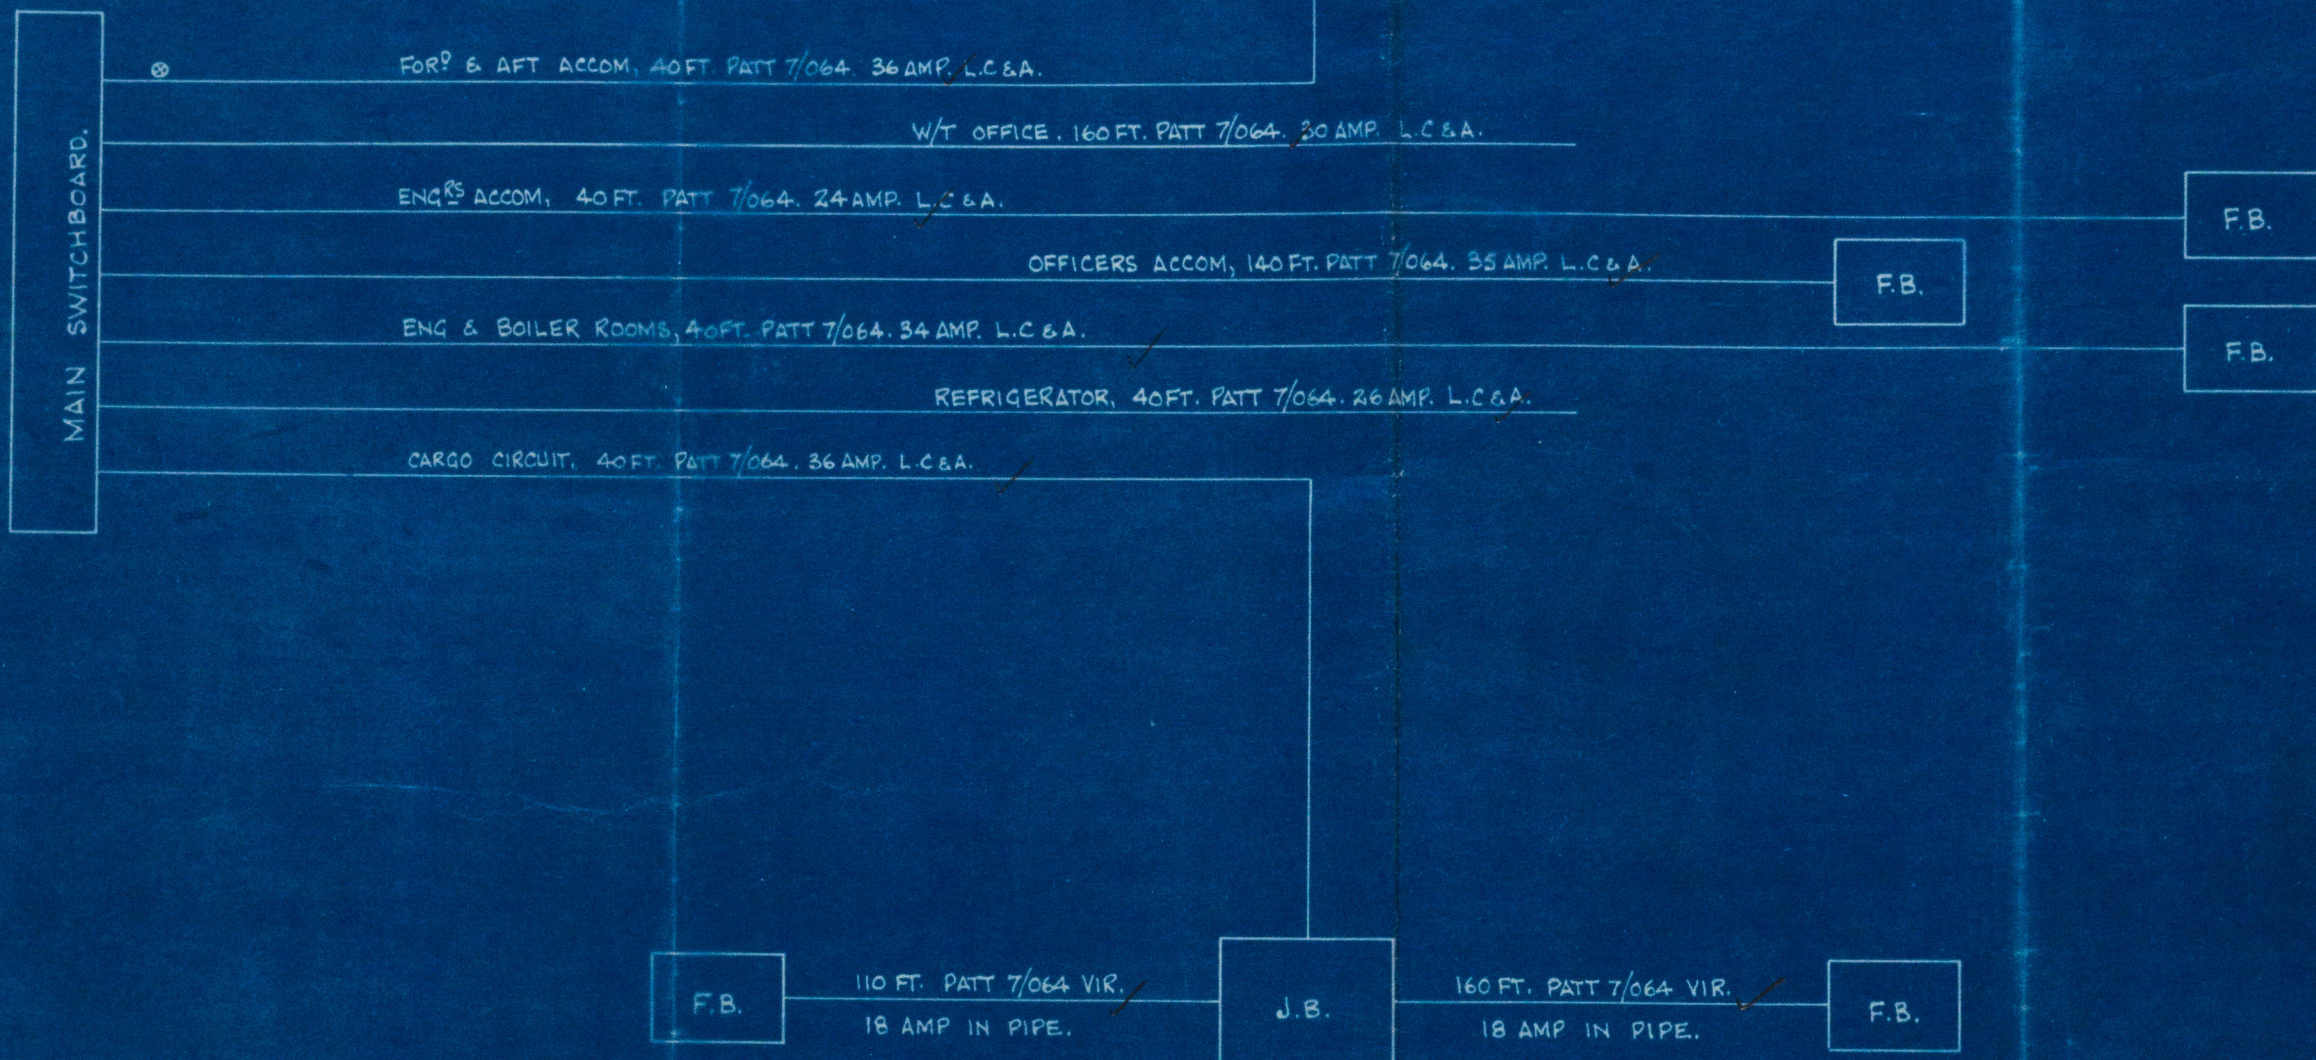


INANDA

207-110267


WIRING CIRCUITS.

⊗ WIRE THESE FUSES 50 AMP.
 0 " " " 30 AMP.
 ✓ " " " 25 AMP.

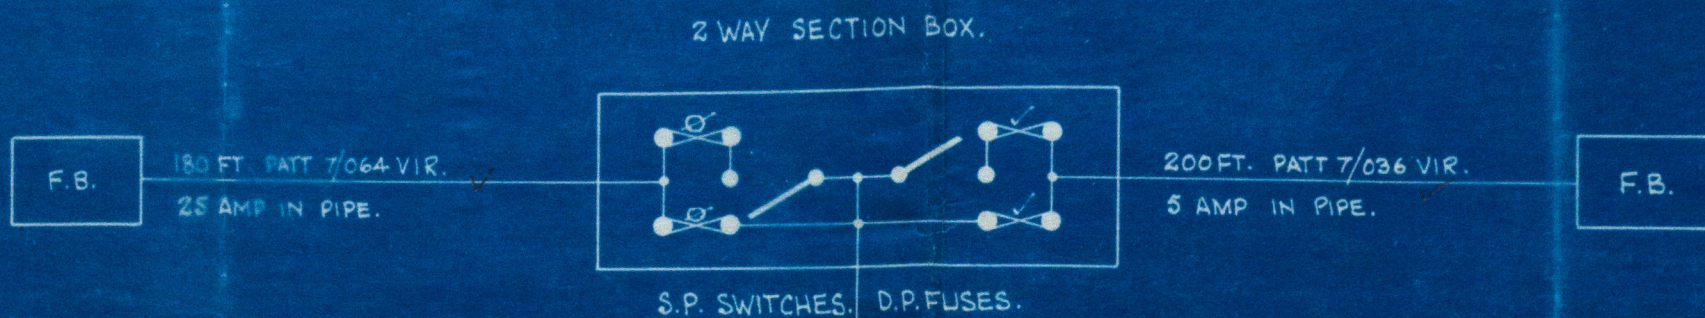

INANDA

MAIN SWITCHBOARD.

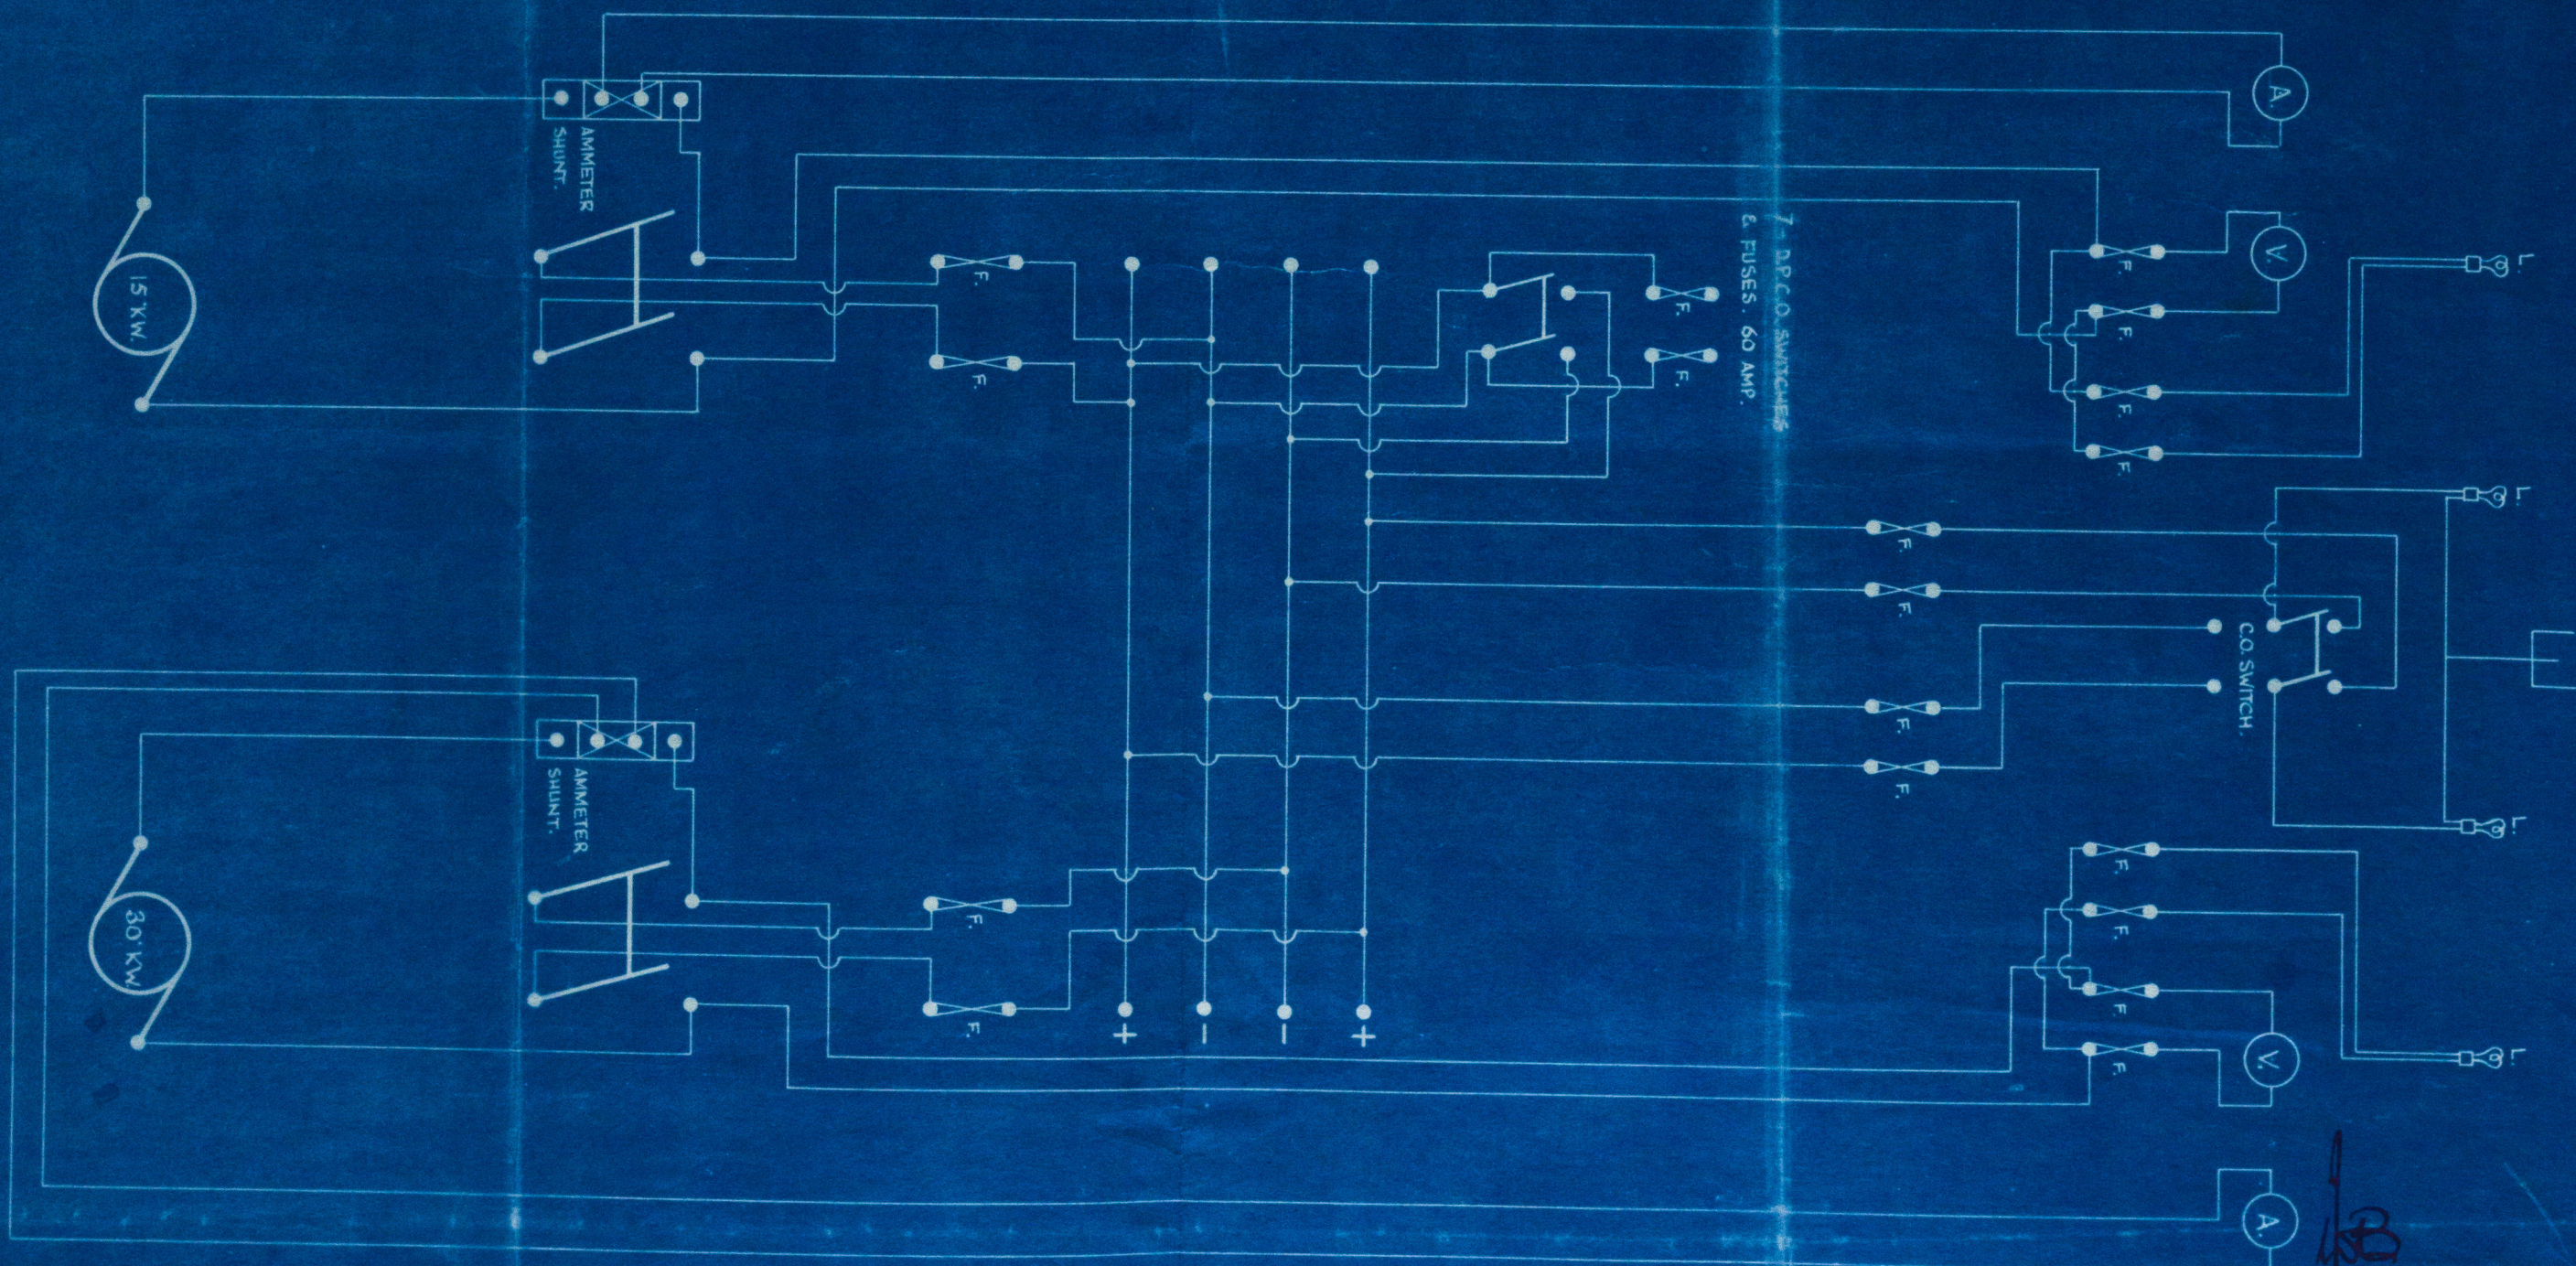

ENGRAVED LABELS TO BE FITTED
 IN ACCORDANCE WITH SEC. 3.

W32-0045

APPROVED BY ELTONS
 LONDON COPY.

W32-0045

LONDON COPY

LONDON COPY.



© 2020

Lloyd's Register
Foundation