


Wallsend Shipway &
Eng Co Ltd.

N^o 236.B.

N^o 237.B. 18 lbs.

N^o 236

N^o 7873
Lloyds Test-
360 lbs
Q.M.K. 20/7/09

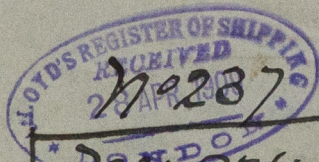

N^o 7874
Lloyds Test-
360 lbs
Q.M.K. 20/7/09

S.S. DALE CASTLE

Newcastle-on-Tyne

REPORT No. 57374

LR

© 2020

Lloyd's Register
Foundation

W321-0105