



22.4.09.


ELEVATION

DIMS 125'-0" BP x 22'-0" x 13'-0" MLD

SCALE 1/4" = 1 FOOT

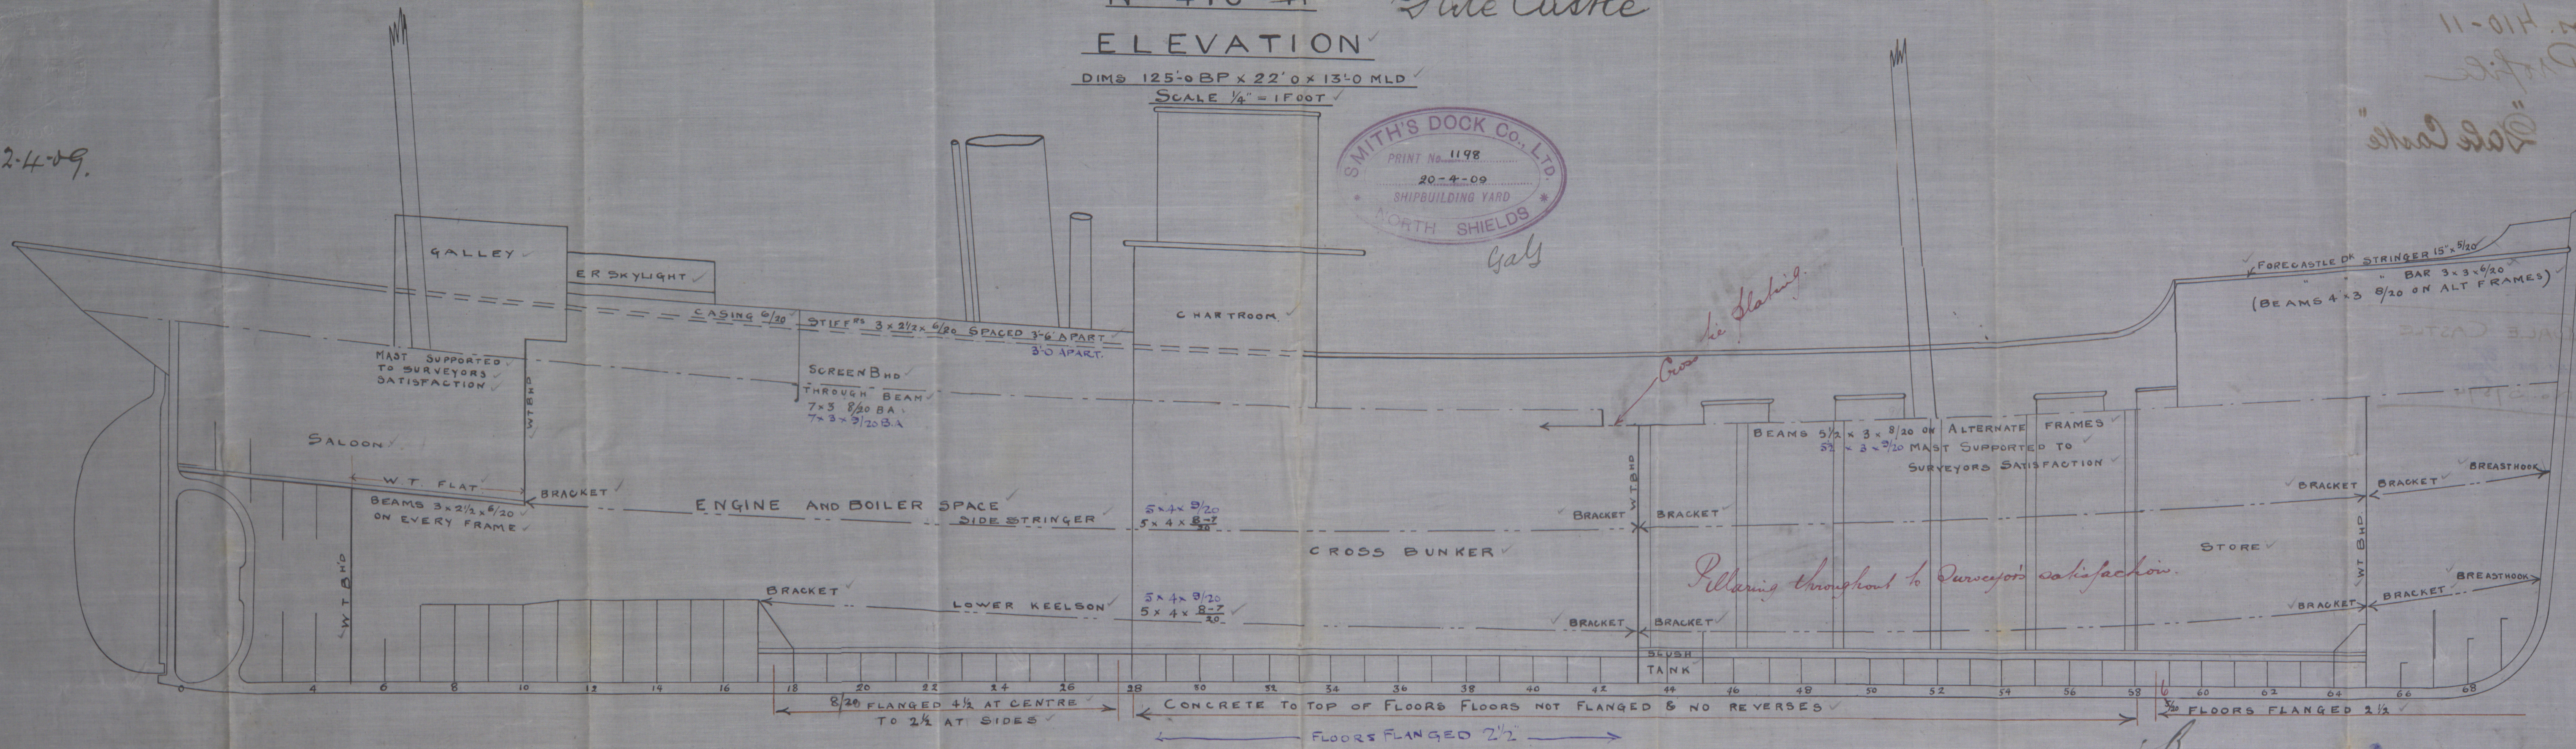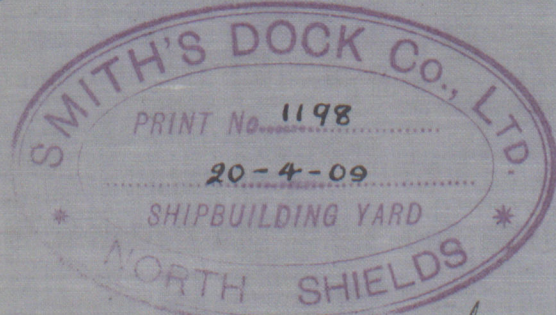

22.4.09.

22.4.09.



Smith's Dock Co's
nos. 410-11
Profile

"Dale Castle"

S. S. T. DALE CASTLE

Newcastle-on-Tyne

REPORT No. 57574

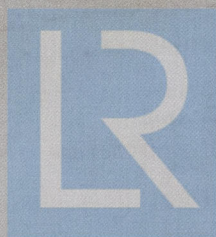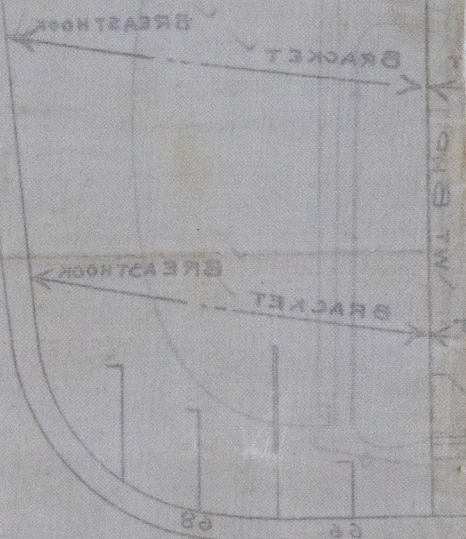

© 2020

Lloyd's Register
Foundation

W321-0107