


180. LBS WORKING PRESSURE 2-OFF

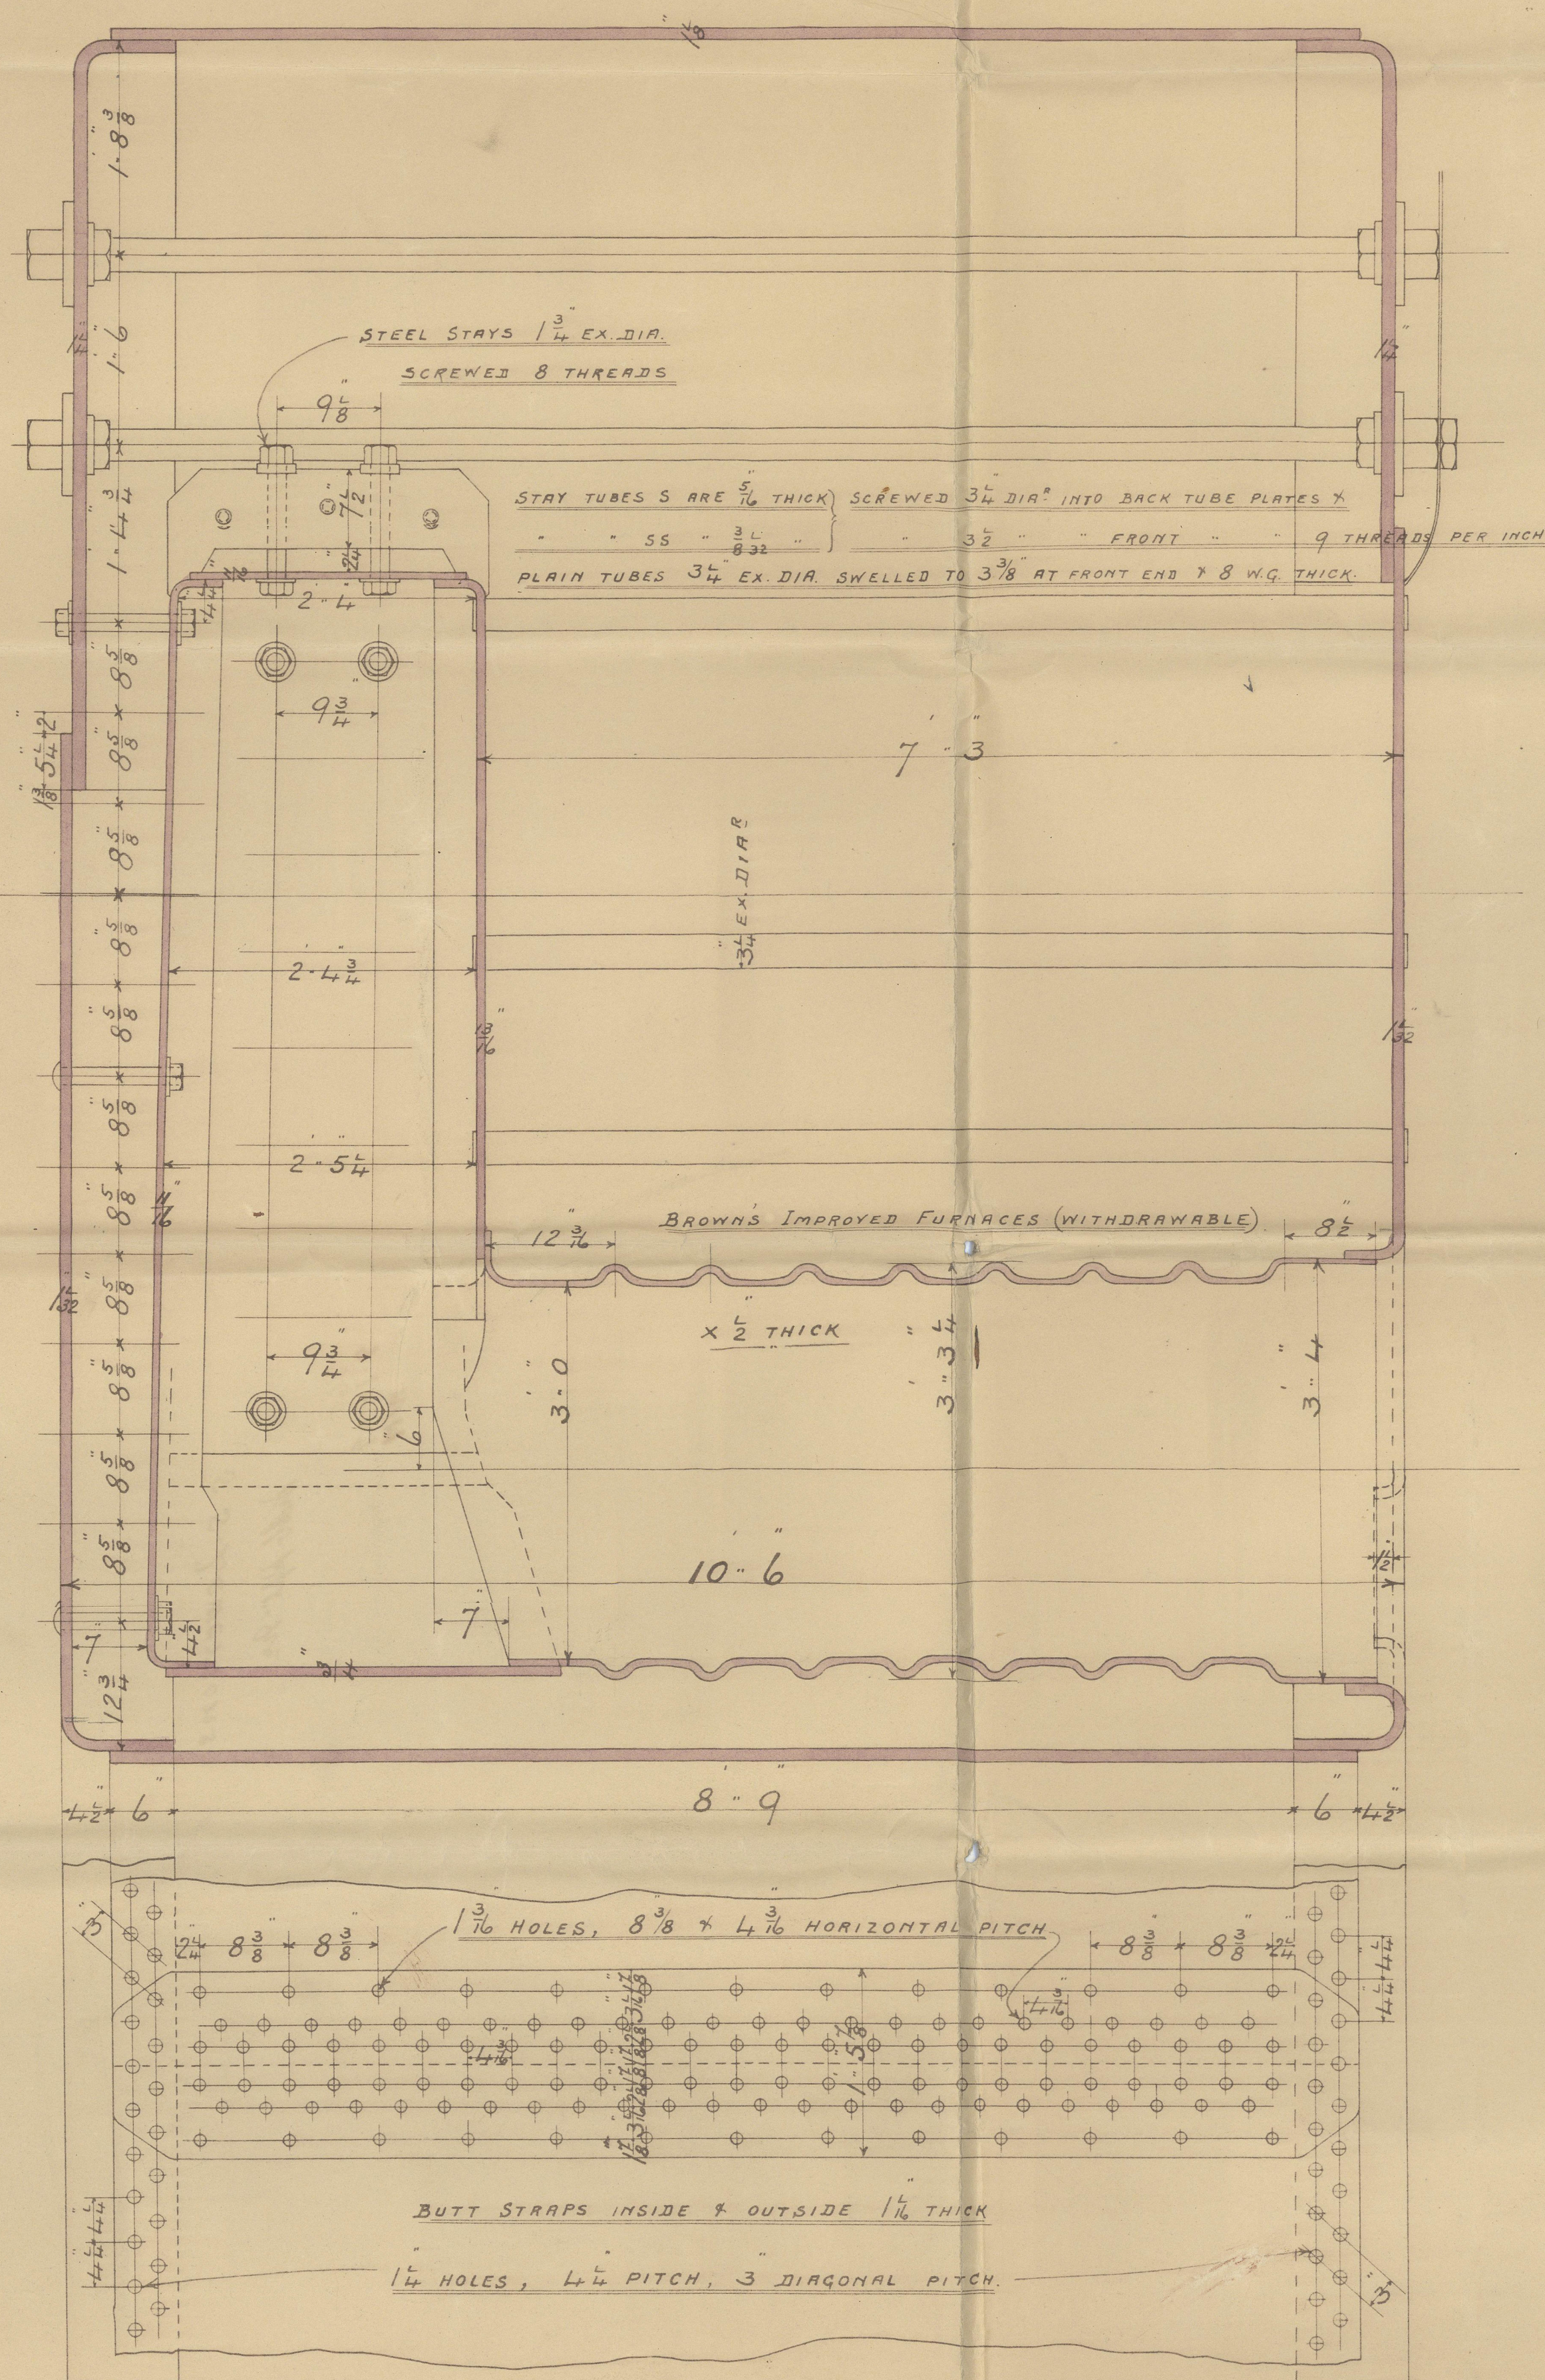

THE MINIMUM TENSILE STRENGTH OF SHELL & GIRDER PLATES IS TAKEN AT 28 TONS. PER SQ. INCH.

B. 1069

(u) 322-0099 1/2

BLAIR & COY., LTD.
ENGINEERS.
7 JUL 09
STOCKTON-ON-TEES.

W322-0039

July 7th 1909

From BLAIR & CO., Ltd.,
STOCKTON-ON-TEES.

To Messrs Lloyds Engineer
Surveyors
Middlesbrough



Boilers
Engines No 1662
B 1069 R Thompson & Son No 1/8

Messrs Blair & Co

Boiler No 1662
for

Messrs R. Thompson & Sons
St. No 256

Working Press 180 lbs

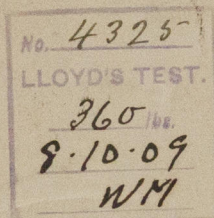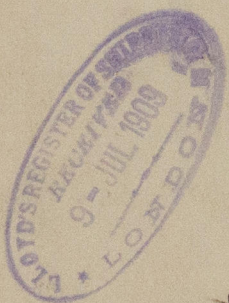

S.S. Leversons

Sub Rpt. No 6004

Sunderland Y.C. Report
no. 24240.



n/u. "Willodale"

W322-0099



© 2020

Lloyd's Register
Foundation