


S.S. N°256.

- SCALE $1/8" = 1 \text{ FT}$

ROBERT THOMPSON & SONS, LTD
Iron and Steel Shipbuilders and


Registers,
SOUTHWICK YARD,
SUNDERLAND.

30-7-09

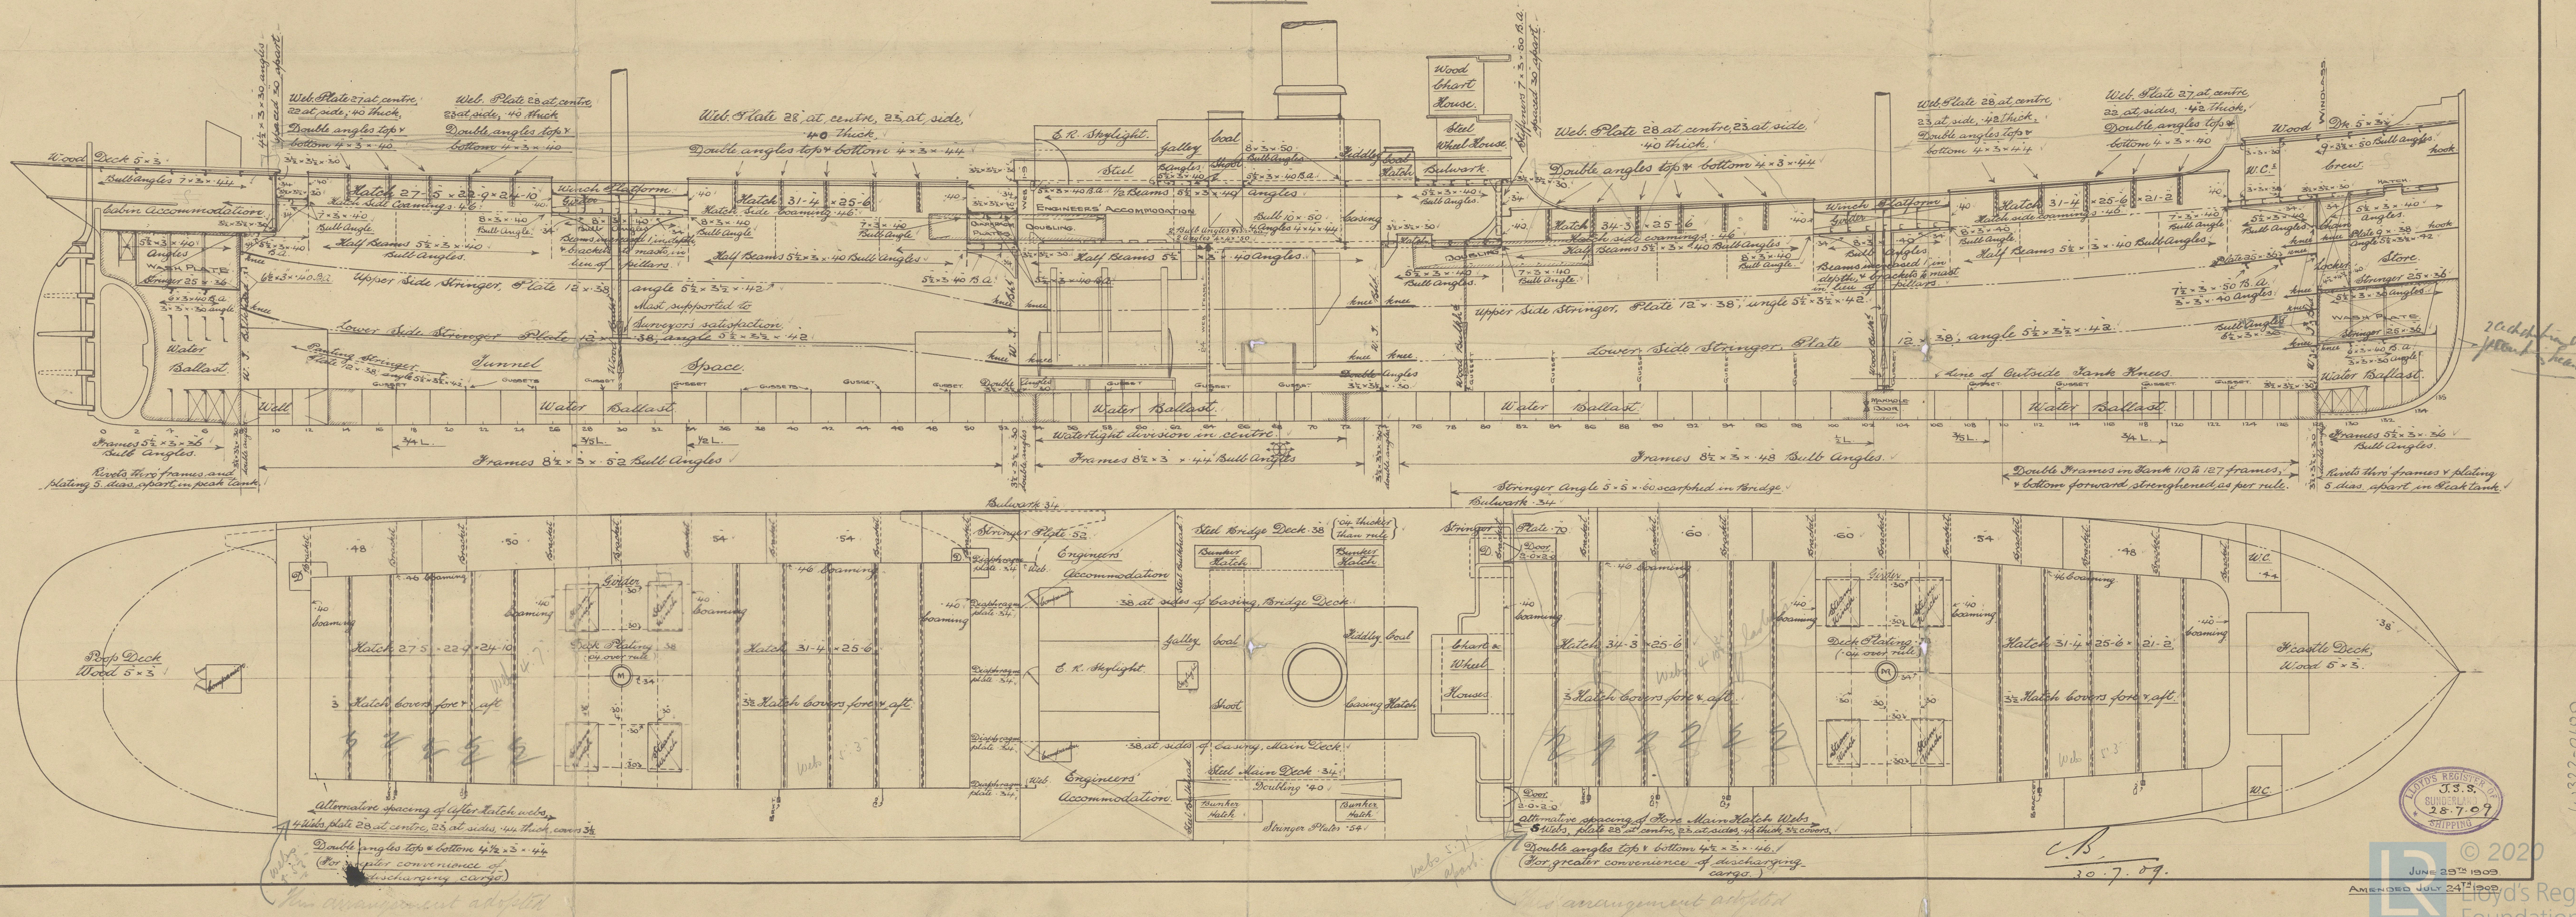

1322-0100

W322 - 0100


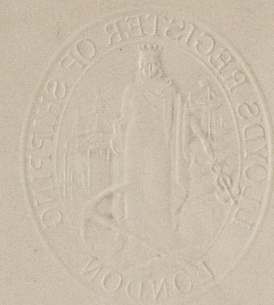


© 2020
Lloyd's Register
Foundation

R Thompson & Sons

No 256

Amended profile
of deck

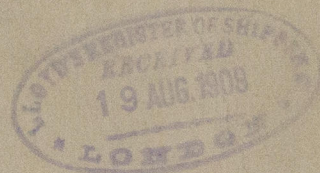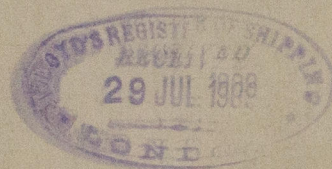


"Leversons"

Sunderland F. E. Report

no. 24240.

✱ n/n "Willordale"

W322-0100

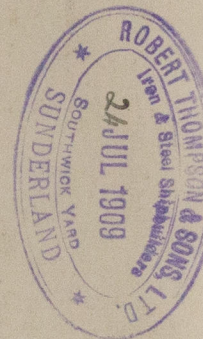

© 2020

Lloyd's Register
Foundation