

Length B. P.-----268'-0"
Beam Extreme-----38'-6"
Beam Moulded-----38'-4"
Depth in Hold to Cellular Bottom 14'-0½"
Depth Moulded to Upper Deck---19'-8"

Boiler Casing Top

ROBERT THOMPSON & SONS, LTD.
Iron and Steel Shipbuilders and
Repairers,
SOUTHWICK YARD,
SUNDERLAND.



Floors to be fitted to each frame in double bottom from $\frac{3}{5}$ Length forward to Collision. etc every 4th frame.


* Boss Plates to be 5/8" thick.
with overlapped Butts triple rivetted.


* Garboard and After Hood plates
connected to stem Frame to be
same thickness as Midship plate of
same stripe.

W.S. 430

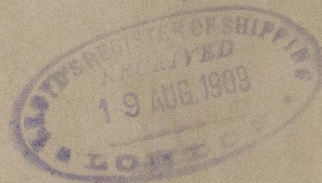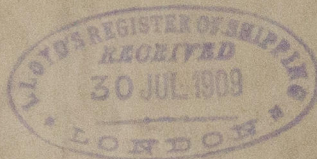

MID. SECTION


Nº 256

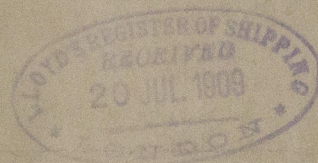

"Leversons"
Sunderland. G. E. Report.

* no. 24240.
n/n. "Willodale".

W322-0101

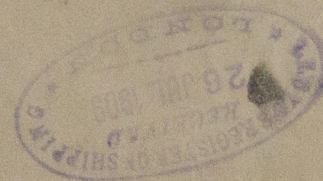

© 2020

Lloyd's Register
Foundation