

14 JUL 1941

Lloyd's Register of Shipping.

(Report on Vessel No. 51570. Port Hull.)No. SHIP FORGINGS OR CASTINGS.

I have to report that the undermentioned ~~Iron or Steel Forgings or Castings~~, manufactured by Messrs J. S. Forester & Son. Ltd. of Sunderland, for the Vessel No. 1238, being built by Messrs Cochrane & Son. Ltd. of Salby, have been inspected by me as set forth below and found to be, so far as can be seen, sound.

Mark on Forgings or Castings.

Lloyd's

No. 5639

A.E.G. 10.7.41

J.E. Galliford

(RUDDER HEAD) Sunderland

STEERN FRAME.

AND RUDDER FRAME.

STEM.


14 JUL 1941

| | | |
|---|-----|--|
| Material* ... | ... | Scrap steel. |
| How made ... | ... | Forged & smithed. |
| If annealed ... | ... | |
| Dimensions ... | ... | HEAD. 8" FRAME. 8x6 1/4" to 4x4 1/4" ✓ |
| Progress on Inspection ... | ... | Forging & smithing. |
| Date when Inspected } ... | ... | 28.4.71 to 10.7.41 |
| CASTINGS. | | |
| Tests on Standard Test Pieces. | | |
| Tensile Test— | | |
| Ultimate Tensile. | | |
| Tons per sq. in. ... | | |
| Yld Point. | | |
| Tons per sq. in. ... | | |
| Extension per cent on inches | | |
| Red. of Area % ... | | |
| Cold Bending Test— | | |
| Angle before fracture | | |
| Drop Test— | | |
| Height from ground .. | | |
| Hammering Test— | | |
| If made according to Rules and found satisfactory ... | | |

SKETCHES OF FRAMES SHOWING POSITION AND DESCRIPTION OF WELDS OF FORGINGS.

59. 0. 0

Return plan

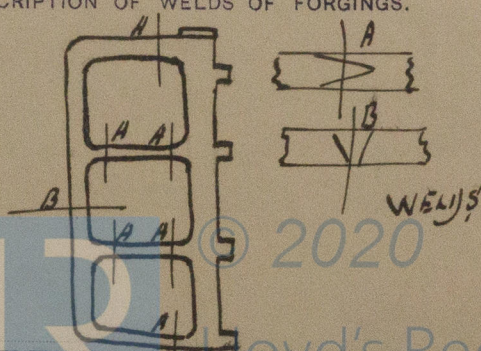

Fee (if any chargeable) £ MONTHLY A/C.

To be paid at

* If of Iron, state whether scrap or puddled Iron. If of Steel, state whether made on the Open Hearth process.