

LIMITS ON DIAMETERS  $\pm \frac{.0000}{.0015}$  UNLESS OTHERWISE STATED.

BALANCE WEIGHTS FITTED ON WEBS MARKED B.W.


CLEARANCES OF '010 ADDED TO WEBS. 25/7/35 SWP.

**RUSSELL, NEWBERRY & CO. LTD.**  
ENGINEERS,  
**ALTRINCHAM.**

ITERATIONS. LIMITS ALONG WERS INCREASED FROM 008 TO 012. 3/5/61

W 322-0171



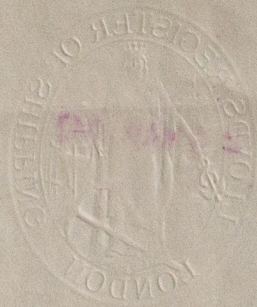

W322-0171

RUSSELL, NEWBERRY & CO. LTD.  
ENGINEERS,  
ALTRINCHAM.



© 2020  
Lloyd's Register  
Foundation