
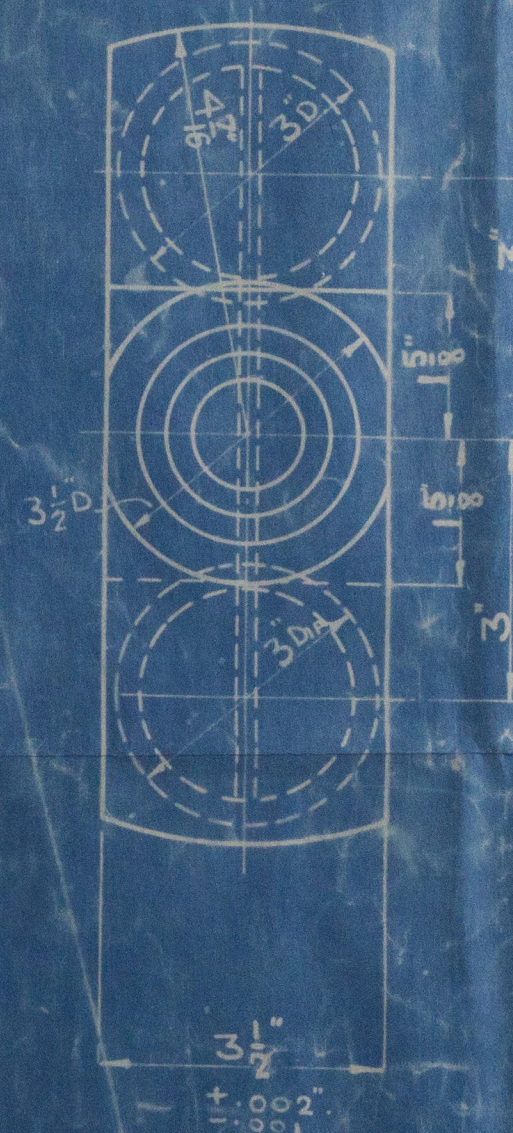


FLYWHEEL KEYWAY.
ALTO. 6/4/34.

SIZES ALTERED 10/11/39. WIDTH OF WEB $3\frac{1}{2}$ TO $3\frac{1}{2}$, RADIUS $4\frac{1}{16}$ TO $4\frac{1}{16}$, FROM BW. FACE TO $1\frac{1}{16}$ TO $1\frac{1}{16}$.

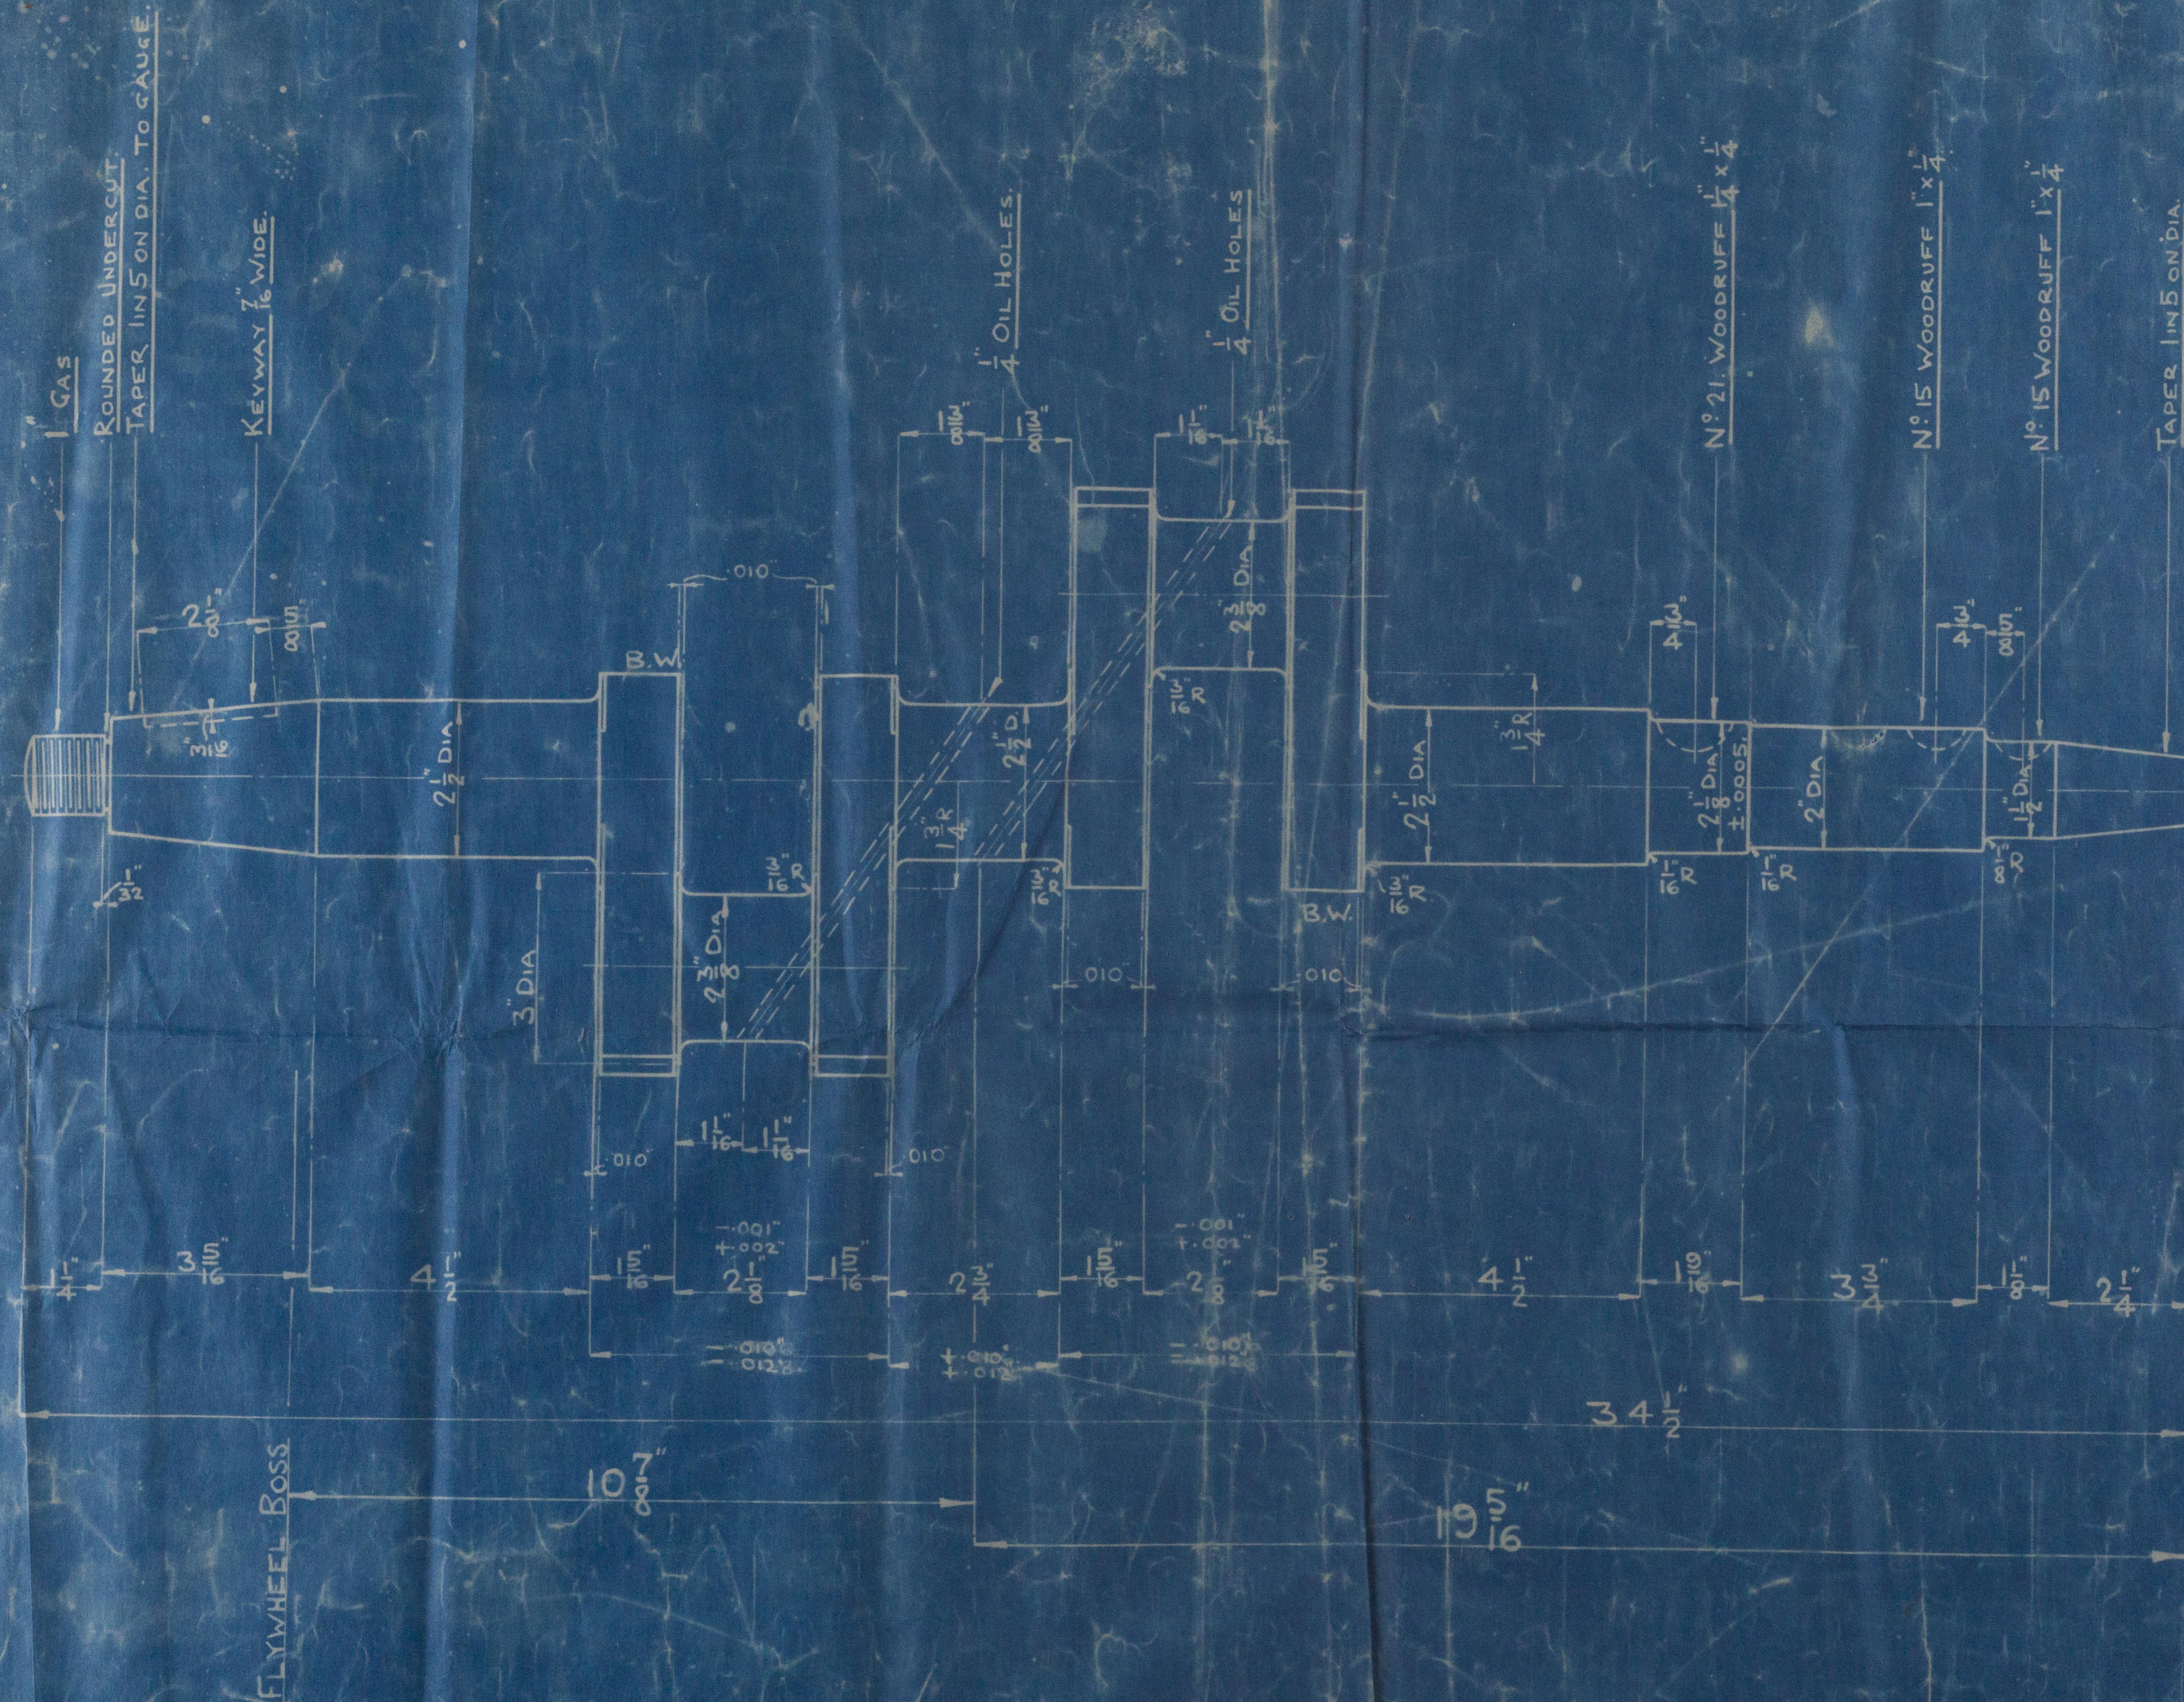

LIMITS ON DIAMETERS ± 0.000 UNLESS OTHERWISE STATED.
BALANCE WEIGHTS FITTED ON WEBS MARKED B.W.
CLEARANCES OF .010 ADDED TO WEBS. 25/35 BW.

RUSSELL, NEWBERRY & CO. LTD.
ENGINEERS,
ALTRINCHAM.

CRANKSHAFT STATIONARY CRANKSHAFT
DRAWN BY
PASSED BY
DATE
21/3/42

W322-0173



RUSSELL, NEWBERRY & CO. LTD.
ENGINEERS,
ALTRINCHAM.

Russell Newberry & Co. Engines Nos. 3729 + 3730.
C.D. HOLMES Yard No. 1627 - J. 2523.
MANCHESTER Report No. 11,287.

W322-0173



© 2020

Lloyd's Register
Foundation