



PROPOSED LENGTHENING 21'-1".
 MV "ABILITY" AND "AMENITY"
 "PROFILE AND DECKS"

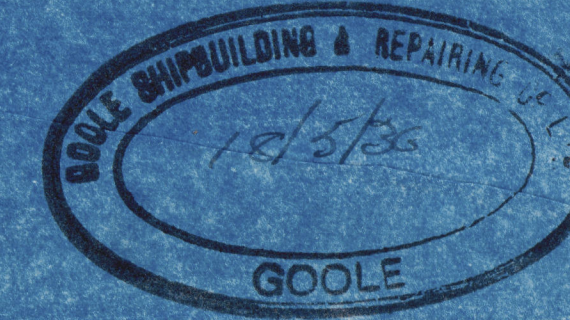


PRESENT DIMENSIONS 115'-0" x 23'-0" x 9'-6"

PROPOSED DIMENSIONS 136'-1" x 23'-0" x 9'-6"

SCALE 1/4" = 1 FOOT

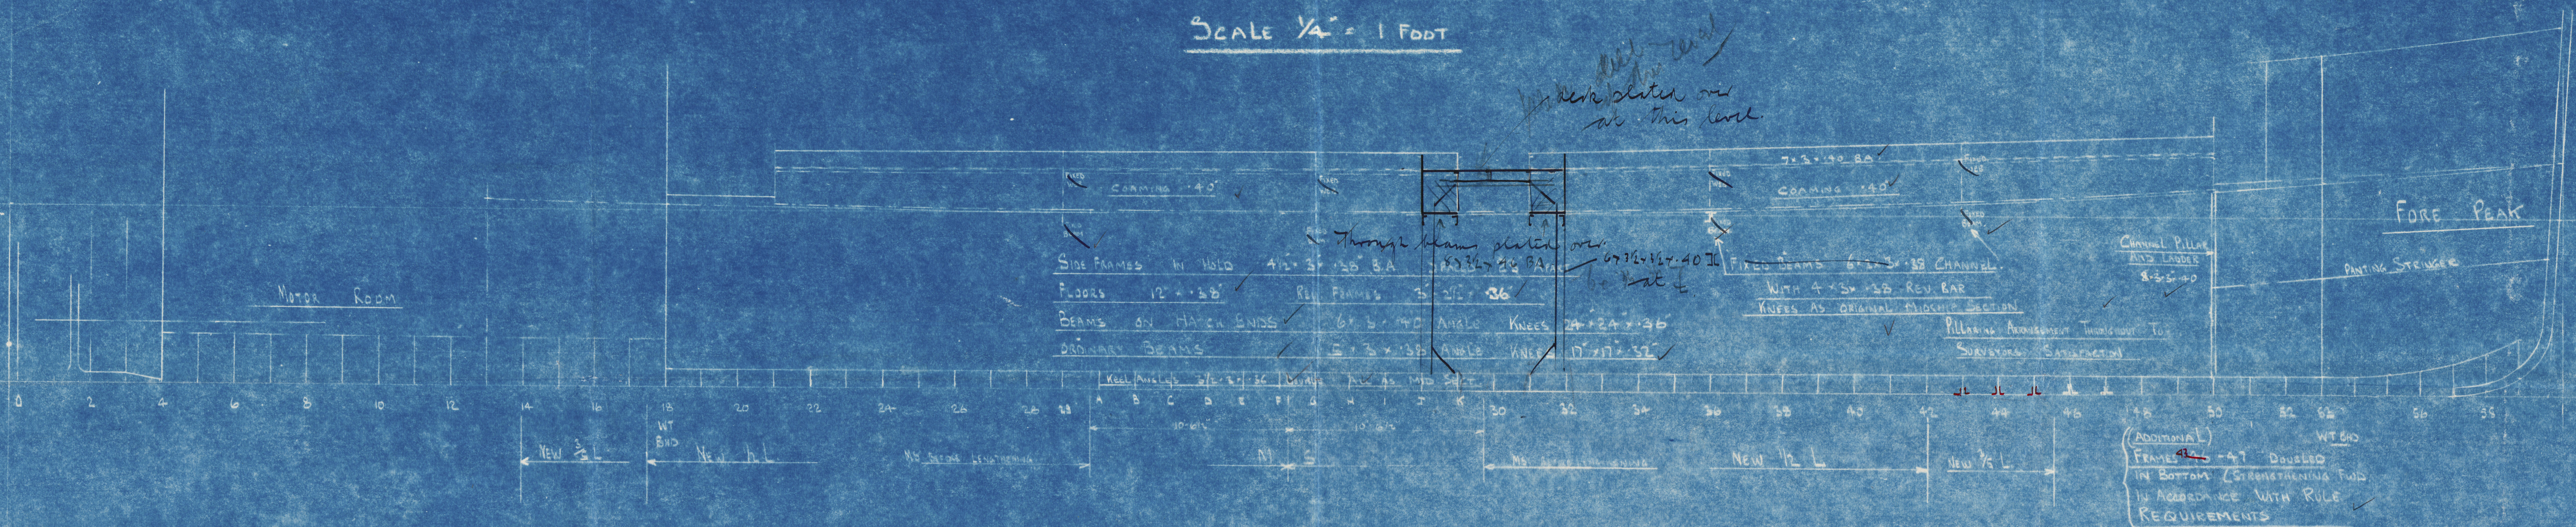

SHELL PLATING 1/2" THICK

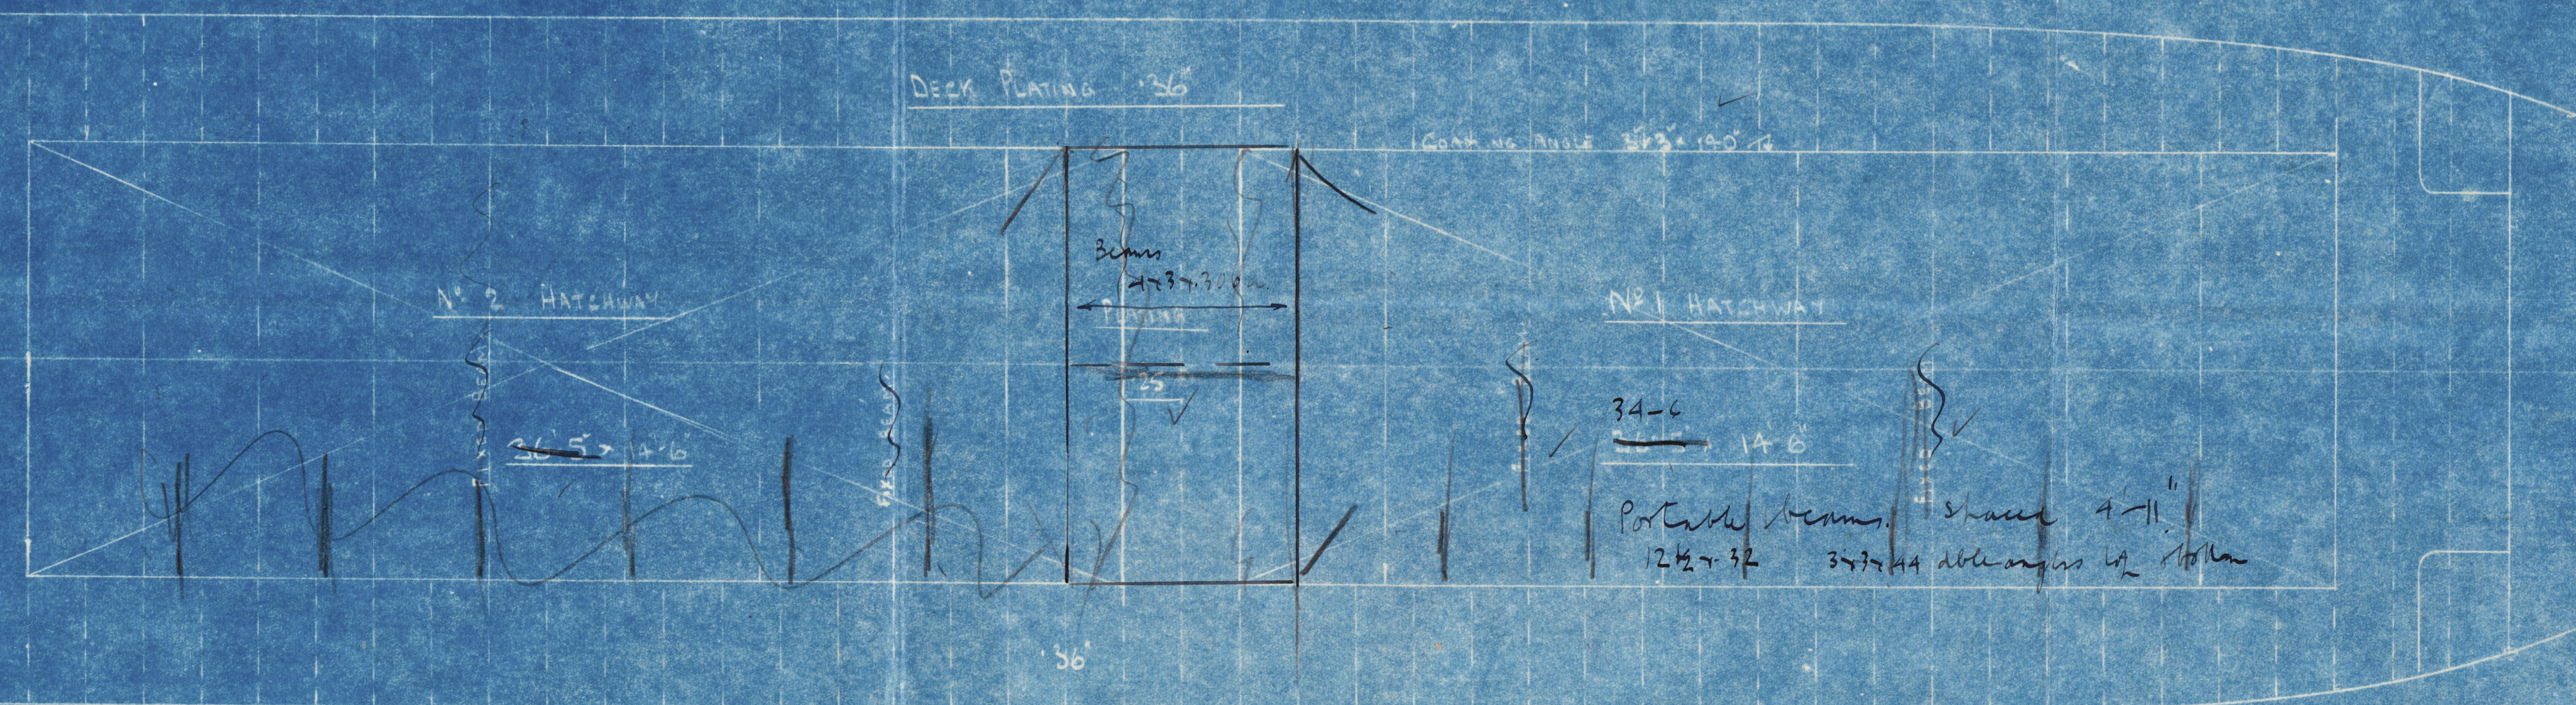

PLAN N° 2099.

PRINT N° 6954

GOOLE SHIPBUILDING & REPAIRING CO LTD
 GOOLE

18.5.36



© 2010
 Lloyd's Register
 Foundation
 W326-0137

HULL

"Ability" & "Amenity"

Proposed alterations

Profile & Deck

File with

M.V. "Amenity"

Hull repl.

No. 47102

M.V. "Ability"

Hull repl. No. 47979

W326-0137

3/20/78



© 2020

Lloyd's Register
Foundation