




© 2020

Lloyd's Register
Foundation

"Amenity"
Alteration to Engine
Seating. (approx)

W326-0138

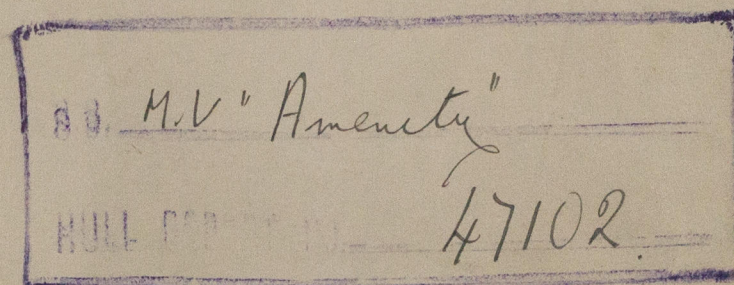

M.V. "Amenity"
New Engine Seating

To be returned to London Office.



© 2020

Lloyd's Register
Foundation