

Lloyd's Register of Shipping.

(Report on Vessel No. _____)

Port

London

No.

SHIP FORGINGS OR CASTINGS.

I have to report that the undermentioned Iron or Steel Forgings or Castings, manufactured by *J. S. Forster & Co. L^{td}* of *Sunderland*, for the Vessel No. *320*, being built by *Hellou & Co. L^{td}* of *Great Yarmouth* have been inspected by me as set forth below and found to be, so far as can be seen, *Sound*.

** M.V. "AMENITY"*

on Forgings or Castings.

Lloyd's

No. *4331*

D. D. Williamson



15-2-27

Sunderland, 15-2-27



	STERN FRAME.	RUDDER FRAME.	STEM.
Material	<i>Scrap Iron</i>		
How made	<i>Forged</i>		
Dimensions	<i>5 1/2" x 2 3/4" + 5 1/4" x 2 3/4"</i>		
Process on Inspection	<i>Forged & Finished</i>		
When Inspected	<i>16-12-26 to 15-2-27</i>		
Tests on Standard Test Pieces.			
Weld Test—			
Strength per square inch			
Elongation per cent.			
Bending Test—			
Angle before fracture			
Weld Test—			
Height from ground			
Welding Test—			
made according to Rules (and found satisfactory ...)			

SKETCHES OF FRAMES SHOWING POSITION AND DESCRIPTION OF WELDS OF FORGINGS.

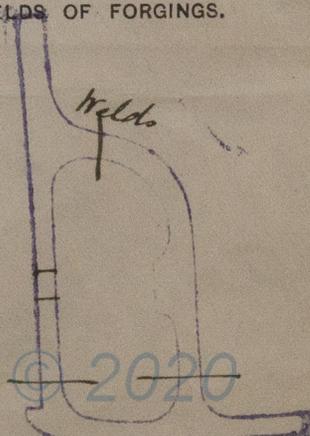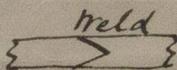


Fee (if any chargeable) £ : :

To be paid at

If of Iron, state whether scrap or puddled Iron. If of Steel, state whether made on the Open Hearth process.

† State if annealed

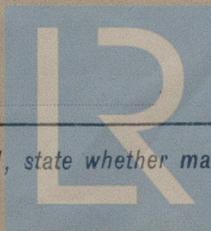

© 2020

Lloyd's Register Foundation

W326-0146