
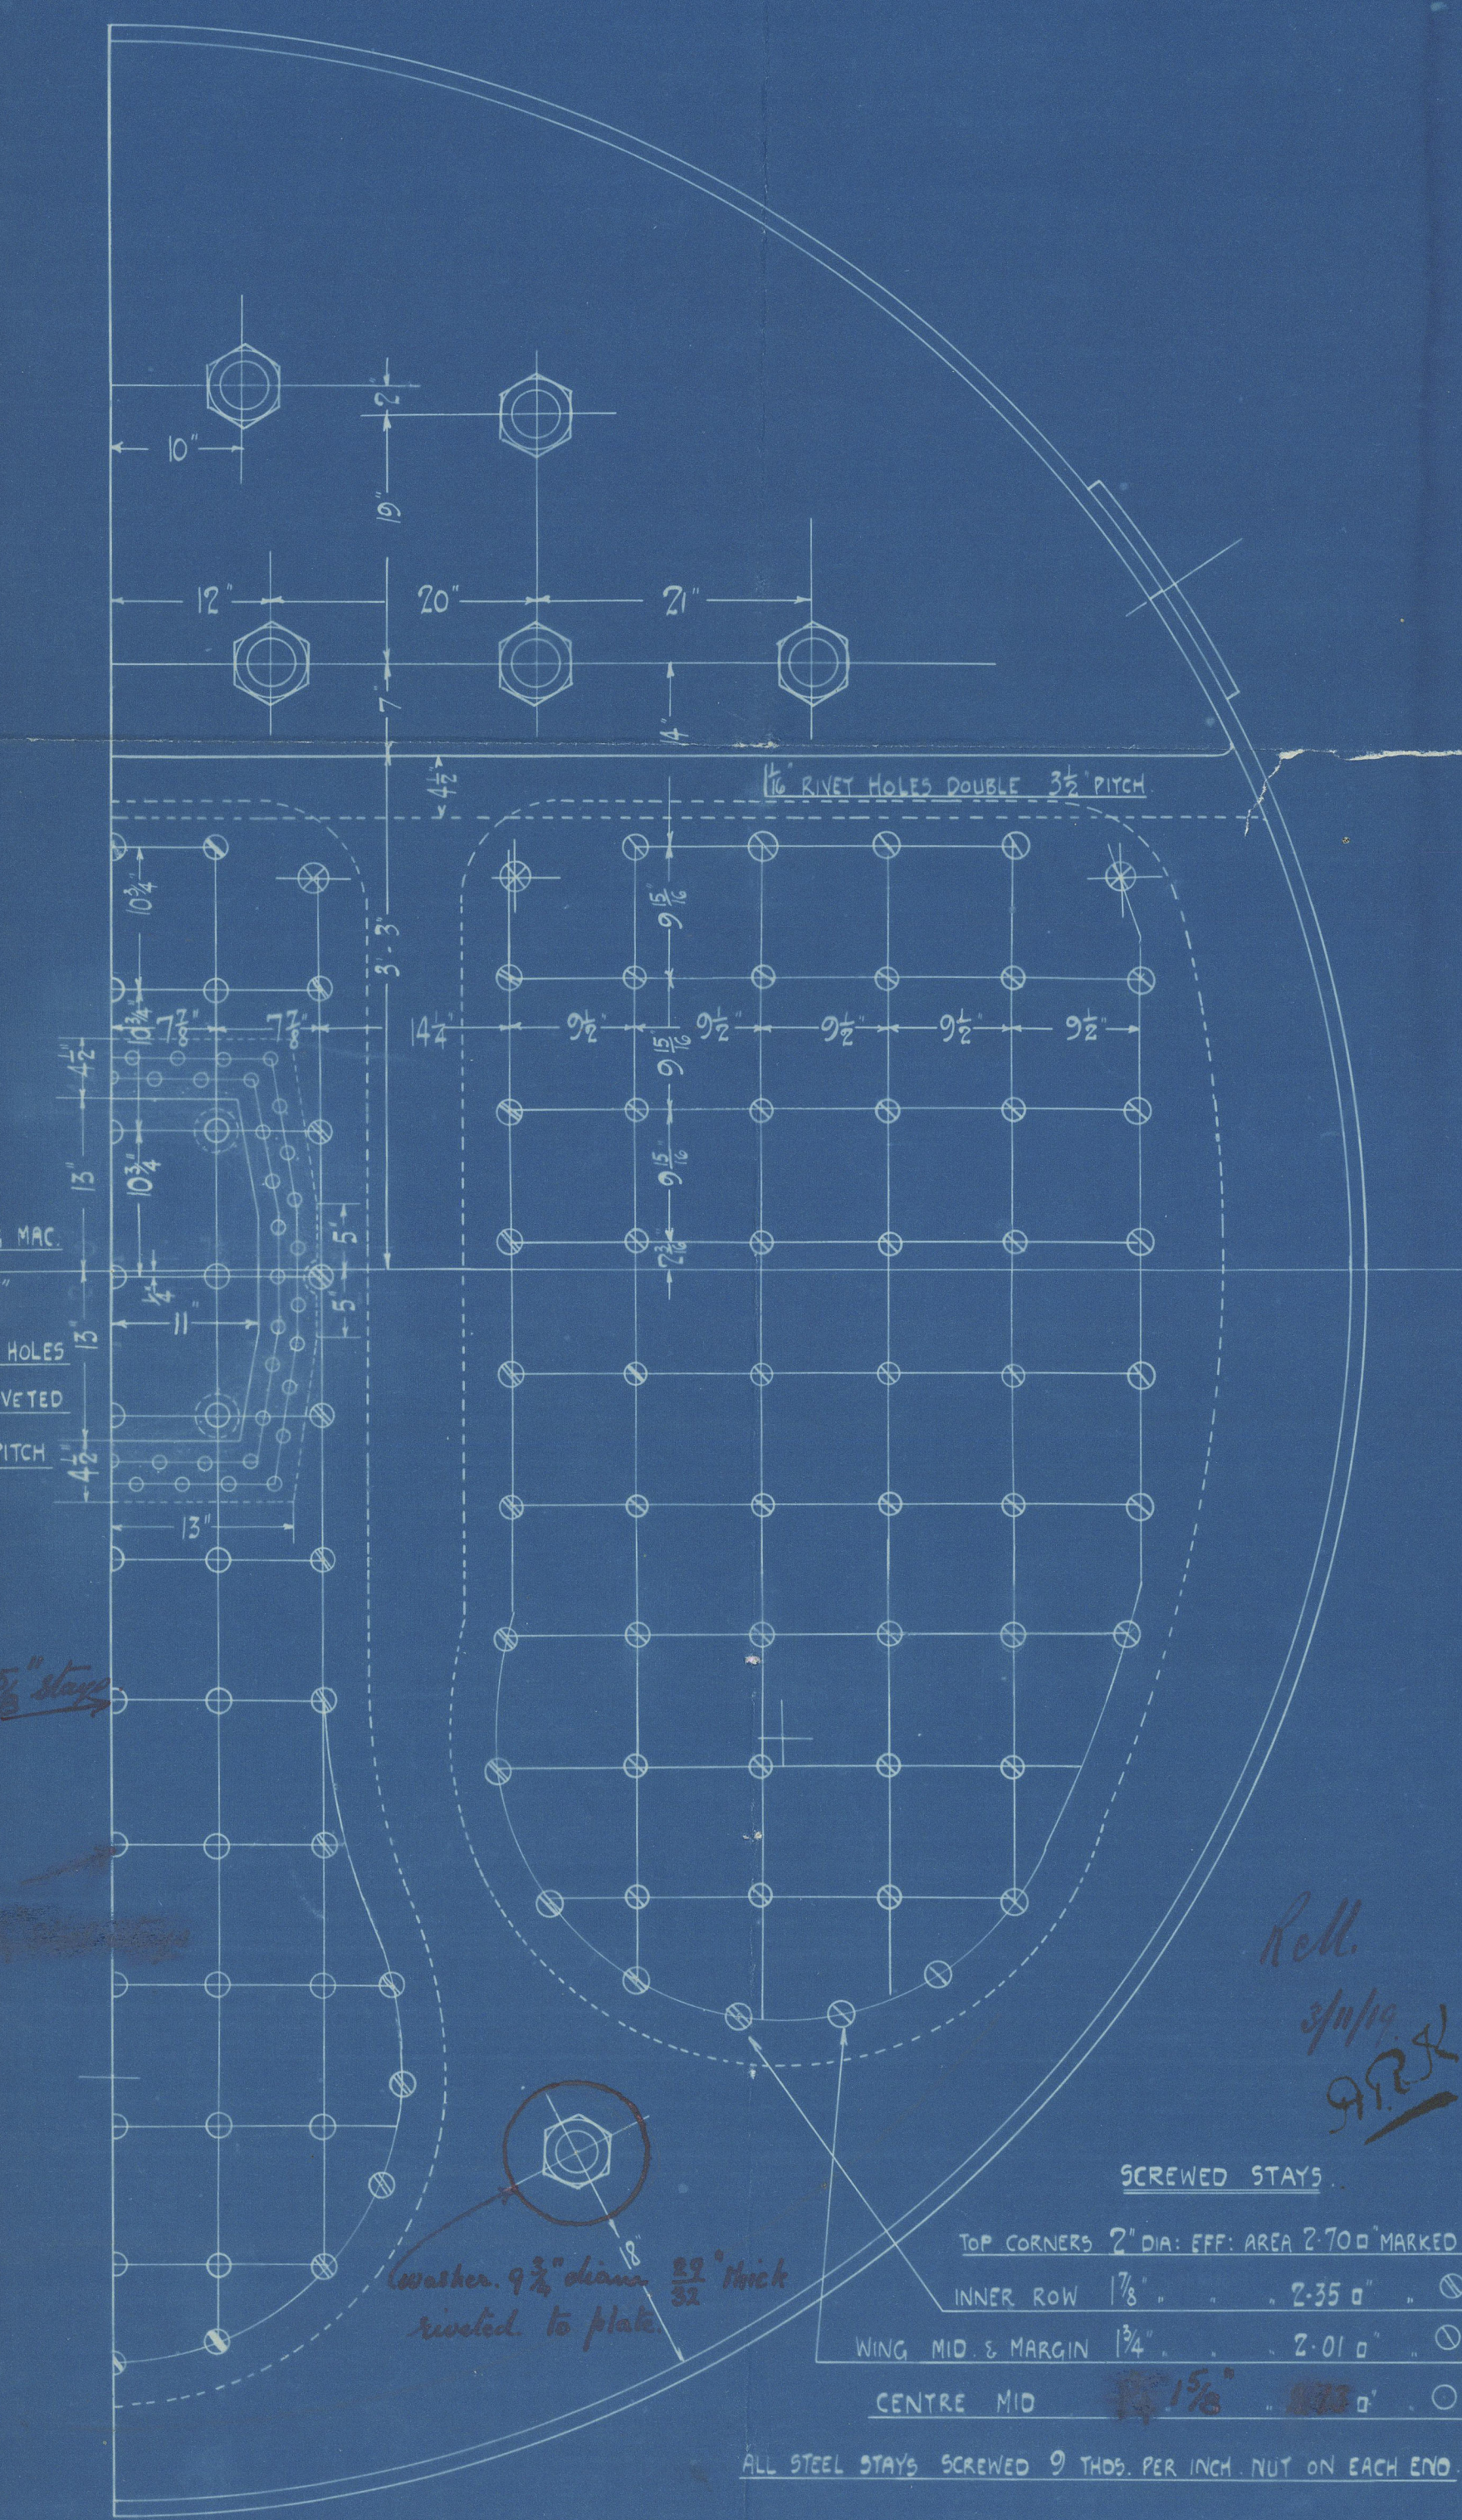
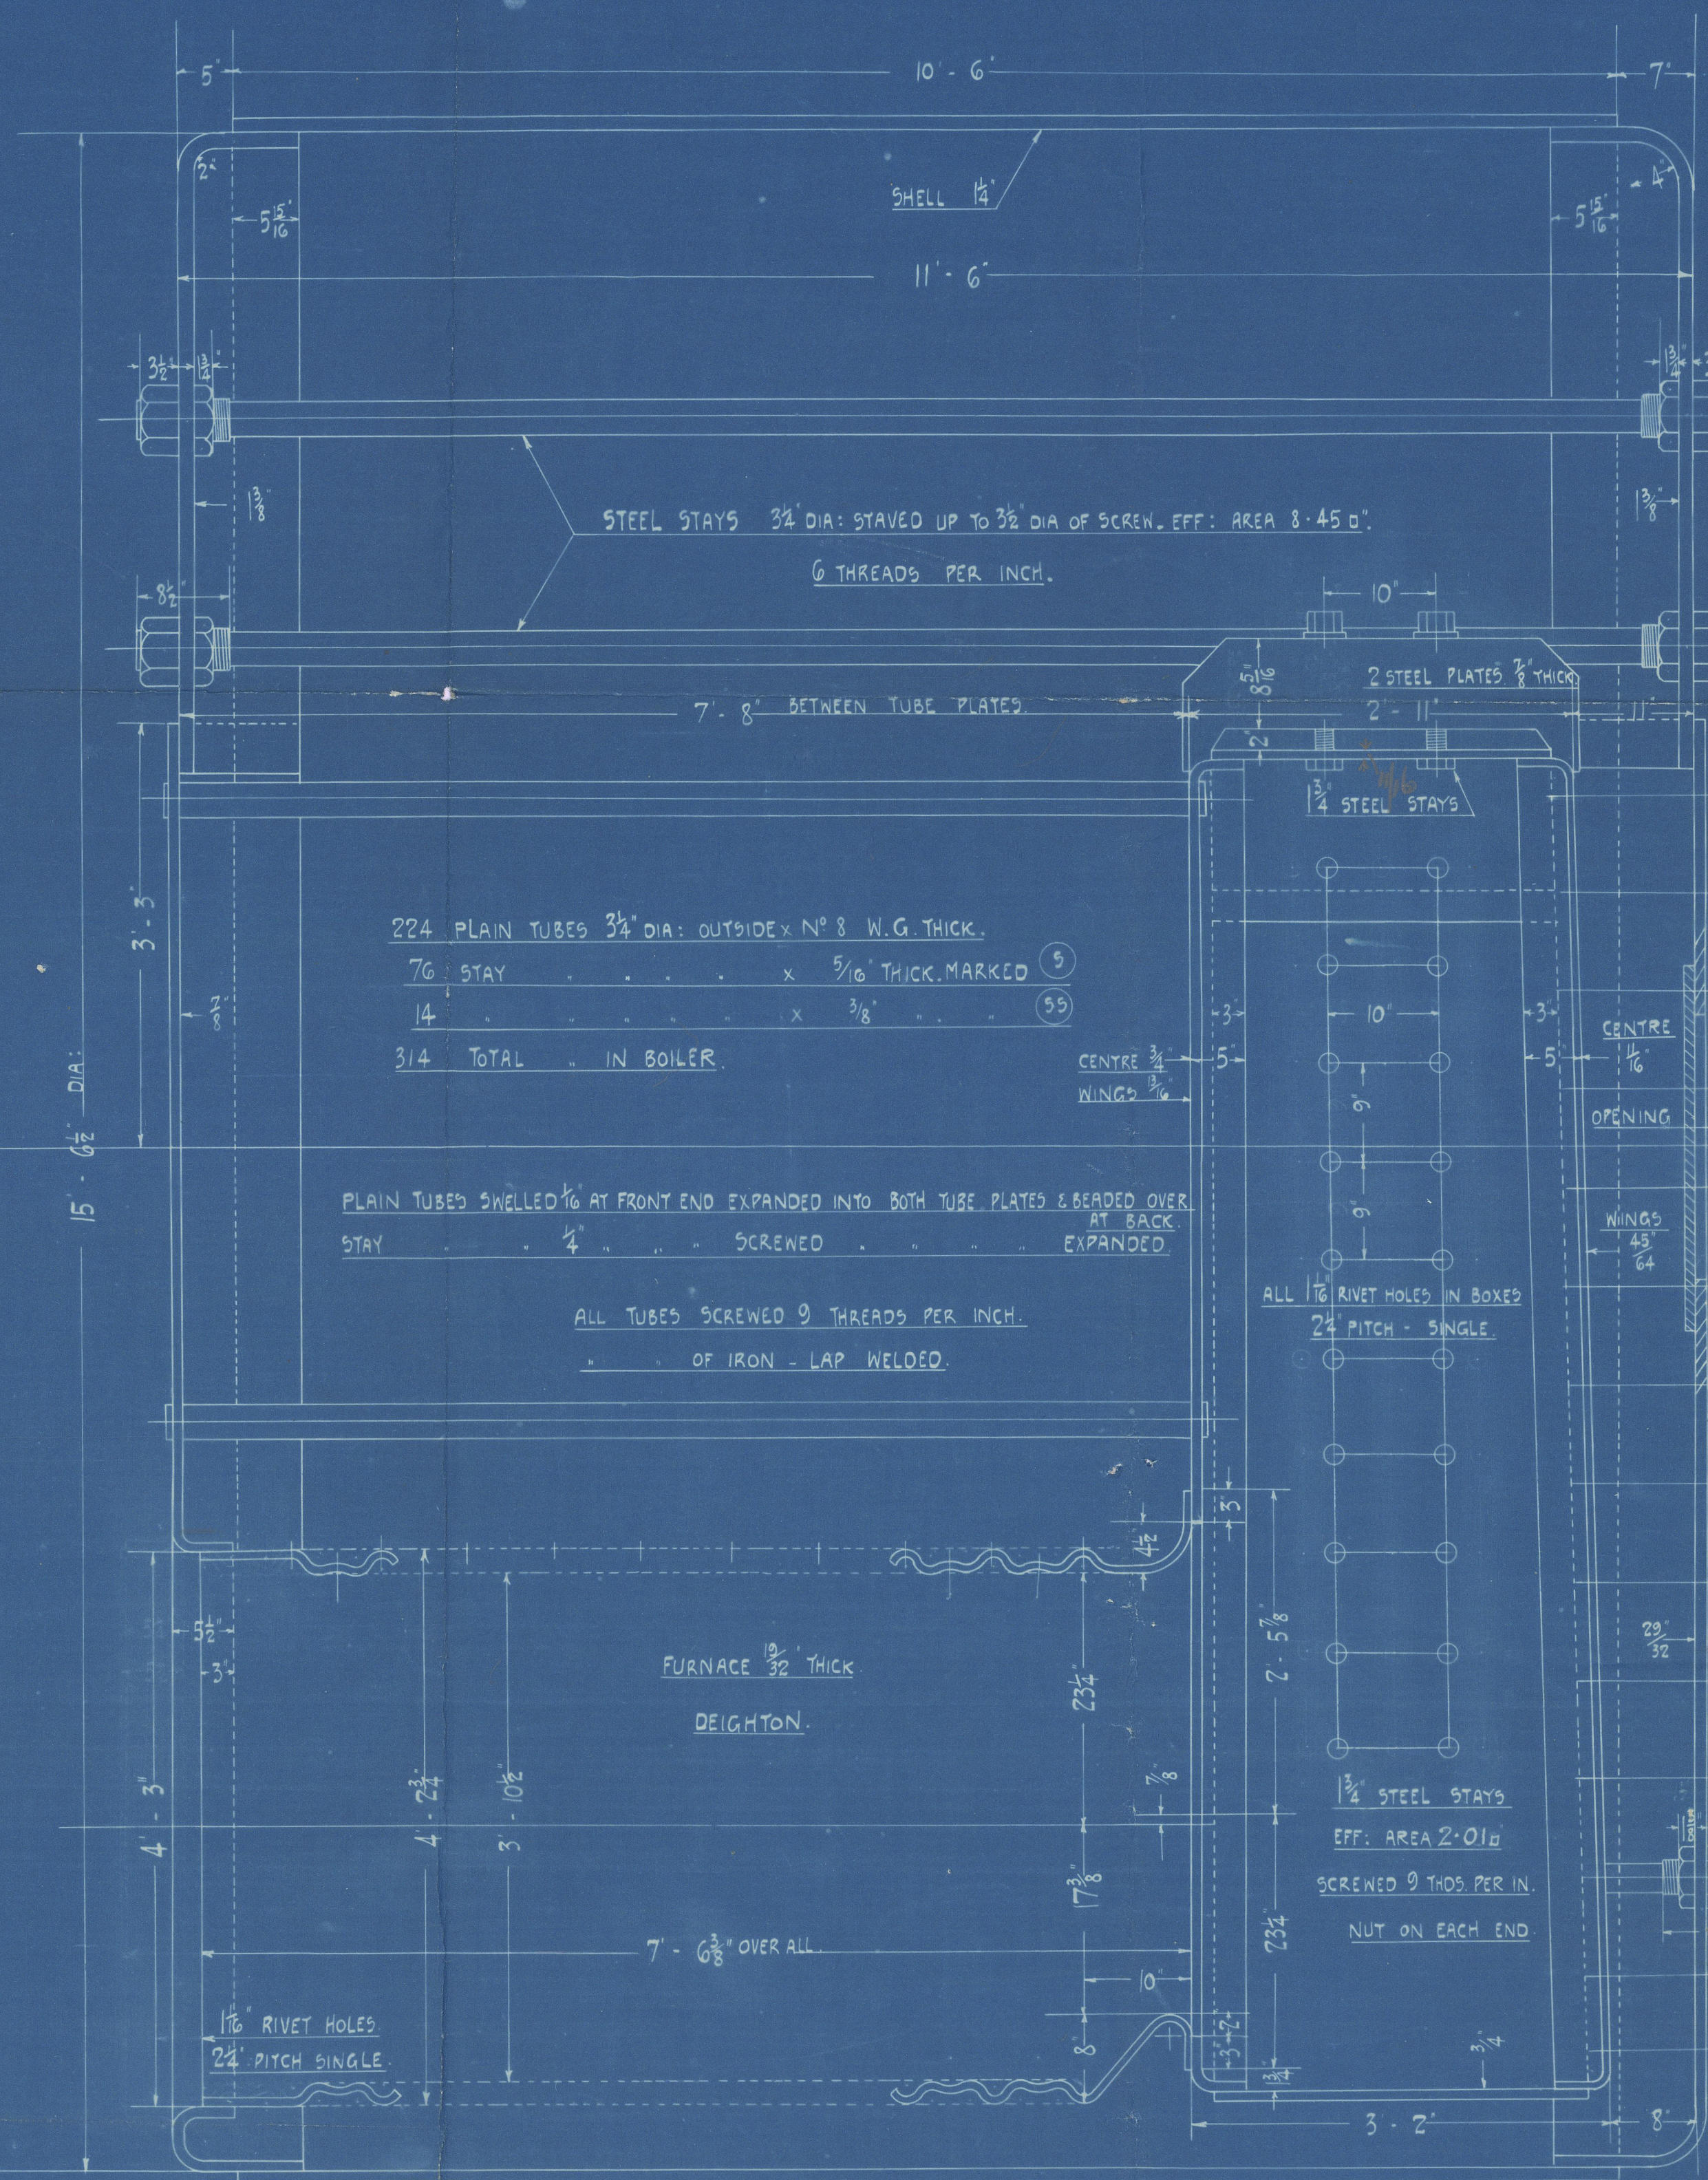


HEATING SURFACE	
TUBES	2043.5
COMBUSTION CHAMBERS TOP & SIDES	162.0
BACKS	86.0
BACK TUBE PLATED	47.0
FURNACES	172.5
ONE BOILER	2517.0
HEATING SURFACE IN THREE BOILERS	7551
GRATE	201
ONE	67.0
LENGTH OF FIREBARS	5.9
RATIO GRATE & HEATING SURFACE	37.56
WEIGHT ONE BOILER	
WATER IN ONE BOILER	

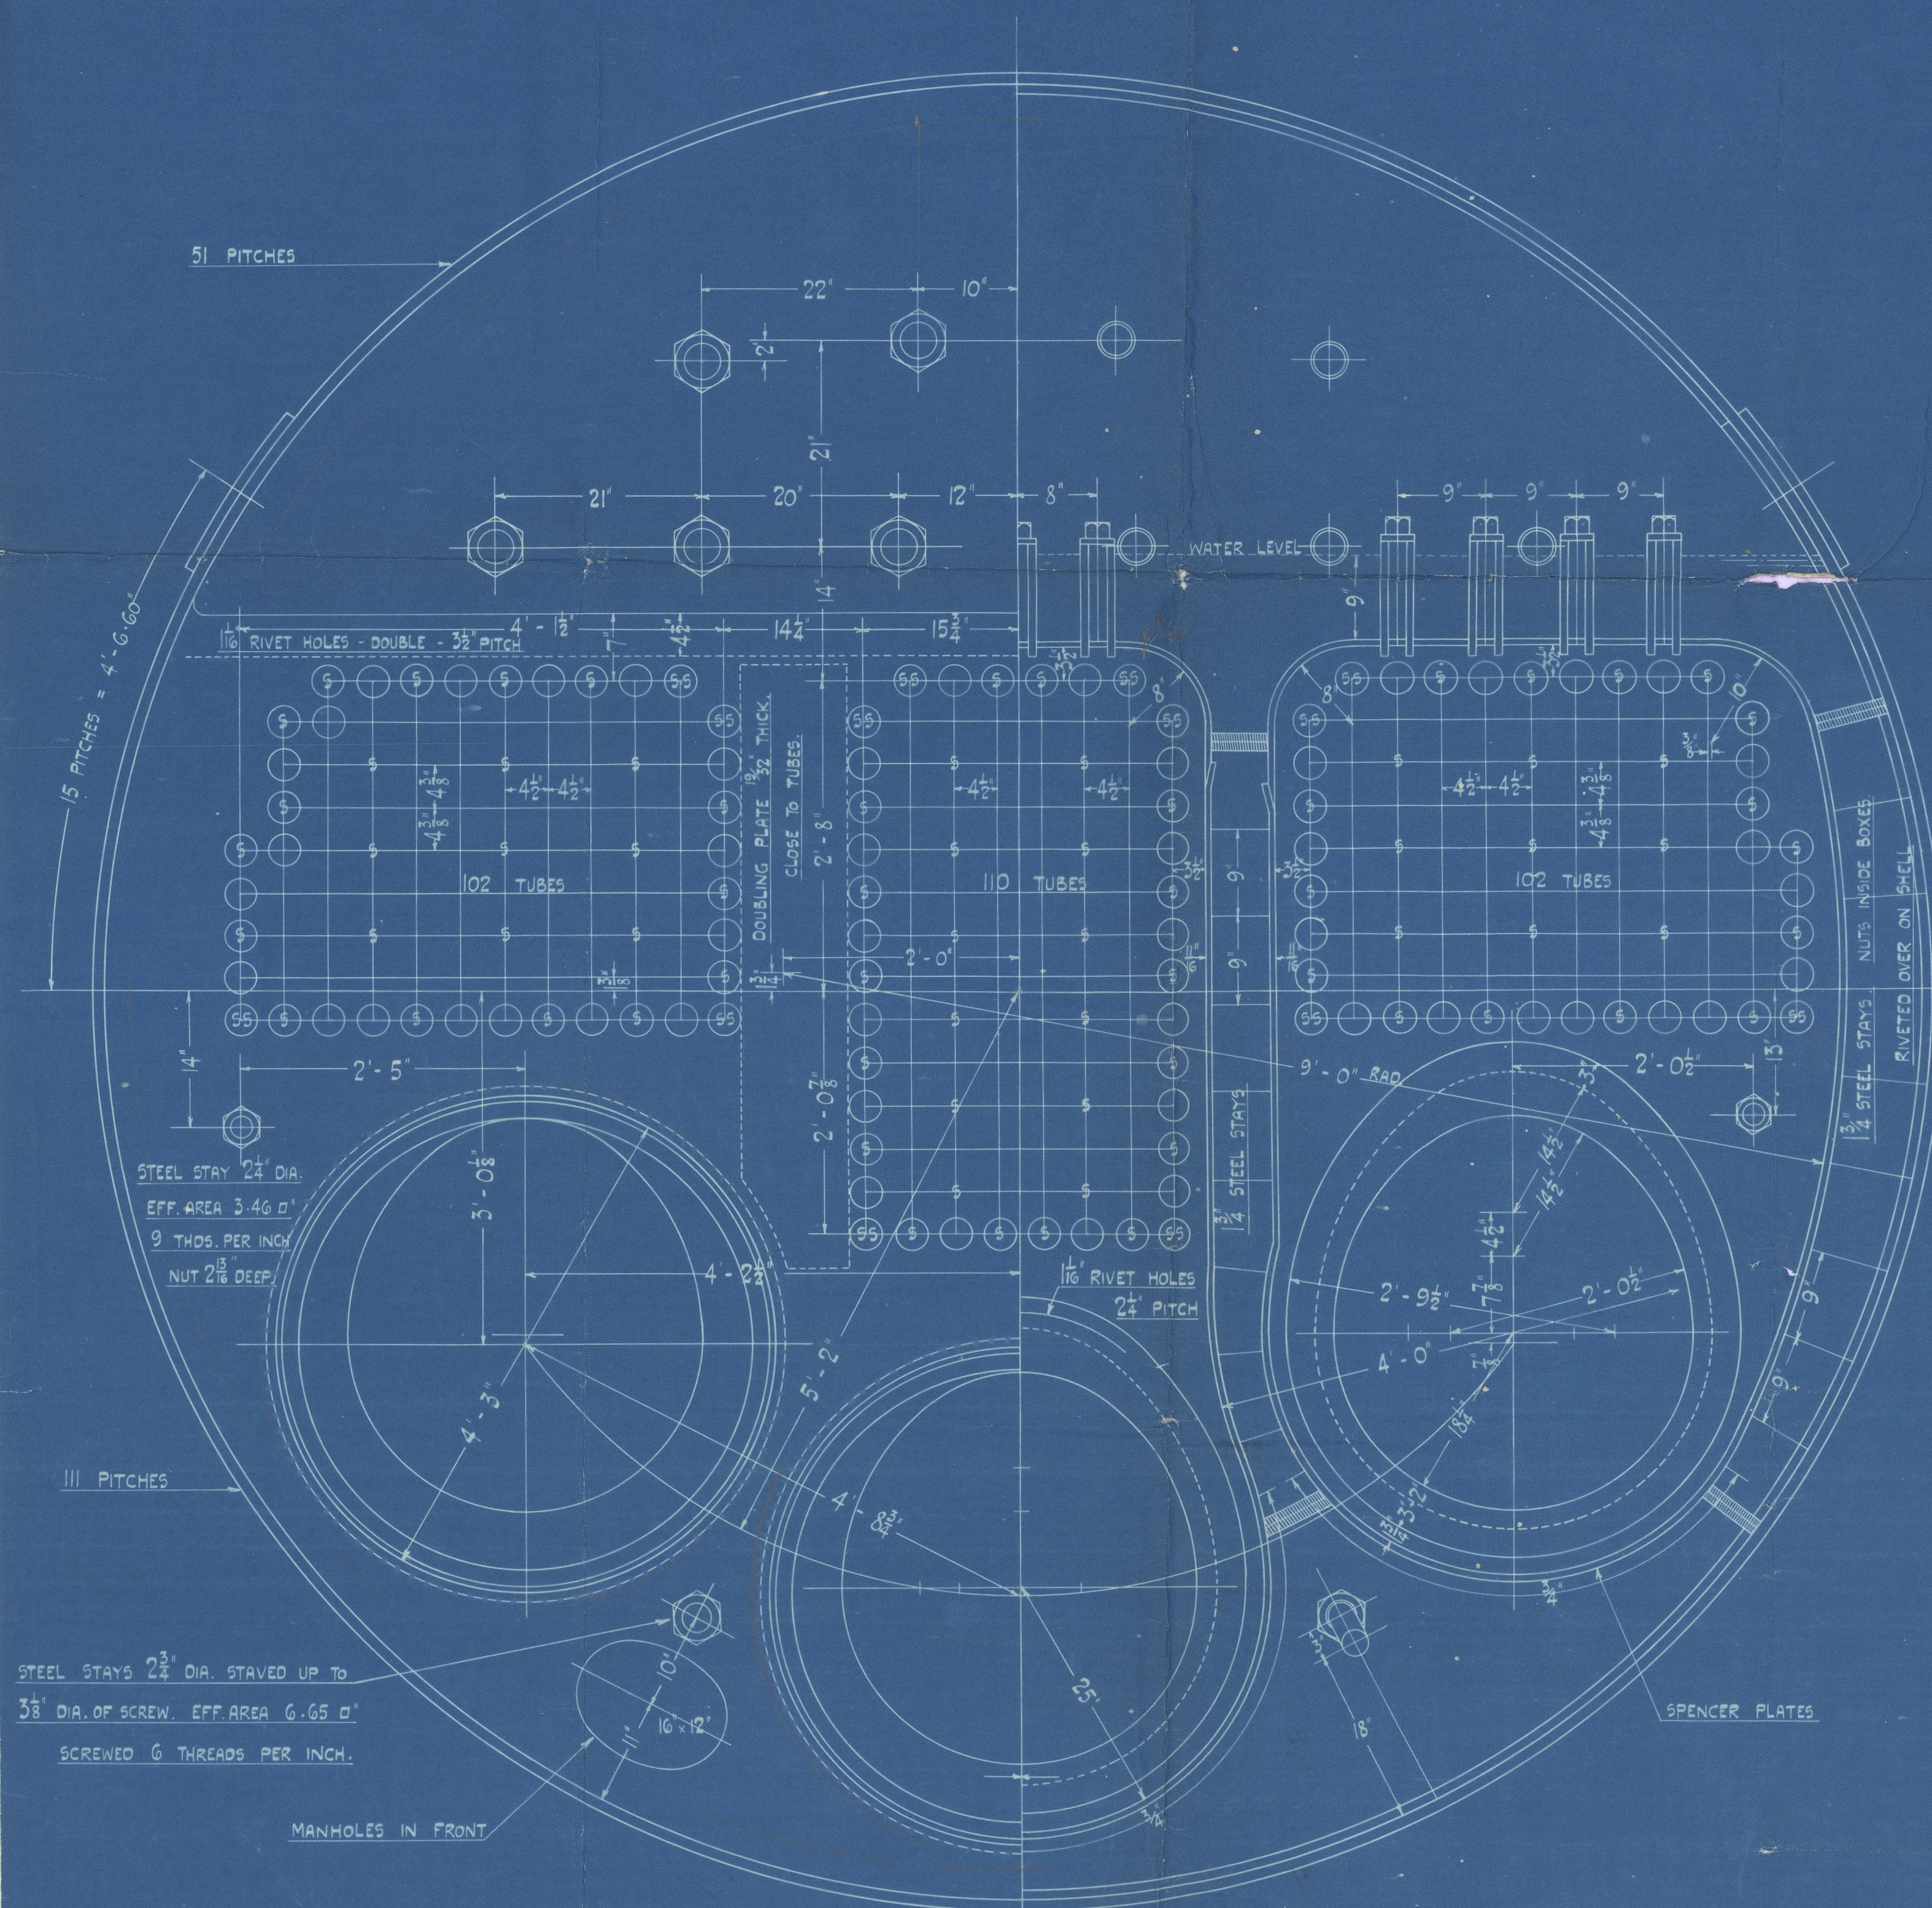

WORKING PRESSURE 180 LBS. PER SQ. INCH.
TEST 360
TO LLOYD'S RULES

THREE BOILERS FOR EACH NO.

BOILERS FOR MESSRS McKie & Baxter.

NO 982-3-6

SCALE: ONE INCH = ONE FOOT

W332-0128

Lloyd's Register Foundation

£15-1-0

A. Stephens Sons.

Boilers nos 982-983
986-987.

For McKie & Baxter.

180 lbs Pressure

Boilers nos 982 -

NO 15648
LLOYDS TEST
320 LBS
W.P. 180 LBS
27-12-20
J.E.S.

Boilers nos 983

NO 16016
LLOYDS TEST
320 LBS
W.P. 180 LBS
22-2-22. J.E.S.

10ff

NO 16017
LLOYDS TEST
320 LBS
W.P. 180 LBS
29-2-22
J.E.S.

20ff

GLASGOW REPORT No. 41766.



Lloyds.

W332-0128



© 2019

Lloyd's Register
Foundation