


Revised tank  
4/10/10


PROFILE & DECK PLANS.  
LENGTH BP 331'-6" x 44'-6" x 25'-6" DEPTH MOULDED  
1/8" SCALE

SHERWOOD SYSTEM (PATENT)

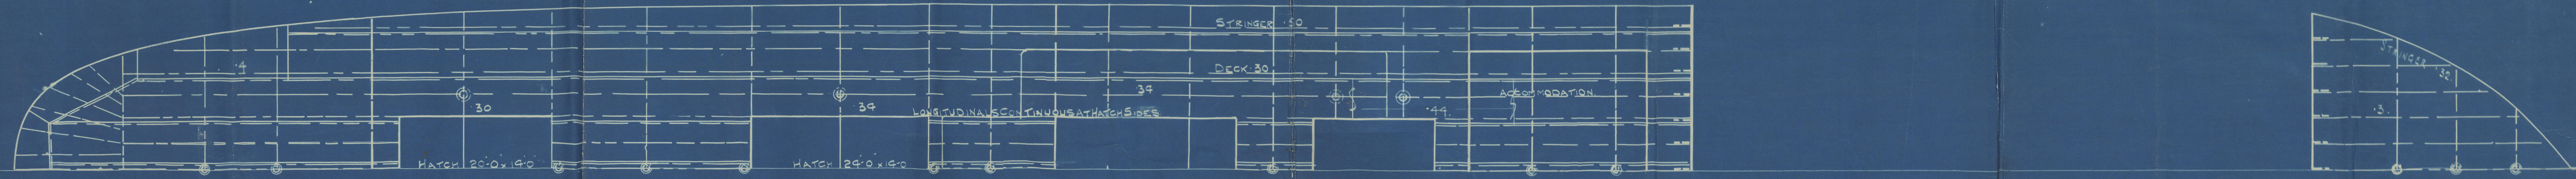

POOP DECK

FORECASTLE DECK

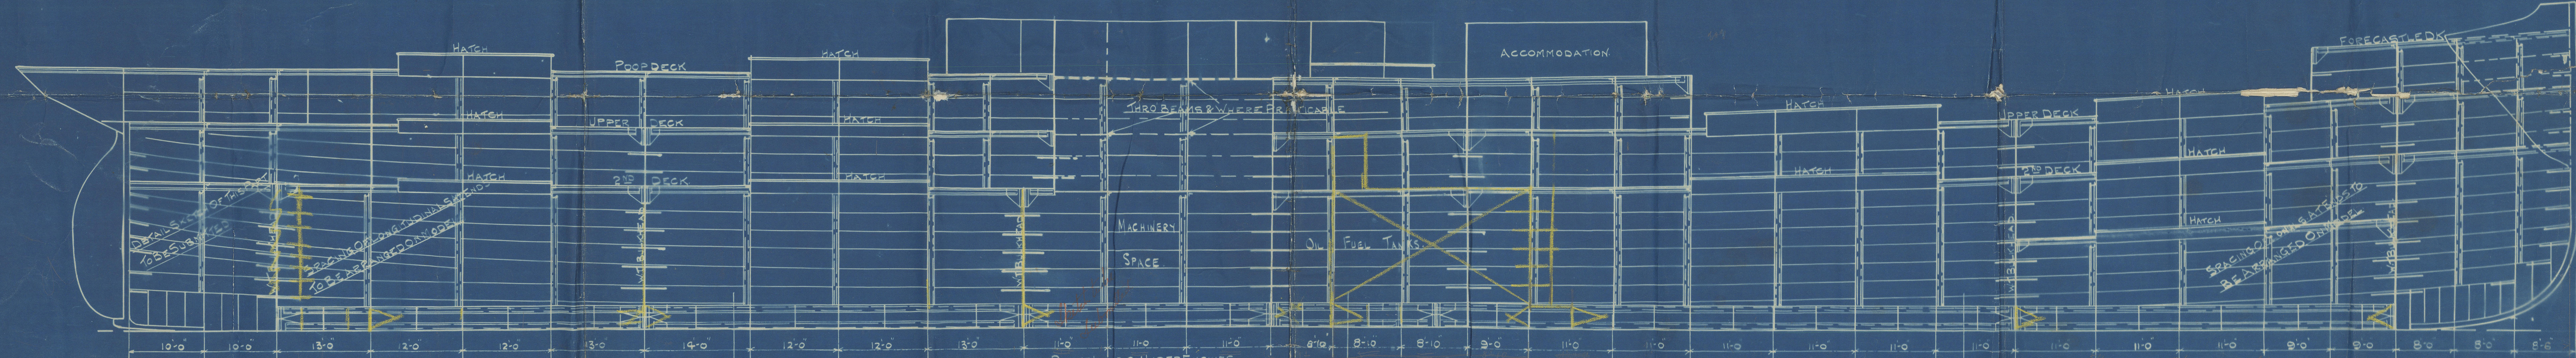


1/2 LENGTH

1/2 LENGTH

PLATE LONGS UNDER ENGINES  
& DOUBLE ANGLS ON TRANS & LONGS  
AT TANK TIP UNDER ENGINES.

SEPARATE PLAN OF OIL FUEL  
TANKS WILL BE SUBMITTED.

BOTTOM LONGS GRADUATED FROM 31' AT FORE HOLD BHD.  
TO 29' AT COLLISION BHD.

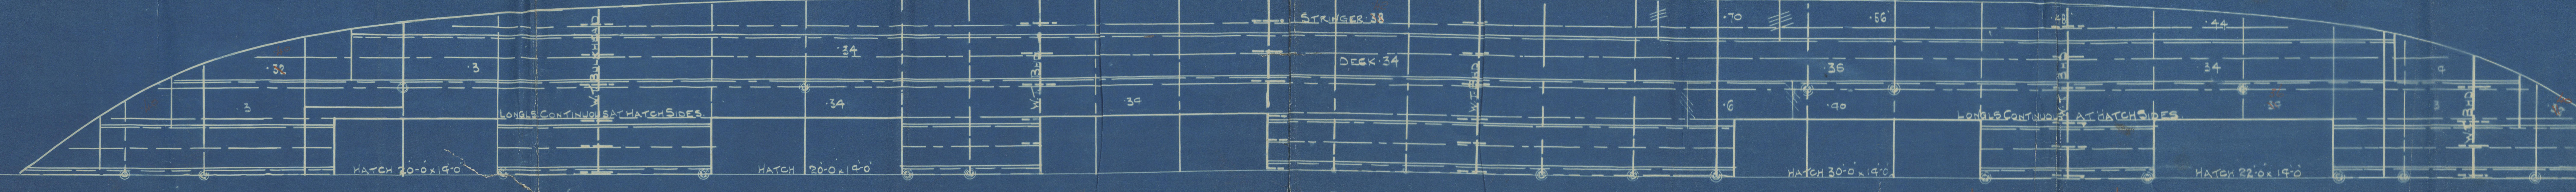

UPPER DECK



W332-0170

W3 "Integran" to "Lutz"

Profile & Deck Plan.  
Profile & Deck Plan.

Langschmidt  
Integran

W332-0170

Profile



© 2019

Lloyd's Register  
Foundation