

SCALE $\frac{1}{2}" = \text{ONE FOOT.}$


DIMENSIONS - 528'-0" B.P. x 70'-0" MLD. x 43'-4 1/2" MLD. TO UPPER D^K (SHELTER D^K).

To CLASS 100 A.1. WITH FREEBOARD. ✓

DRAFT CORRESPONDS TO A COMPLETE SUPERSTRUCTURE VESSEL. ✓

NUMERALS.

| | | | |
|-------------|--|---------------|-------|
| D | $(43 - 4\frac{1}{2} - 8 \cdot 4\frac{1}{2} + 8 \cdot 0)$ | 43.00 | ✓ |
| L x D | (528.00×43.00) | 22704 | ✓ |
| L x (B + D) | $528.00 (70 + 43)$ | 59664 | |
| L/D | $\frac{528.00}{43 \cdot 4\frac{1}{2}} = \frac{528.00}{51 \cdot 10\frac{1}{2}}$ | 12.17 x 10.18 | 10.18 |
| d | | 14.80 | |

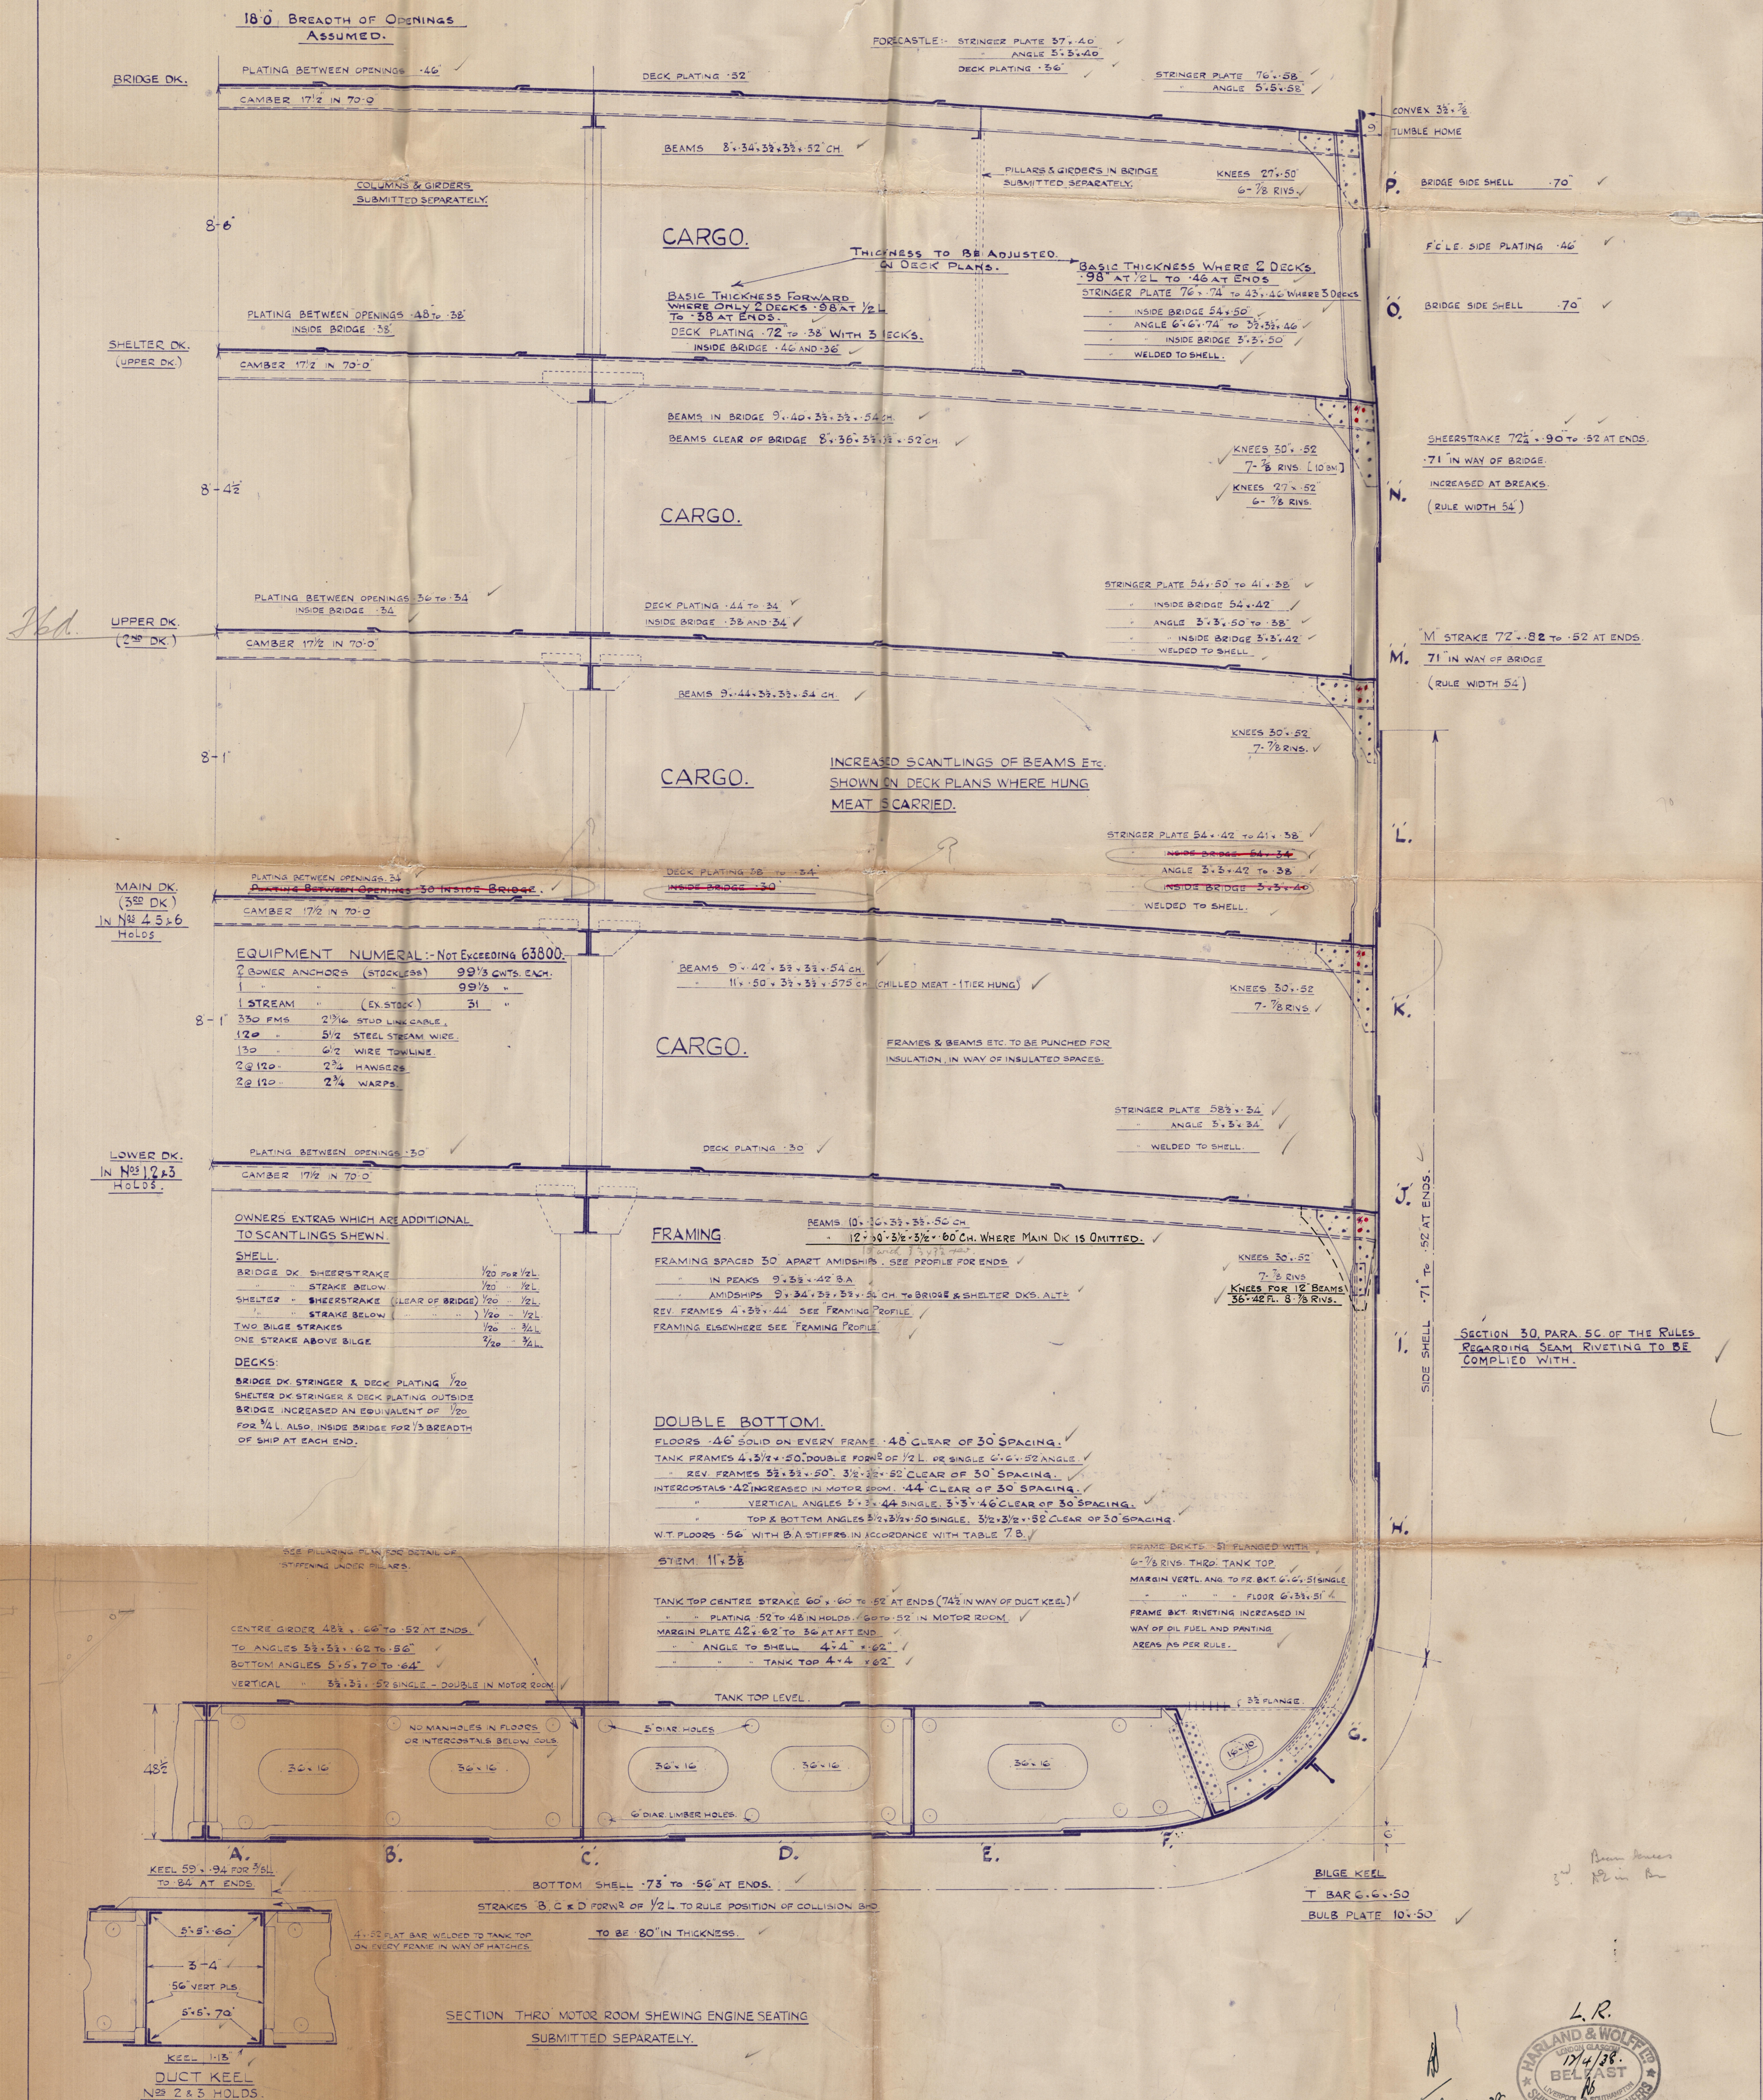

HARLAND & WOLFF LTD.
BELFAST

No. 1016 / 17

TITLE. MIDSHIP SECTION
(AMENDED)

DATE APPROVED. 28. 4. 38

1016. WELLINGTON STAR.
BEL. REPORT. 12451



© 2020

Lloyd's Register
Foundation

W334-0054