


T.S.S. 'AVALONA STAR' OIL FUEL BUNKERS.

SCALE 1/4" = 1 FOOT.



APPROVED BY
LLOYD'S REGISTER OF SHIPPING
Hickson
DATE 2.12.31

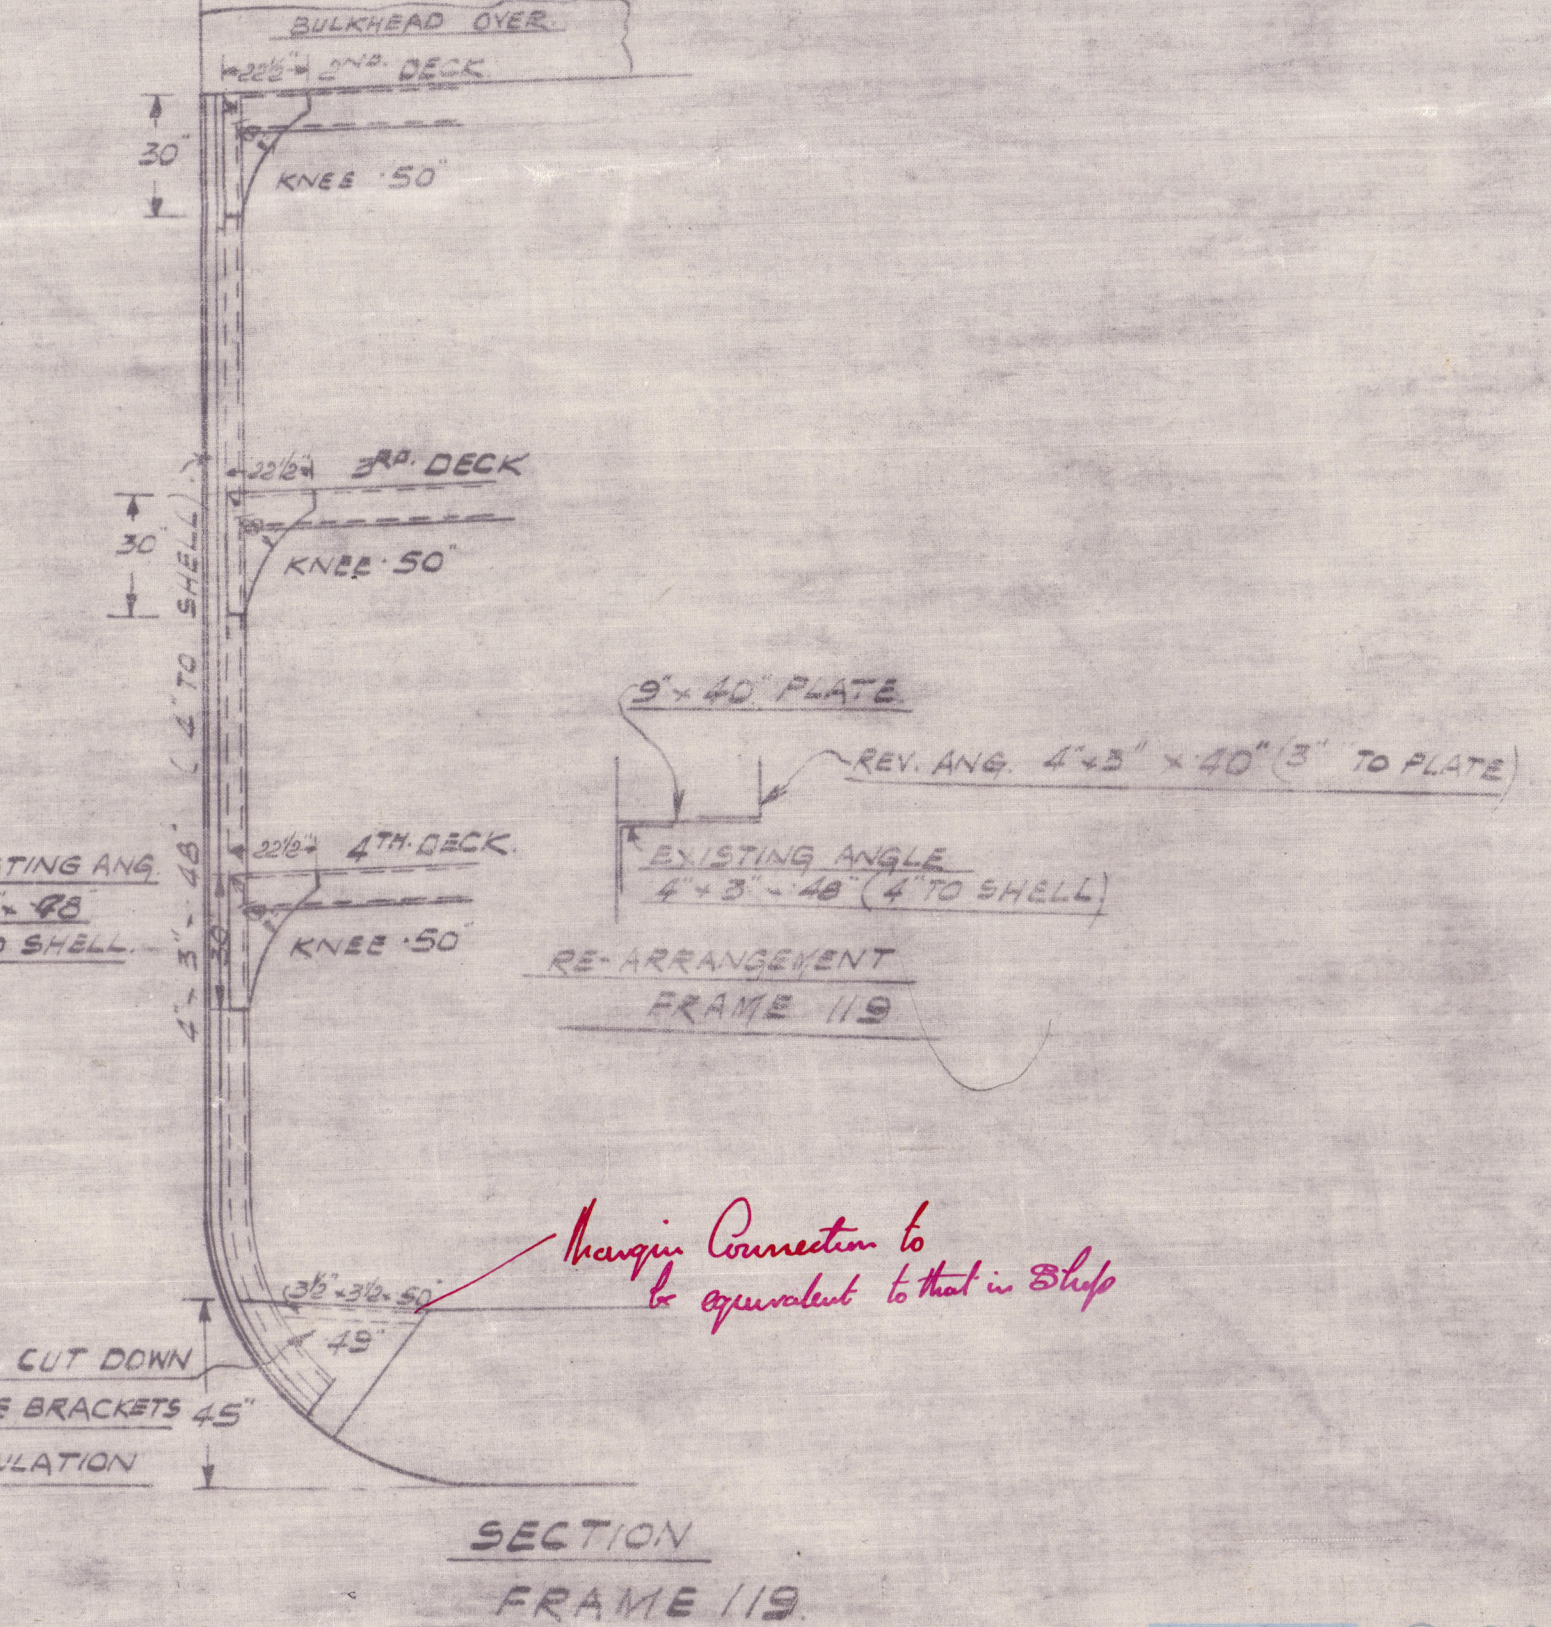

Notes: If these bulkheads are not light to 5' 6" high, they must be reinforced to 10' 6" high. 

⑥

SS Avelona Star

611 fuel

Bunkers

Gek. ~~First Entry~~ Report N° 19413.



© 2020

Lloyd's Register
Foundation

W334-0079