
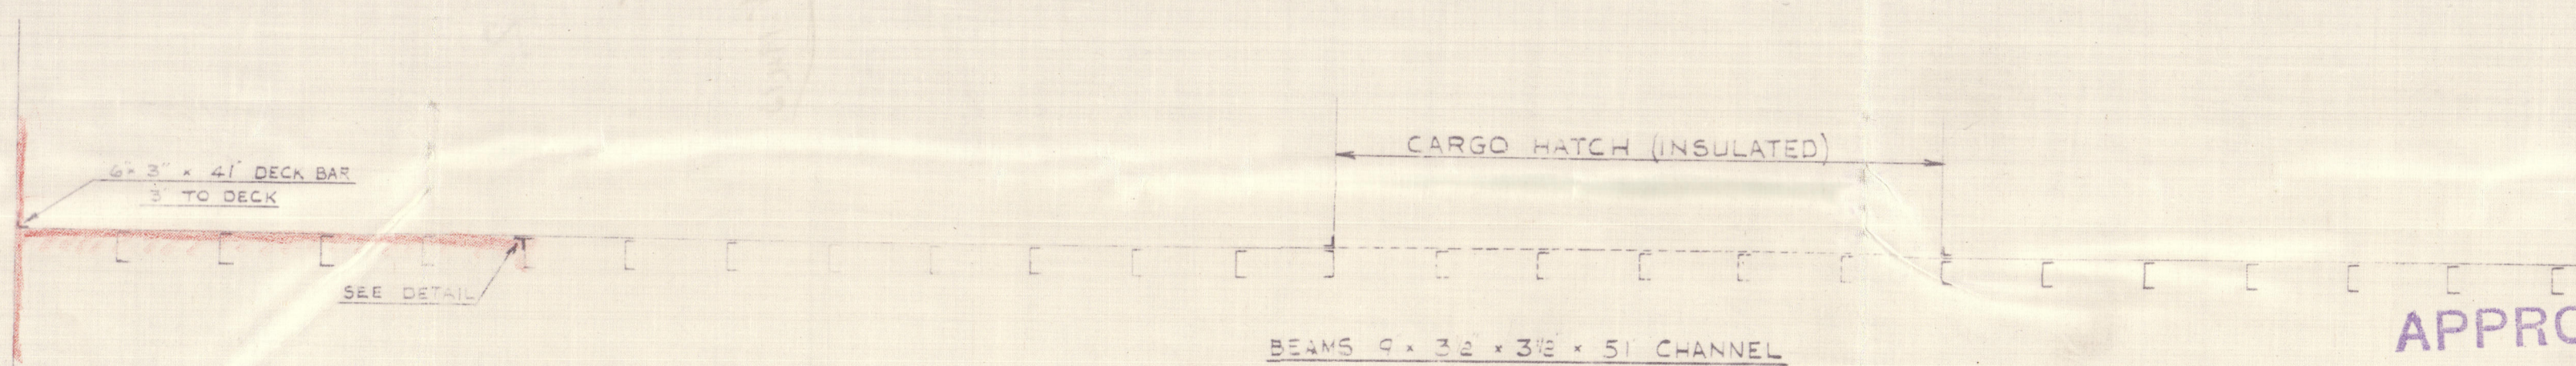
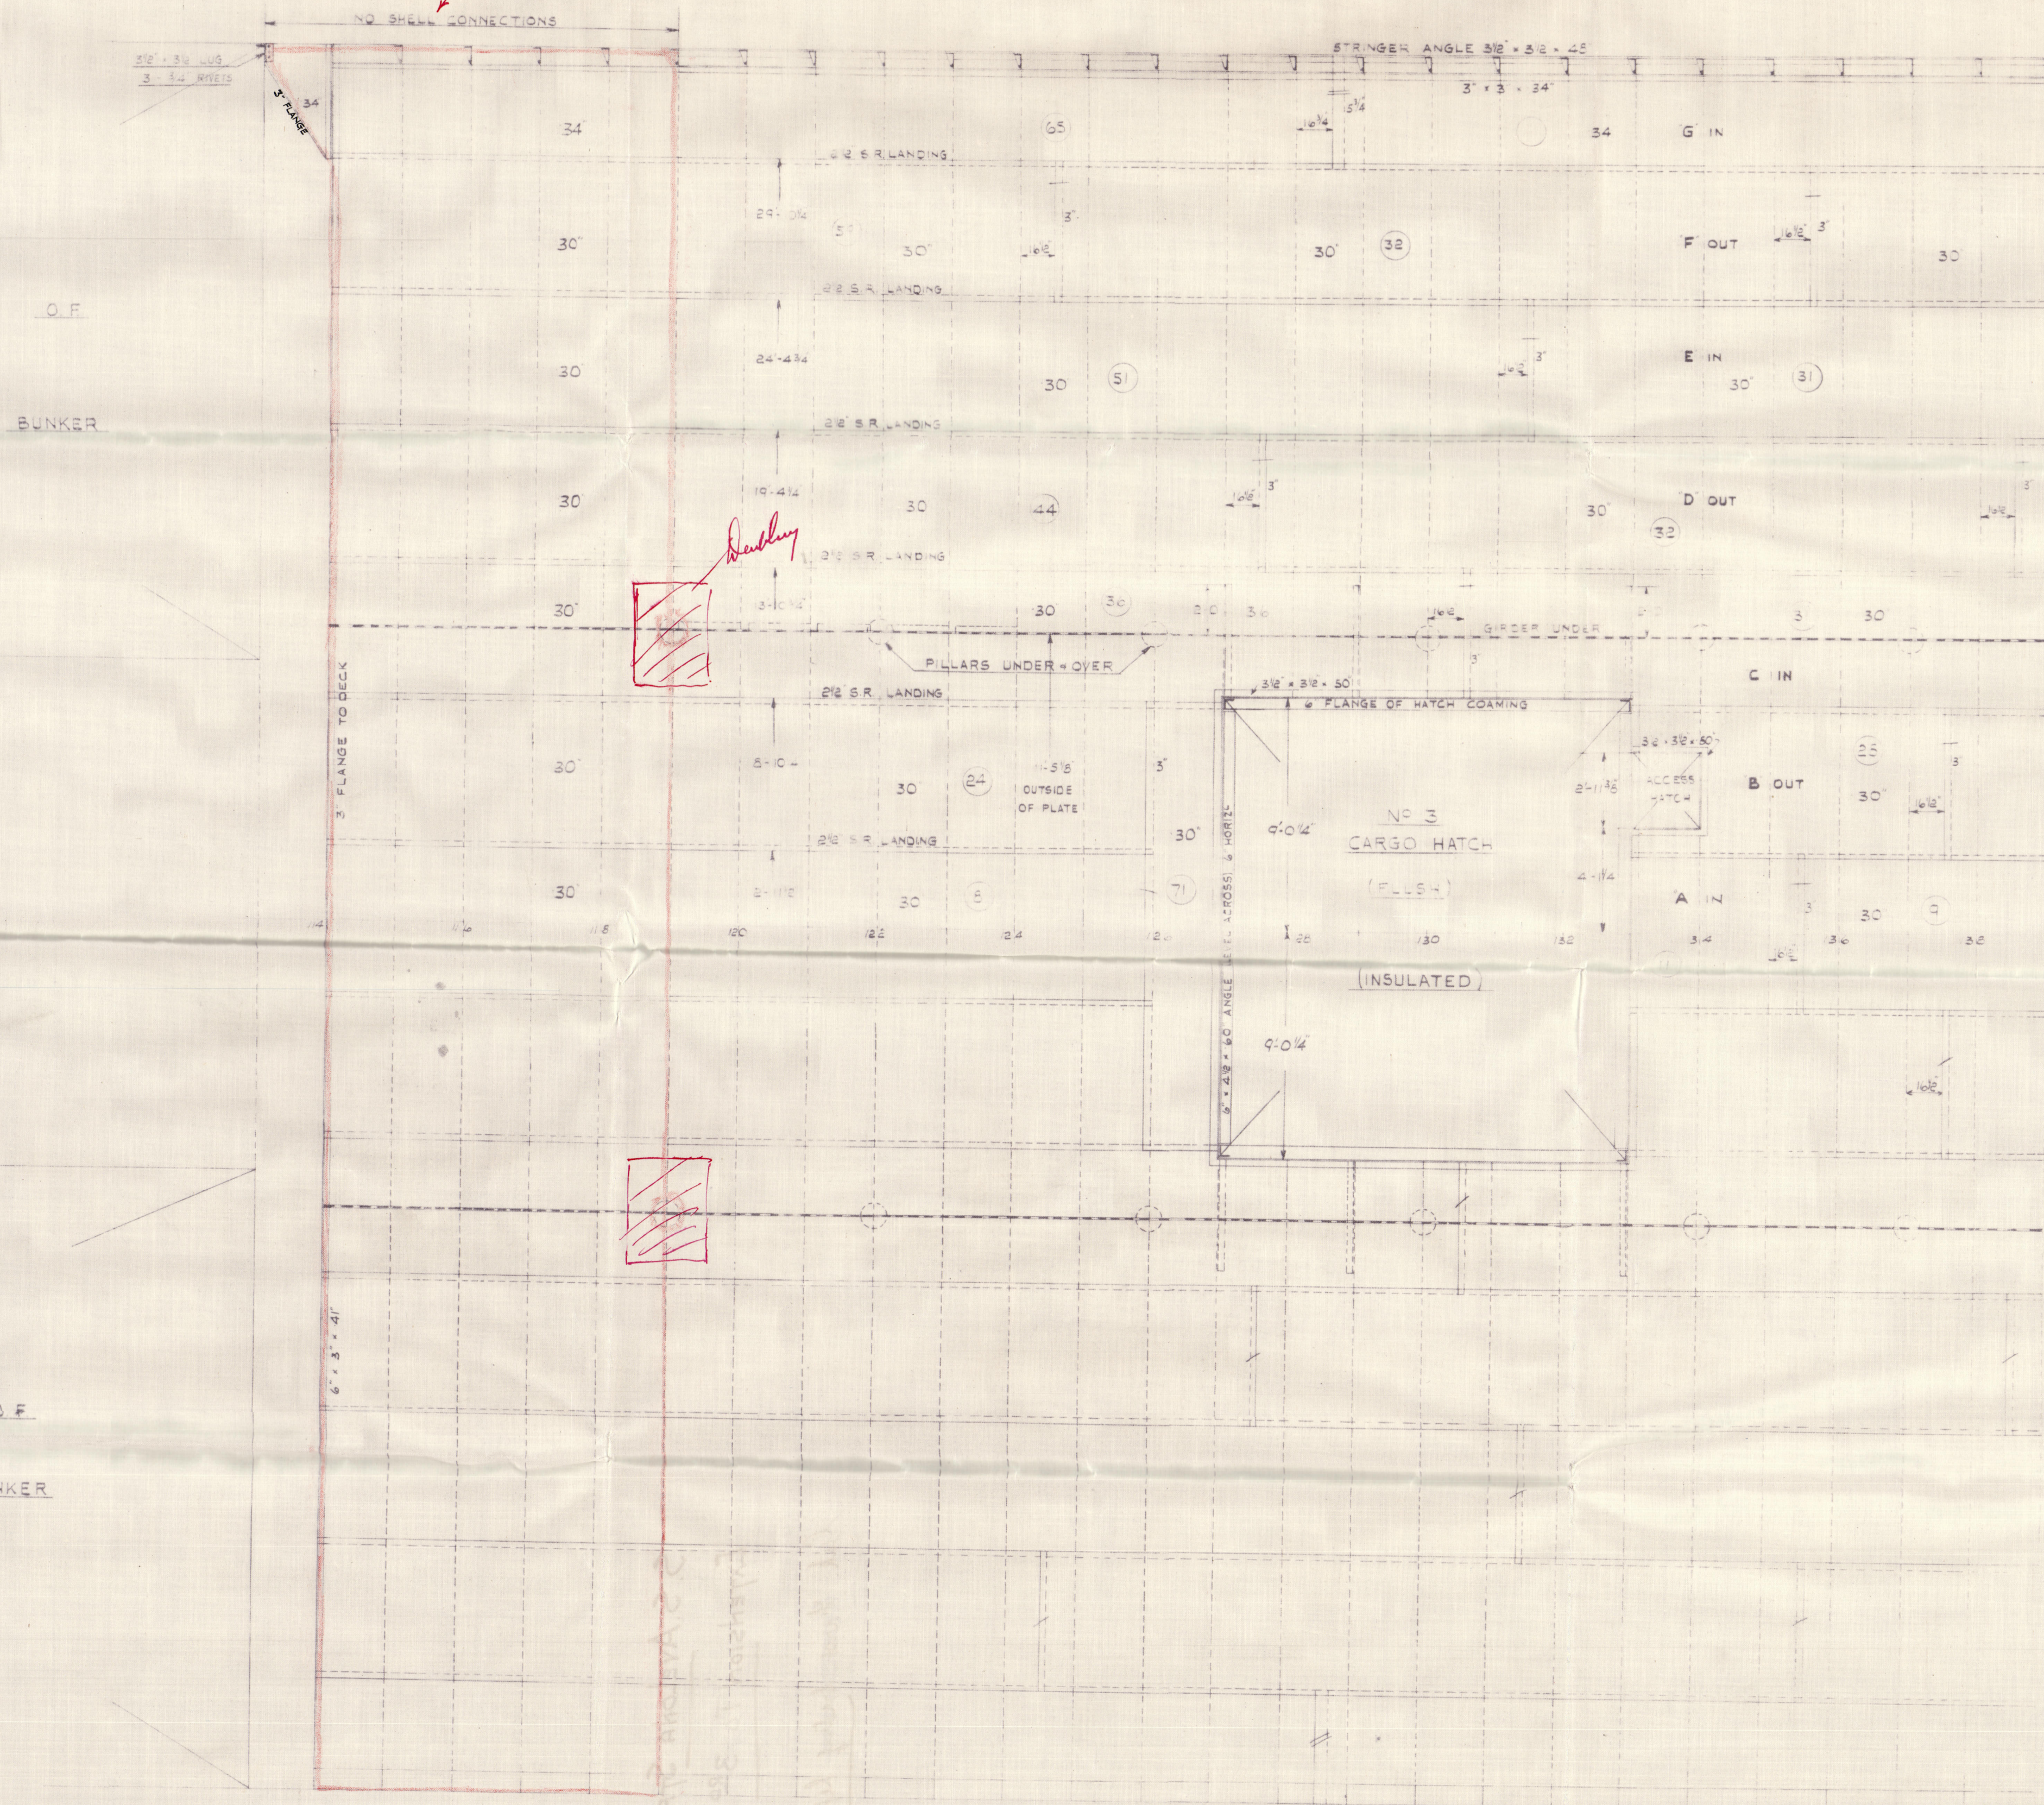


“AVALONA STAR” EXTENSION OF 3RD DECK PLATING SCALE 1/4" = 1 FOOT

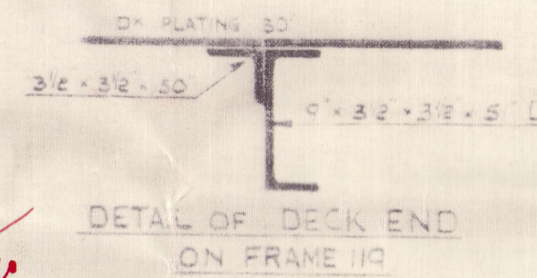

APPROVED
LLOYDS REGISTER OF SHIPPING
Blackburn
DATE 20.11.31

S. S. AVELONA STAR

2.

EXTENSION TO 3RD DECK

Gen. ~~Entry~~ Report 1/1-19413.



© 2020

Lloyd's Register
Foundation

W334-0144