
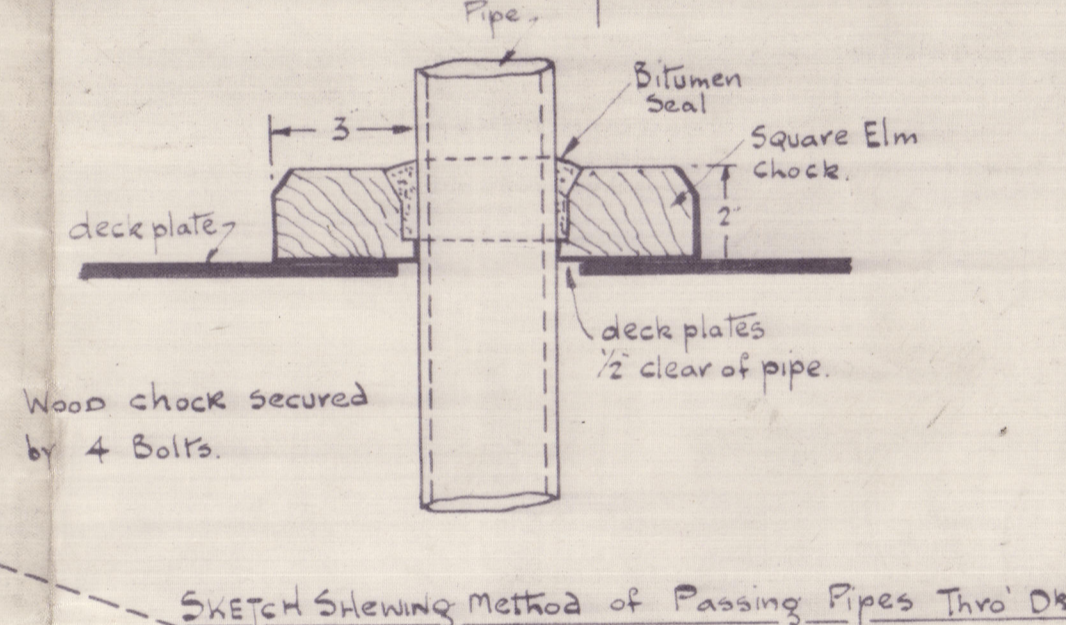
 


**T.S.S. "AVALONA STAR"**  
**BILGE, BALLAST & STEAM HEATING PIPES.**  
**(ADDITIONAL & ALTERED)**

SCALE 1/8" = 1 FOOT.

(See original Plan of Bilge & Ballast pipe for any necessary details.)

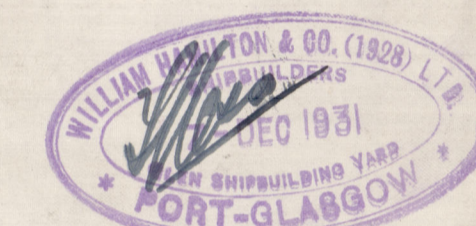

*Cancelled  
 as per approved 31/12/31 4.12.  
 Provision to be made for securing oil  
 fuel bunkers and ship tanks*

*The flash point of the oil fuel to be above 150°F, and the requirements of Section 4 of the Rules (4.11-12) to be complied with as far as they are applicable.*

S.S. Audona Star.

Grk rpt. No. 19413.

Bilge, ballast & steam heating  
pipes



© 2020

W334-0151

Lloyd's Register  
Foundation