

Rpt. 6

For the information of Surveyors and the Committee only.

Received at _____ Office. _____ 19

Lloyd's Register of British & Foreign Shipping.

(Report on Vessel No. _____ Port Sunderland)

No. 13951 SHIP FORGINGS ~~OR CASTINGS~~.

I have to report that the undermentioned ~~Iron or Steel Forgings or Castings~~, manufactured by Palmer's S. & I. Co. Ltd. of Farrow-on-Lyne for the Vessel No. 283, being built by Sunderland Shipbuilding Co. Sunderland have been inspected by me as set forth below and found to be, so far as can be seen, Sound

New S.P.S.R. as per plan

Mark on Forgings or Castings.



Lloyd's
No 344-N
W.C.

W. Campbell
Newcastle

14-7-14

	STERN FRAME.	RUDDER FRAME.	STEM.
Material*	<u>Scrap Steel</u>	<u>Scrap Steel</u>	
How made	<u>Forged & Smithed</u>	<u>Forged & Machined</u>	
Dimensions	<u>10 x 7 1/2</u>	<u>9</u>	
Progress on Inspection	<u>Smithing</u>	<u>Machined & built</u>	
Date when Inspected	<u>January 23, to July 11, 1914.</u>		
CASTINGS.			
Tests on Standard Test Pieces.			
Tensile Test—			
Tons per square inch			
Extension per cent.			
Cold Bending Test—			
Angle before fracture			
Drop Test—			
Height from ground			
Hammering Test—			
If made according to Rules and found satisfactory ...			

SKETCHES OF FRAMES SHOWING POSITION AND DESCRIPTION OF WELDS OF FORGINGS.

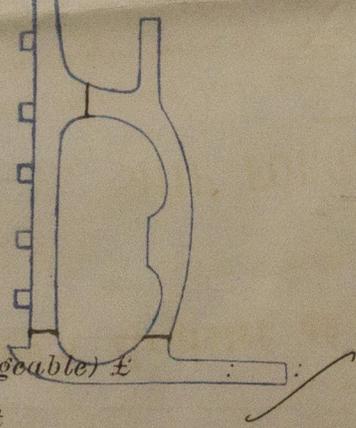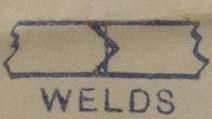

Fee (if any chargeable) £ _____
To be paid at _____



© 2020

Lloyd's Register
Foundation

* If of Iron, state whether scrap or puddled Iron. If of steel, state whether made on the Open Hearth process.


Ship Forgings

As Pacific

SUNDERLAND RPT. NO. 2623J

Handwritten notes:
1911 11 11
Sunderland
Ship Forgings
Sunderland
Sunderland
Sunderland

SHIP FORGINGS

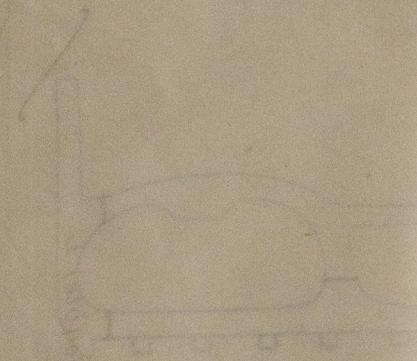

© 2020

Lloyd's Register Foundation