

"BARMORE"

EX

S. S. "Rowanpark".

Graingermonth Dockyard Co. Ltd's

403.

Midship section as built.

"BARMORE"

EX

No 403- S/S Rowanpark


GLASGOW REPORT No. 40679

W338-0076



© 2020

Lloyd's Register
Foundation

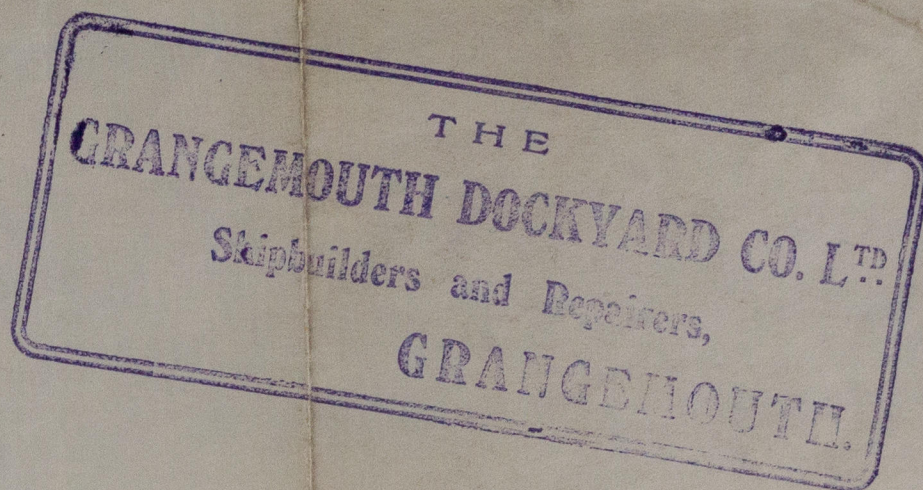

© 2020

Lloyd's Register
Foundation