





3-7-97

S.S. N^o 20.

PROPOSED ALTERATION TO AFTER PEAK BULKHEAD.

SCALE : $\frac{1}{4}$ INCH = 1 FOOT.

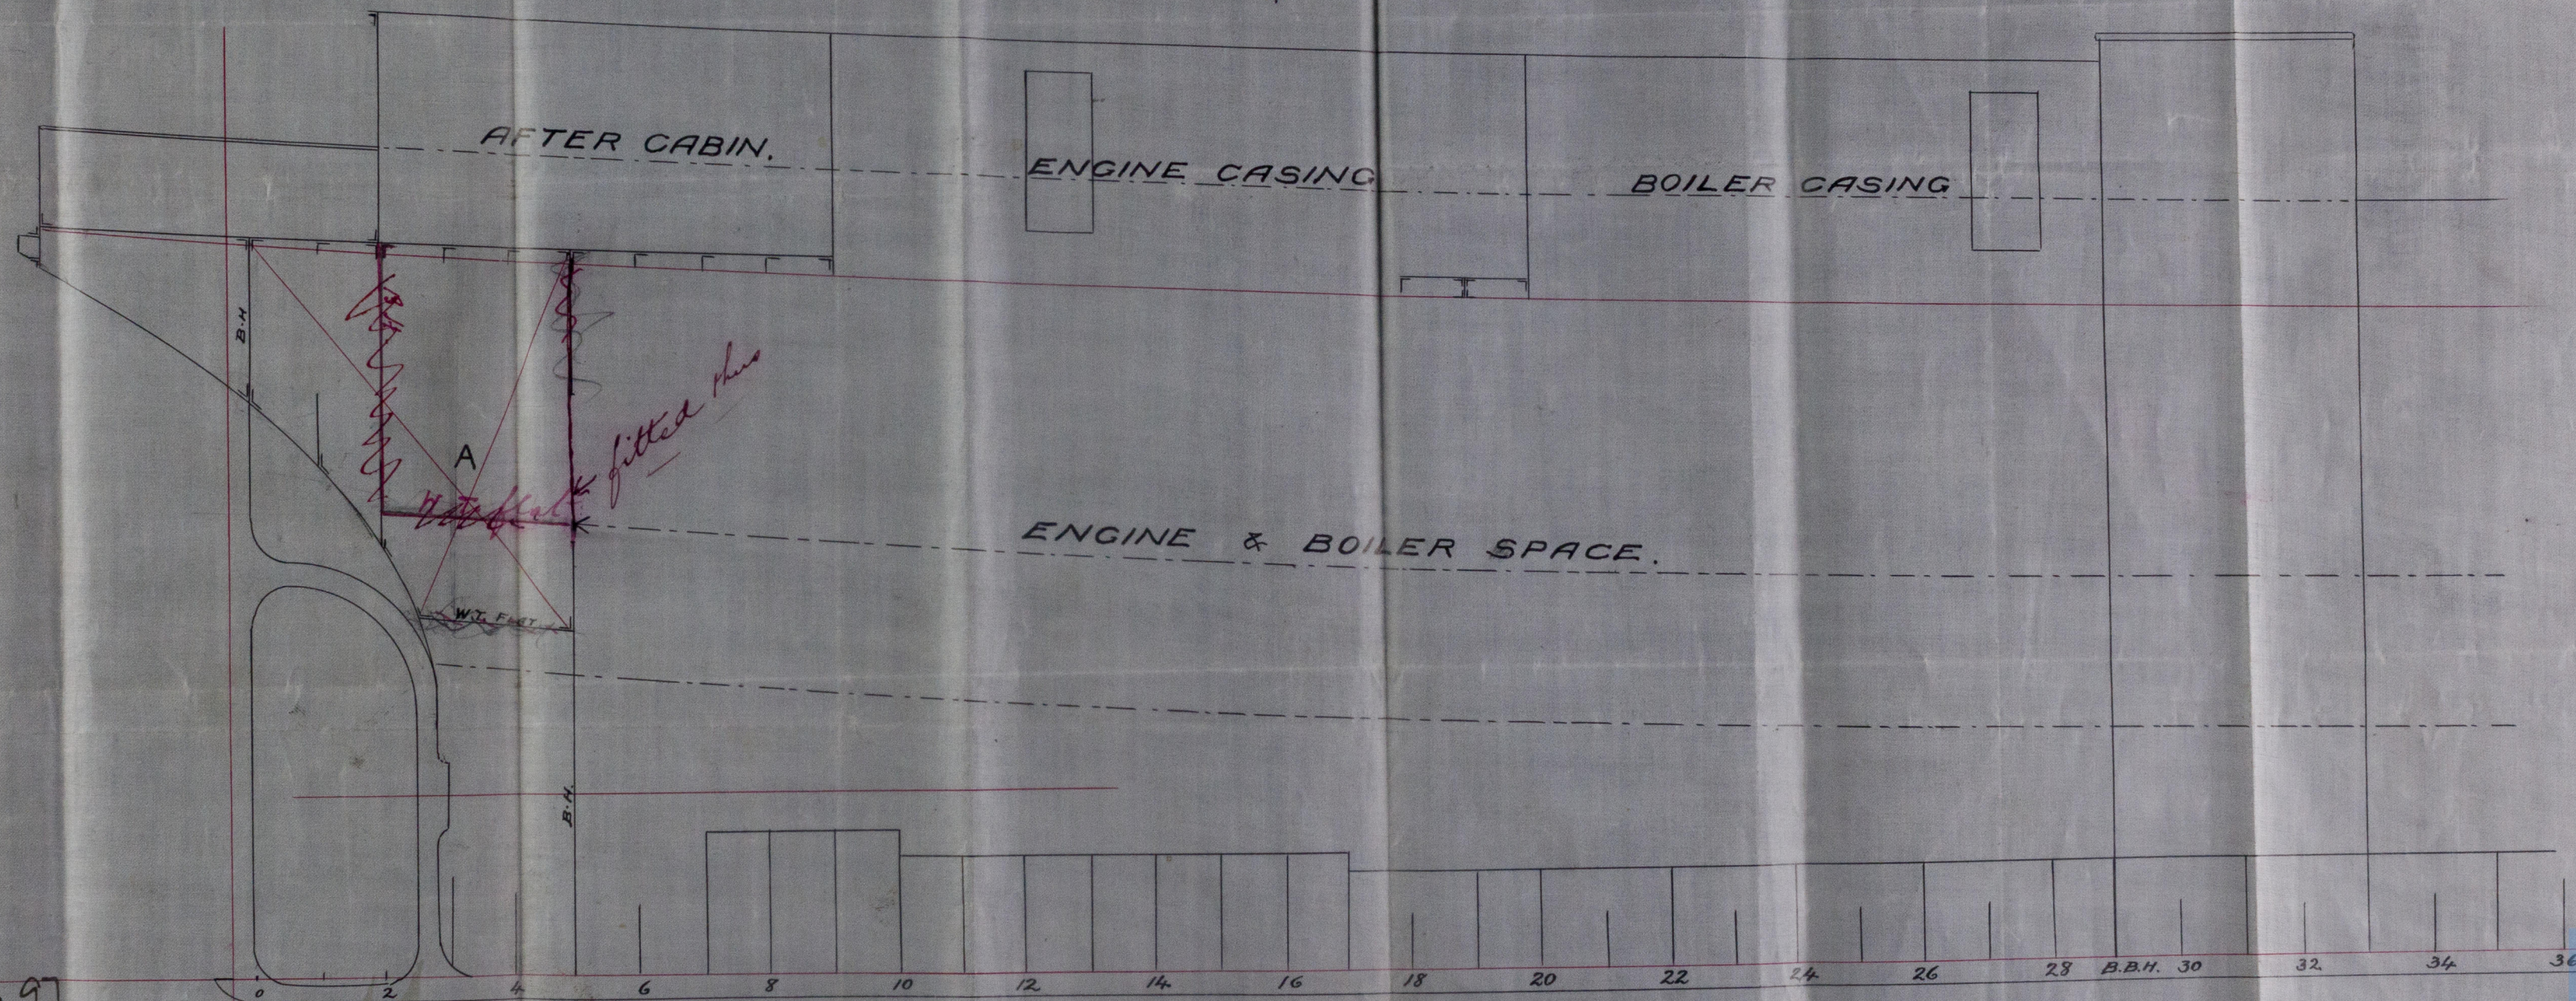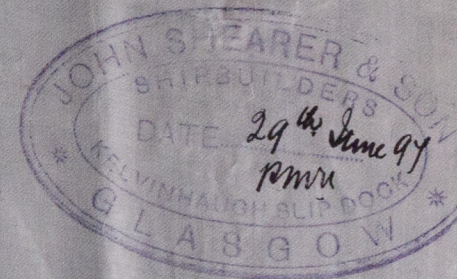

26
3-7-97



© 2020

Lloyd's Register
W338-0117
Foundation

^{n/n} "Bawtry."

^{ex}
S.S. "Mormaline"

GLASGOW. No 15,856.

W338-0112



© 2020

Lloyd's Register
Foundation