

21. 11. 96
22. 12. 96

Steel - S. S. N^o 20

200' x 30' x 14' 2" MOULDED

TO CLASS 100 A1 AT LLOYDS'

SCALE: $\frac{1}{2}$ INCH = 1 FOOT

✓ FRAMES, $3\frac{1}{2}" \times 3" \times \frac{6}{16}"$ FOR $\frac{3}{5}$ L. $\frac{5}{16}"$ AT ENDS. - spaced 22"

✓ REV. FRAMES, 3" X 2 1/2" X 5/16" TO SIDE STRINGER & DECK ALT.

TO HOLD STRINGER & DECK ALT. IN WAY OF R. Q. D.

ALT. TO FKSL, DK. - DOUBLE IN E. & B. SPACE.

BULKHEADS, $5/16"$. STIFFENERS, $3\frac{1}{2} \times 3 \times 6/16"$.

STIFFENERS TO COLLISION B, H, BRACKETED TO SHELL. BULB ANGLE.

KEEL $7\frac{1}{2}'' \times 2\frac{5}{8}''$. STERNPOST $7\frac{1}{2}'' \times 4\frac{1}{4}''$. STEM, $7\frac{1}{2}'' \times 2\frac{1}{4}''$

KEEL SIDE BARS $7\frac{1}{2}" \times \frac{7}{8}"$. CENTRE PLATES, $9/16"$

RUDDER STOCK $4\frac{3}{4} \times 2\frac{3}{4}$ BILGE KEEL, $8\frac{1}{2}$ " BULB PLATE & $3\frac{1}{2} \times 3\frac{1}{2} \times \frac{7}{16}$ BARS

M. & Q. DK. BEAMS, $5\frac{1}{2}" \times 3" \times \frac{7}{16}"$ ON EVERY FRAME.

FRONT BEAMS $4\frac{1}{2}" \times 3" \times \frac{5}{16}"$ $5\frac{1}{2}" \times 3" \times \frac{7}{16}"$ UNDER WINCH.

PLATE BEAMS: 15" x 8 1/4" WITH BRACKET KNEES. AT ENDS OF HATCHES.

P. S. C. 2/ " P. 1/ 2

BUTT STRAPS OF STEEL THICKER THAN PLATES FOR 1/2 L. W.

(General Note on Butts) [3"] Thicker than plates

OVERLAPS OF STRINGER PLATES & SHELL PLATING TREBLE RIVETED FOR

STRAKES ABOVE & BELOW SHEERSTRAKE TREBLE RIVETED IN WAY OF BR

BUTTS OF FLANGE PLATES & SIDE GIRDERS DOUBLE RIVETED.

CENTRE THROUGH PLATE DOUBLE RIVETED WITH DOUBLE STRAPS.

1/2 BEAM.....	15.00
	27.31
1/2 GIRTH.....	27.15
	10.04
DEPTH.....	14.79

~~56.94~~ = $1 \frac{57}{100} \text{ N}^{\circ}$

LENGTH 198.75

$$\frac{11392.35}{11316.85} = 2^{ND} NO$$

~~14.14.60~~

72

~~1018592~~

11316 85

~~12335.362~~ = EQUIPM

12417.65


LENGTH OF FLECTIONS = 144. -

LENGTH OF ERECTIONS = 144. —

$$\frac{144}{198.75} = .72$$
$$\frac{L}{D} = 13.45$$

SECTION ON ALTERNATE FRAMES.

© 2020
Lloyd's Register
W338-0118

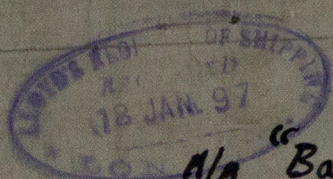

A/A "Bawtry,"
ex
S.S. "Journaline",
Glasgow No. 15813.
No. 1st Entry No. 15856.

W338-0118



© 2020

Lloyd's Register
Foundation

20

© 2020

Lloyd's Register
Foundation