

SCALE  $\frac{1}{8}" = 1 \text{ FOOT}$

FOR BULKHEAD & TUNNEL SCANTLINGS. SEE  
"PROFILE FOR W.T. & BUNKER BULKHEADS"




BARCLAY CURLES

No 617-618.

PROFILE

617 Beaverford  
GLASGOW REPORT No. 47531

618 Beaverhill  
GLASGOW REPORT No. 47660

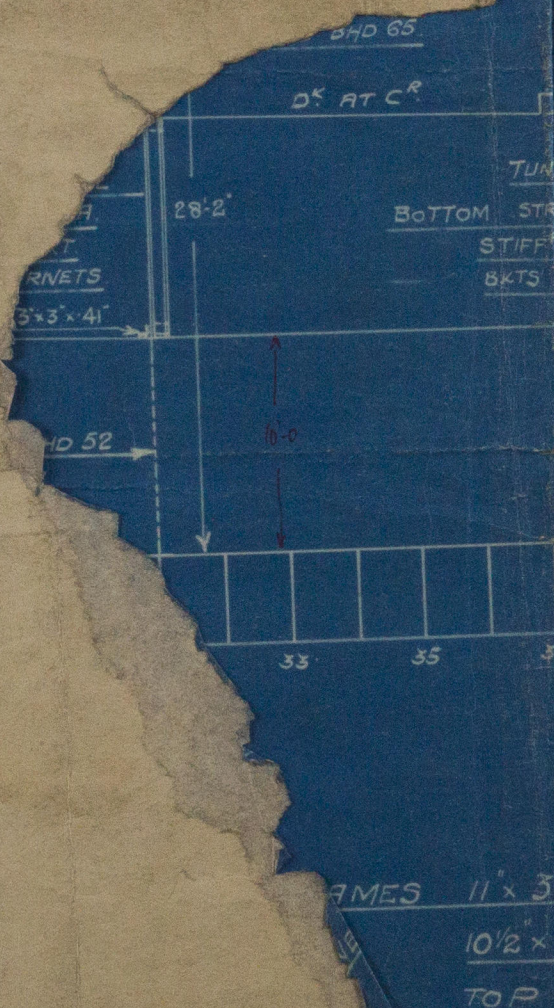

© 2020

Lloyd's Register  
Foundation

W339 0077