



~~PIPE~~

 


CONTRACT No.
5/1458

CANCELLED SEE
 SK. /R12.

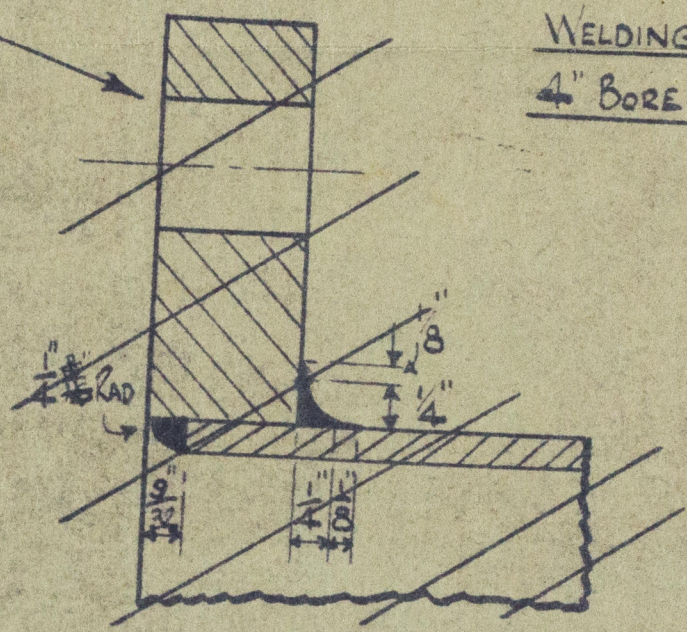

WELDING PARTICULARS FOR
 4" BORE STEAM PIPE.

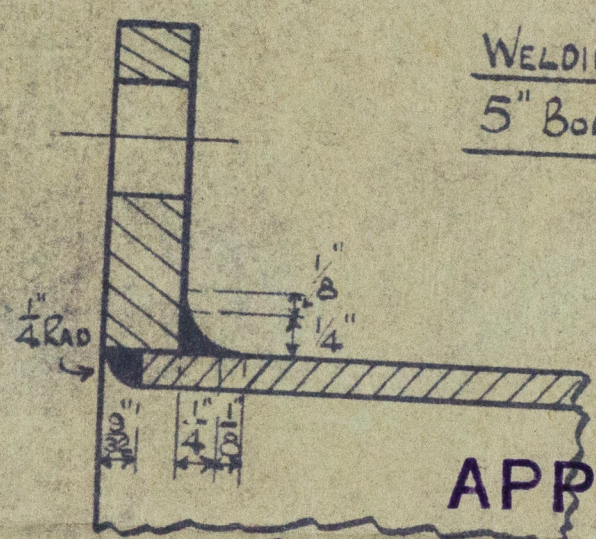

WELDING PARTICULARS FOR
 5" BORE SAFETY VALVE ESCAPE.

APPROVED
 LLOYD'S REGISTER OF SHIPPING

J. R. Beveridge 14/8/41
 DATE

FOR OTHER FLANGE DETAILS SEE DRAWING No. —
 MARK Nos. TO BE PAINTED AND STAMPED ON.
 TEST — LBS. PER □ INCH. W.P. — LBS. PER □ INCH.

SKETCH No.
5/1458/R11

DRAWN BY	PASSED BY	DATE
A BREMNER		11-8-41

SURVEYOR'S COPY.

W34-0103

Babcock & Wilcox

to

5/14/58

⑦

Method of attaching
flanges of steam
turbine pipes

Empire Tarpon

GLASGOW REPORT No. 64433

W34-0103



© 2020

Lloyd's Register
Foundation