



VIEW OF INLET FLANGE

LOOKING IN DIRECTION OF ARROW
 $7\frac{1}{8}$ DIA TAPPED FOR $8\frac{3}{4}$ DIA STUDS ON $5\frac{3}{4}$ P.C.

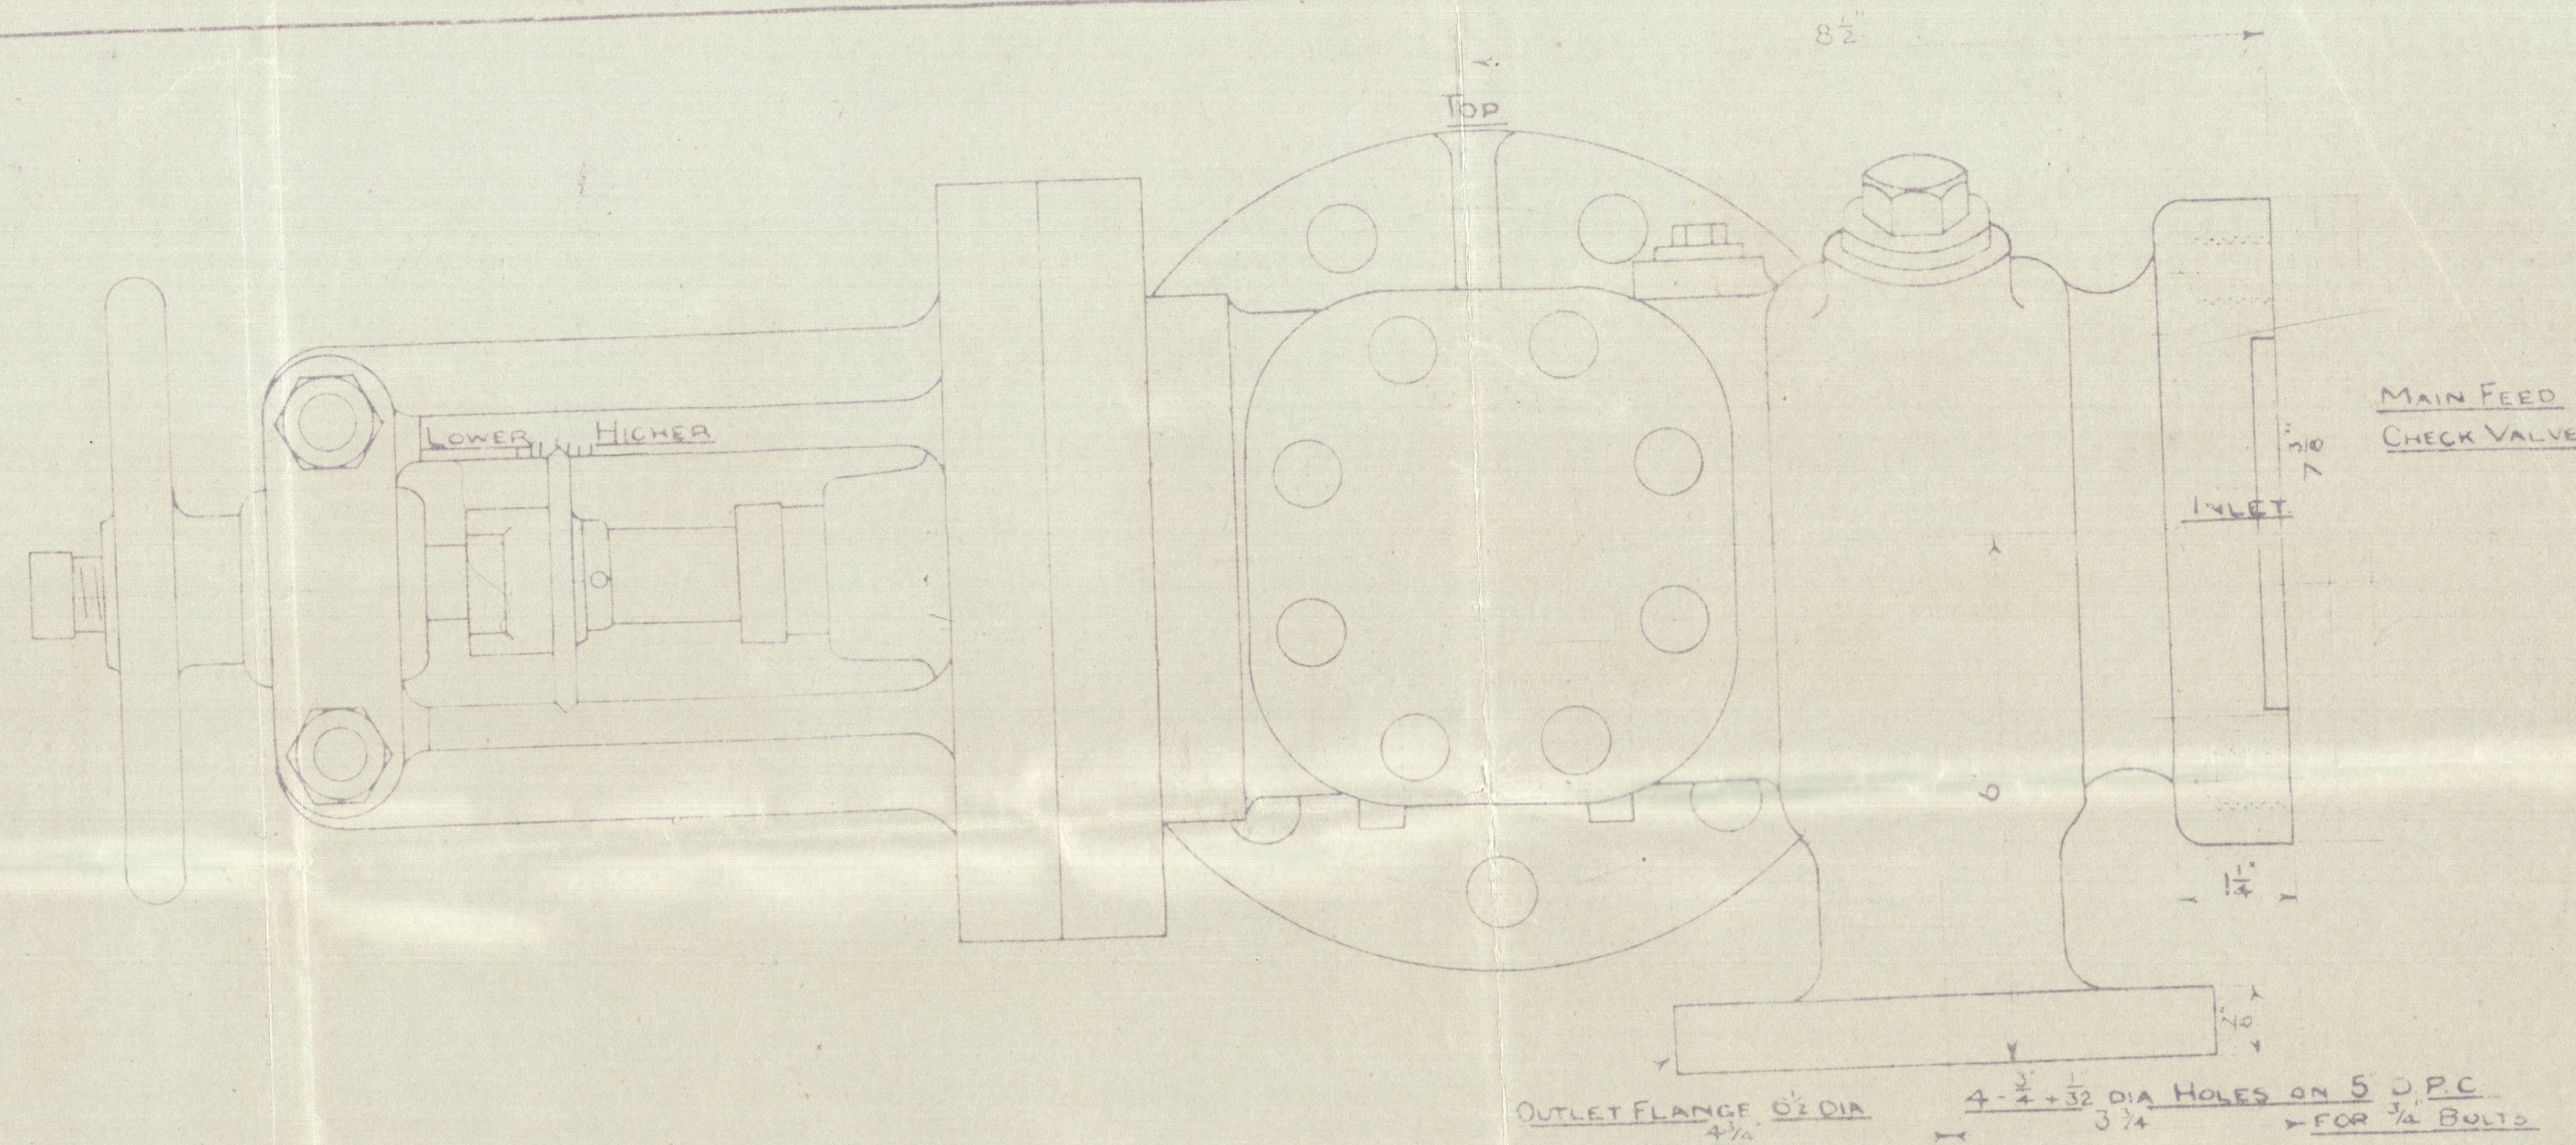

FLANGE JOINING PAD ON STEAM DRUM
 SPIGOT $5\frac{1}{8}$ DIA X 3 DEEP
 9 HOLES FOR $\frac{1}{2}$ STUDS ON $7\frac{1}{2}$ DIA P.C.

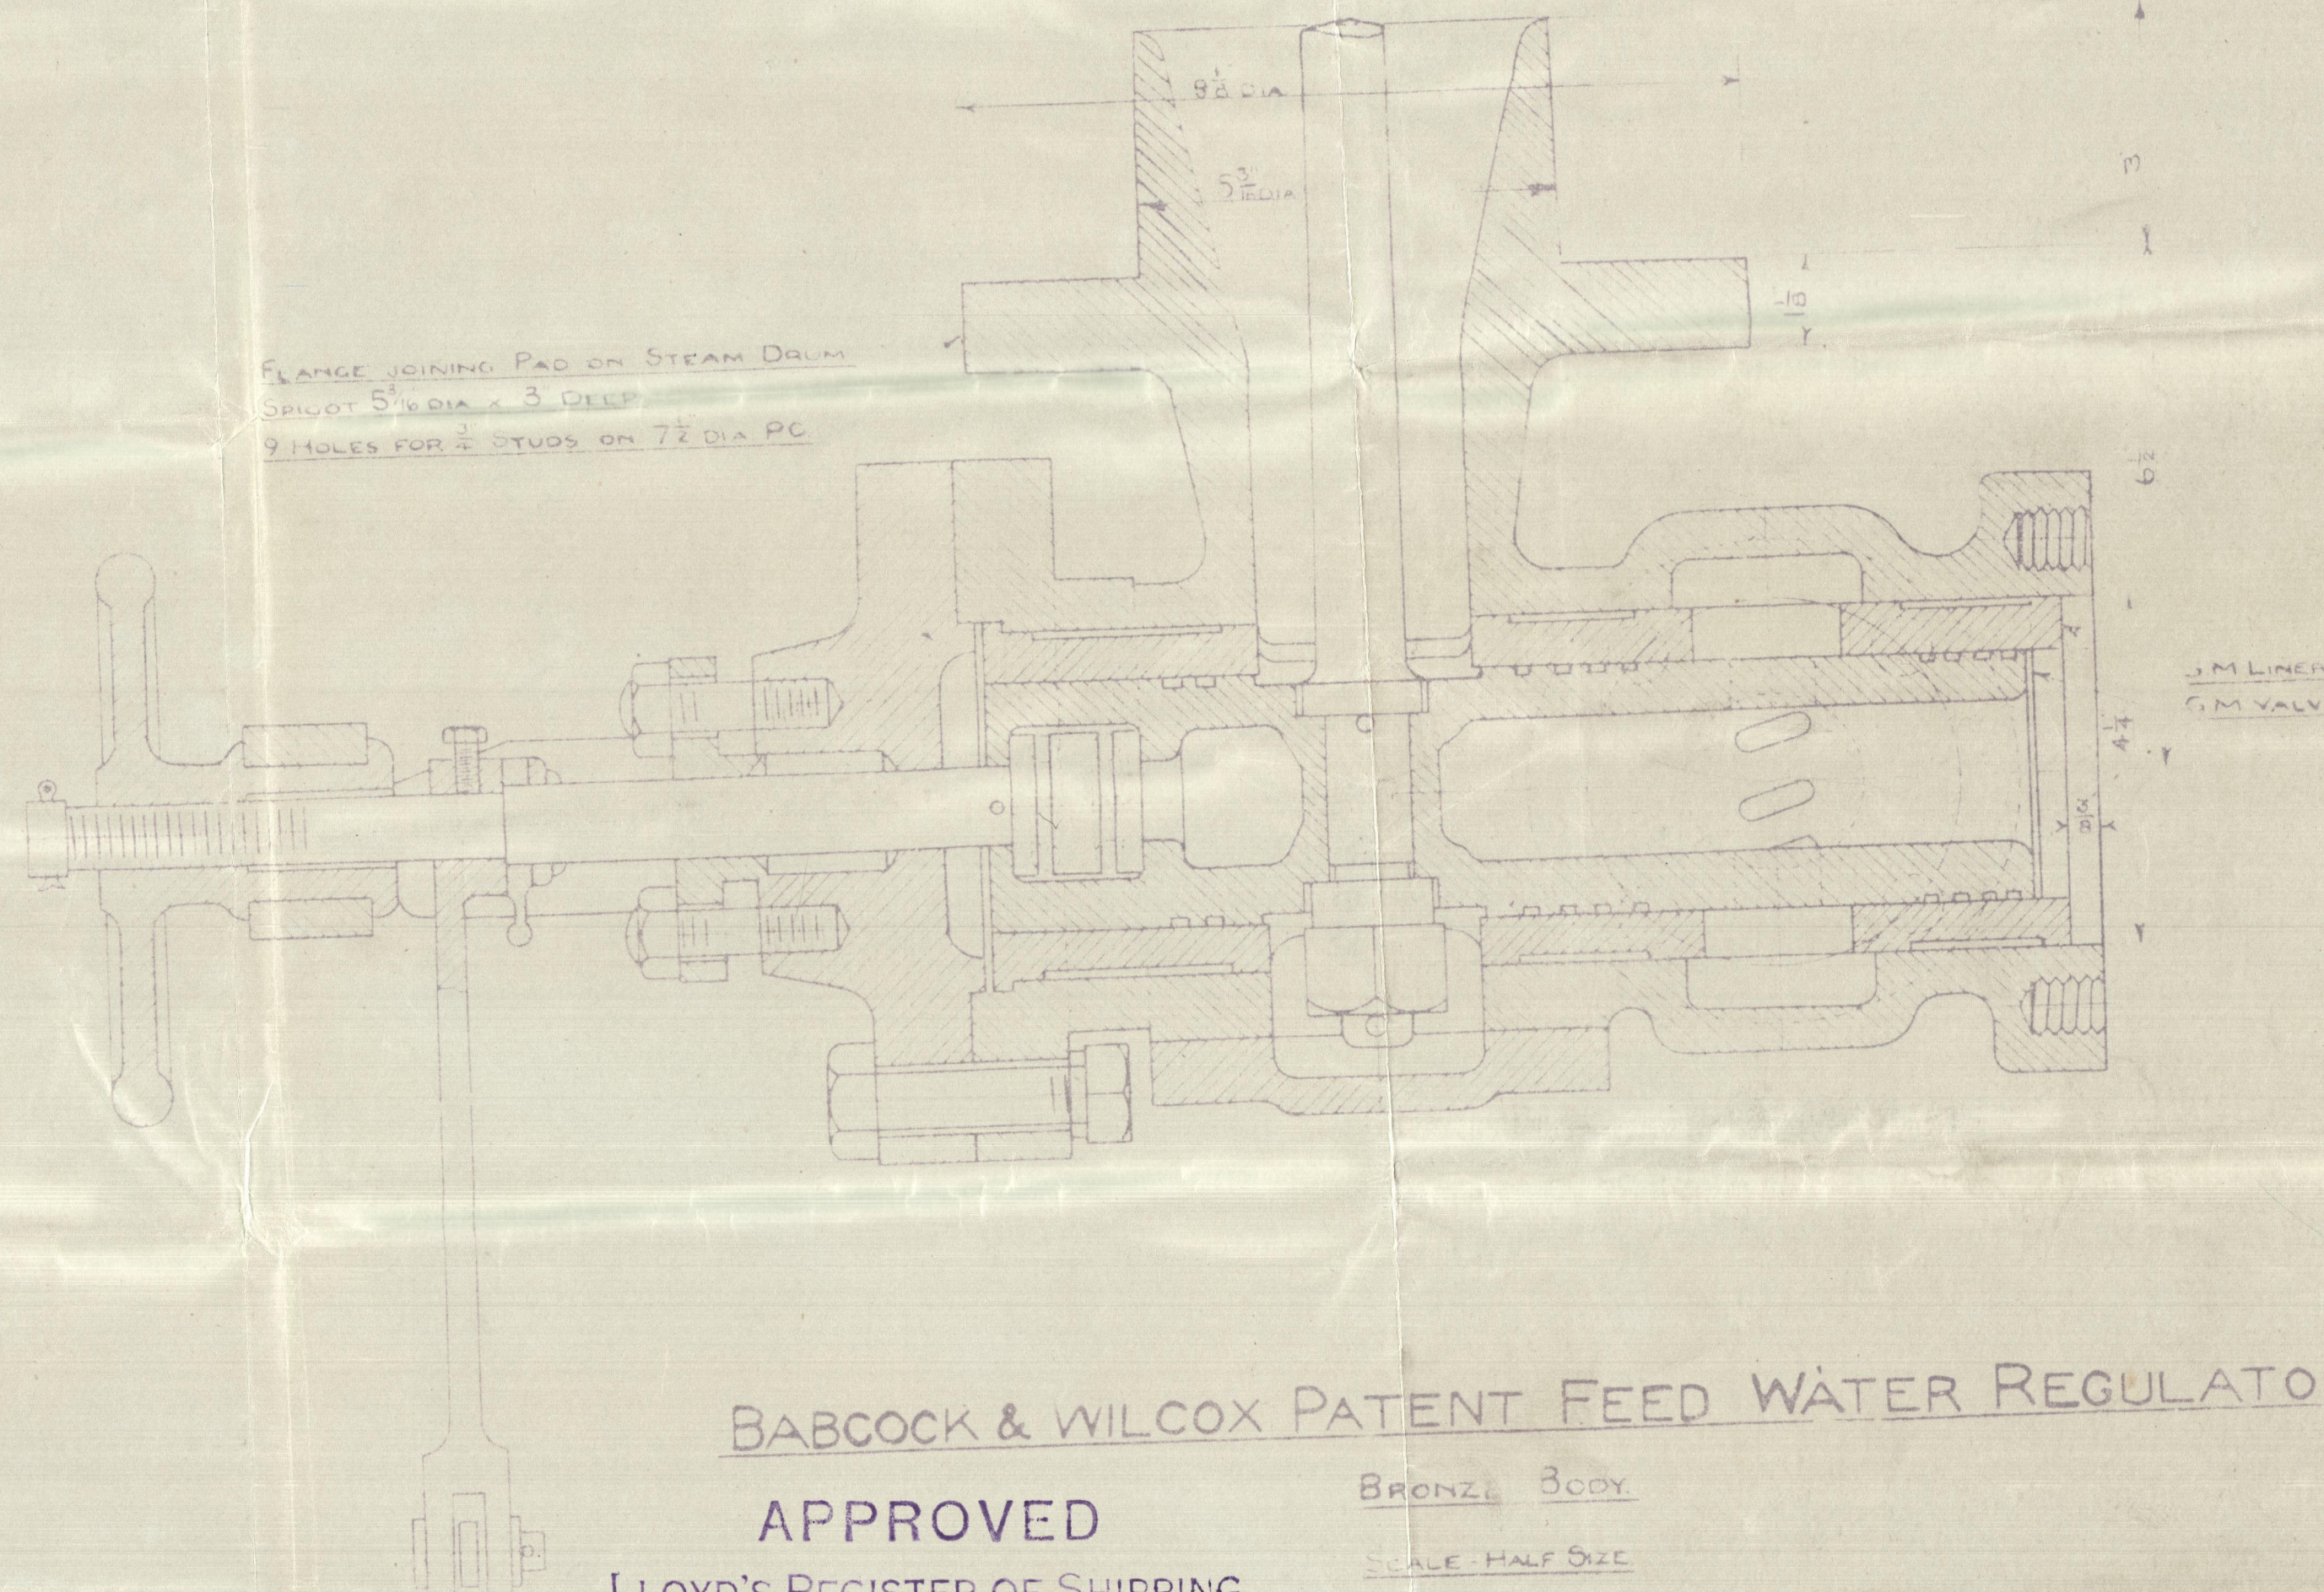

BABCOCK & WILCOX PATENT FEED WATER REGULATOR

APPROVED

LLOYD'S REGISTER OF SHIPPING

J. R. Beveridge

DATE 4/6/41

BRONZE BODY

SCALE - HALF SIZE

THIS DESIGN IS THE PROPERTY
 OF BABCOCK & WILCOX LIMITED
 AND IS NOT TO BE REPRODUCED
 OR USED IN ANY MANNER
 WITHOUT THE WRITTEN
 PERMISSION OF BABCOCK &
 WILCOX LIMITED

31, ABchurch Lane, WILCOX LTD
 ENGINEERING DEPT
 100, ST. LONDON, E.C. 4

LEAD ON BOILER SAFETY VALVE 225 LBS PER SQ INCH
 TEST PRESSURE 220 LBS PER SQ INCH
 TO LLOYD'S REQUIREMENTS 220 LBS PER SQ INCH

6/1458
 DRAWING No 6517/4.
 DATE 26.5.41.

(5)

Babcock & Wilcox Ltd

6/1088

Feed Water Regulator

Empire Tarpon

GLASGOW REPORT No. 64433

W34-0104



© 2020

Lloyd's Register
Foundation

J B Parker

30



© 2020

Lloyd's Register
Foundation

X134-0104