



Slope of pipes to be increased, if practicable,
for drainage purposes.

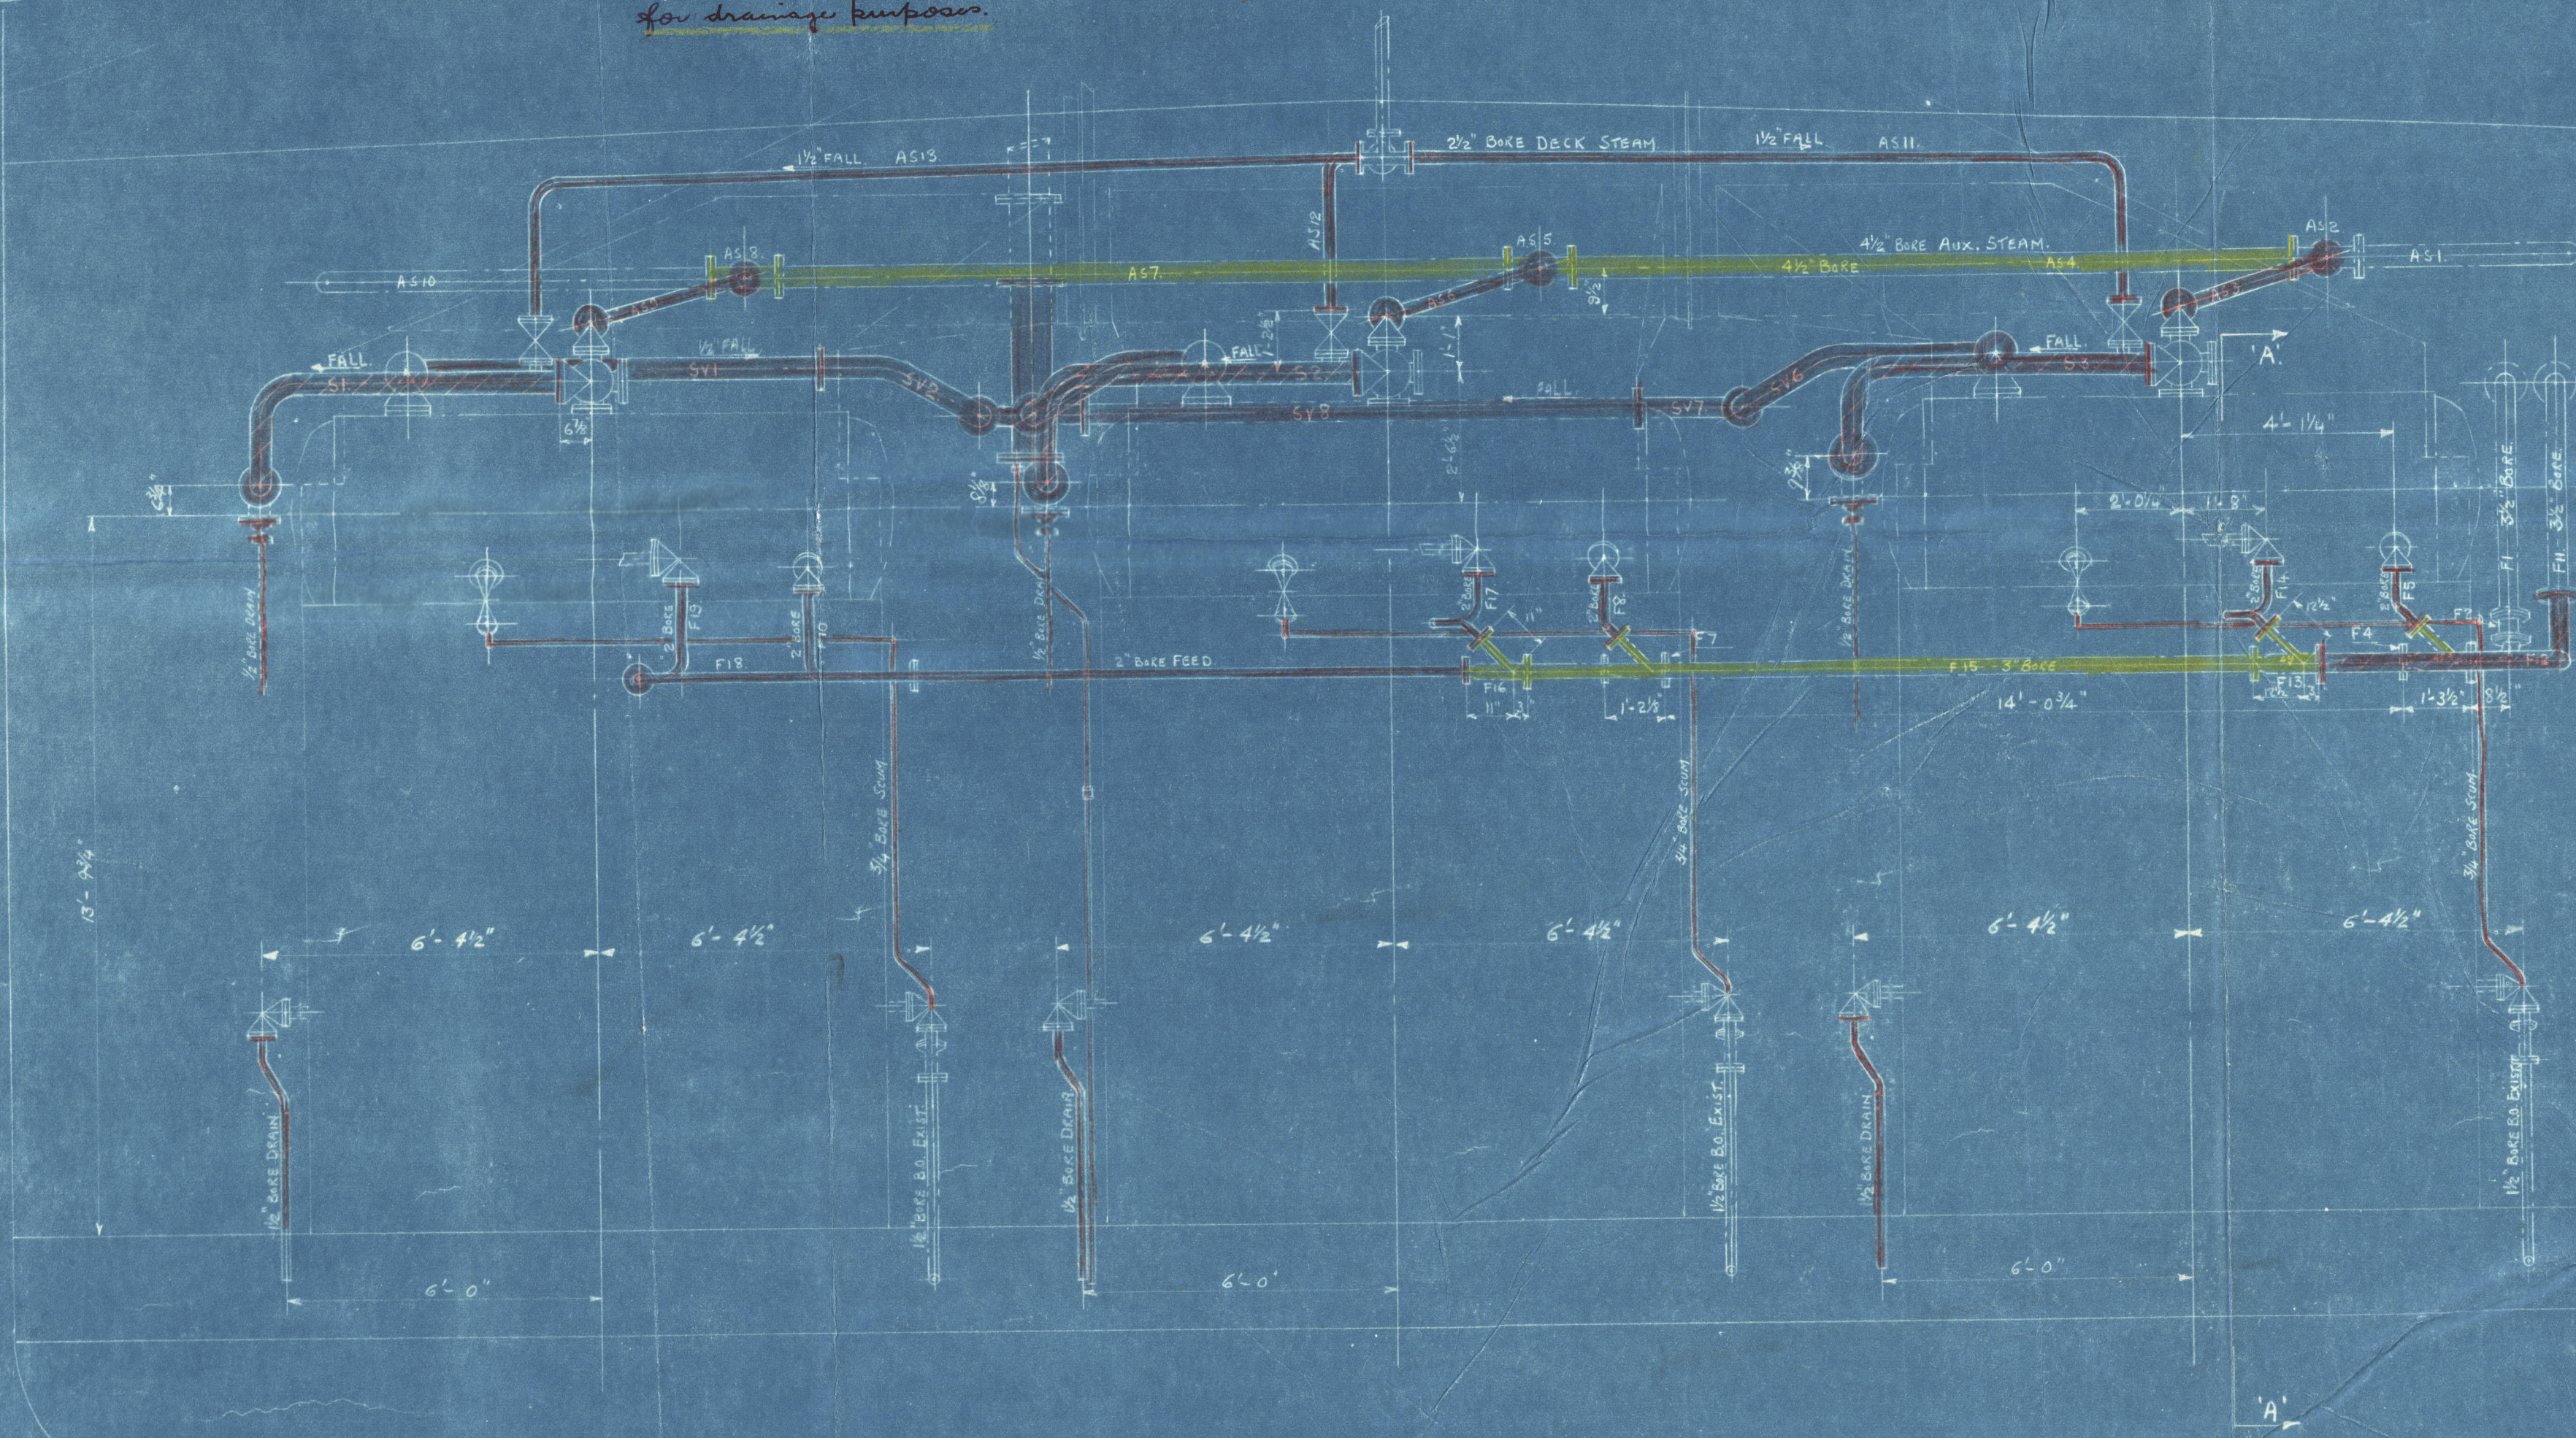

ELEVATION LOOKING AFT.

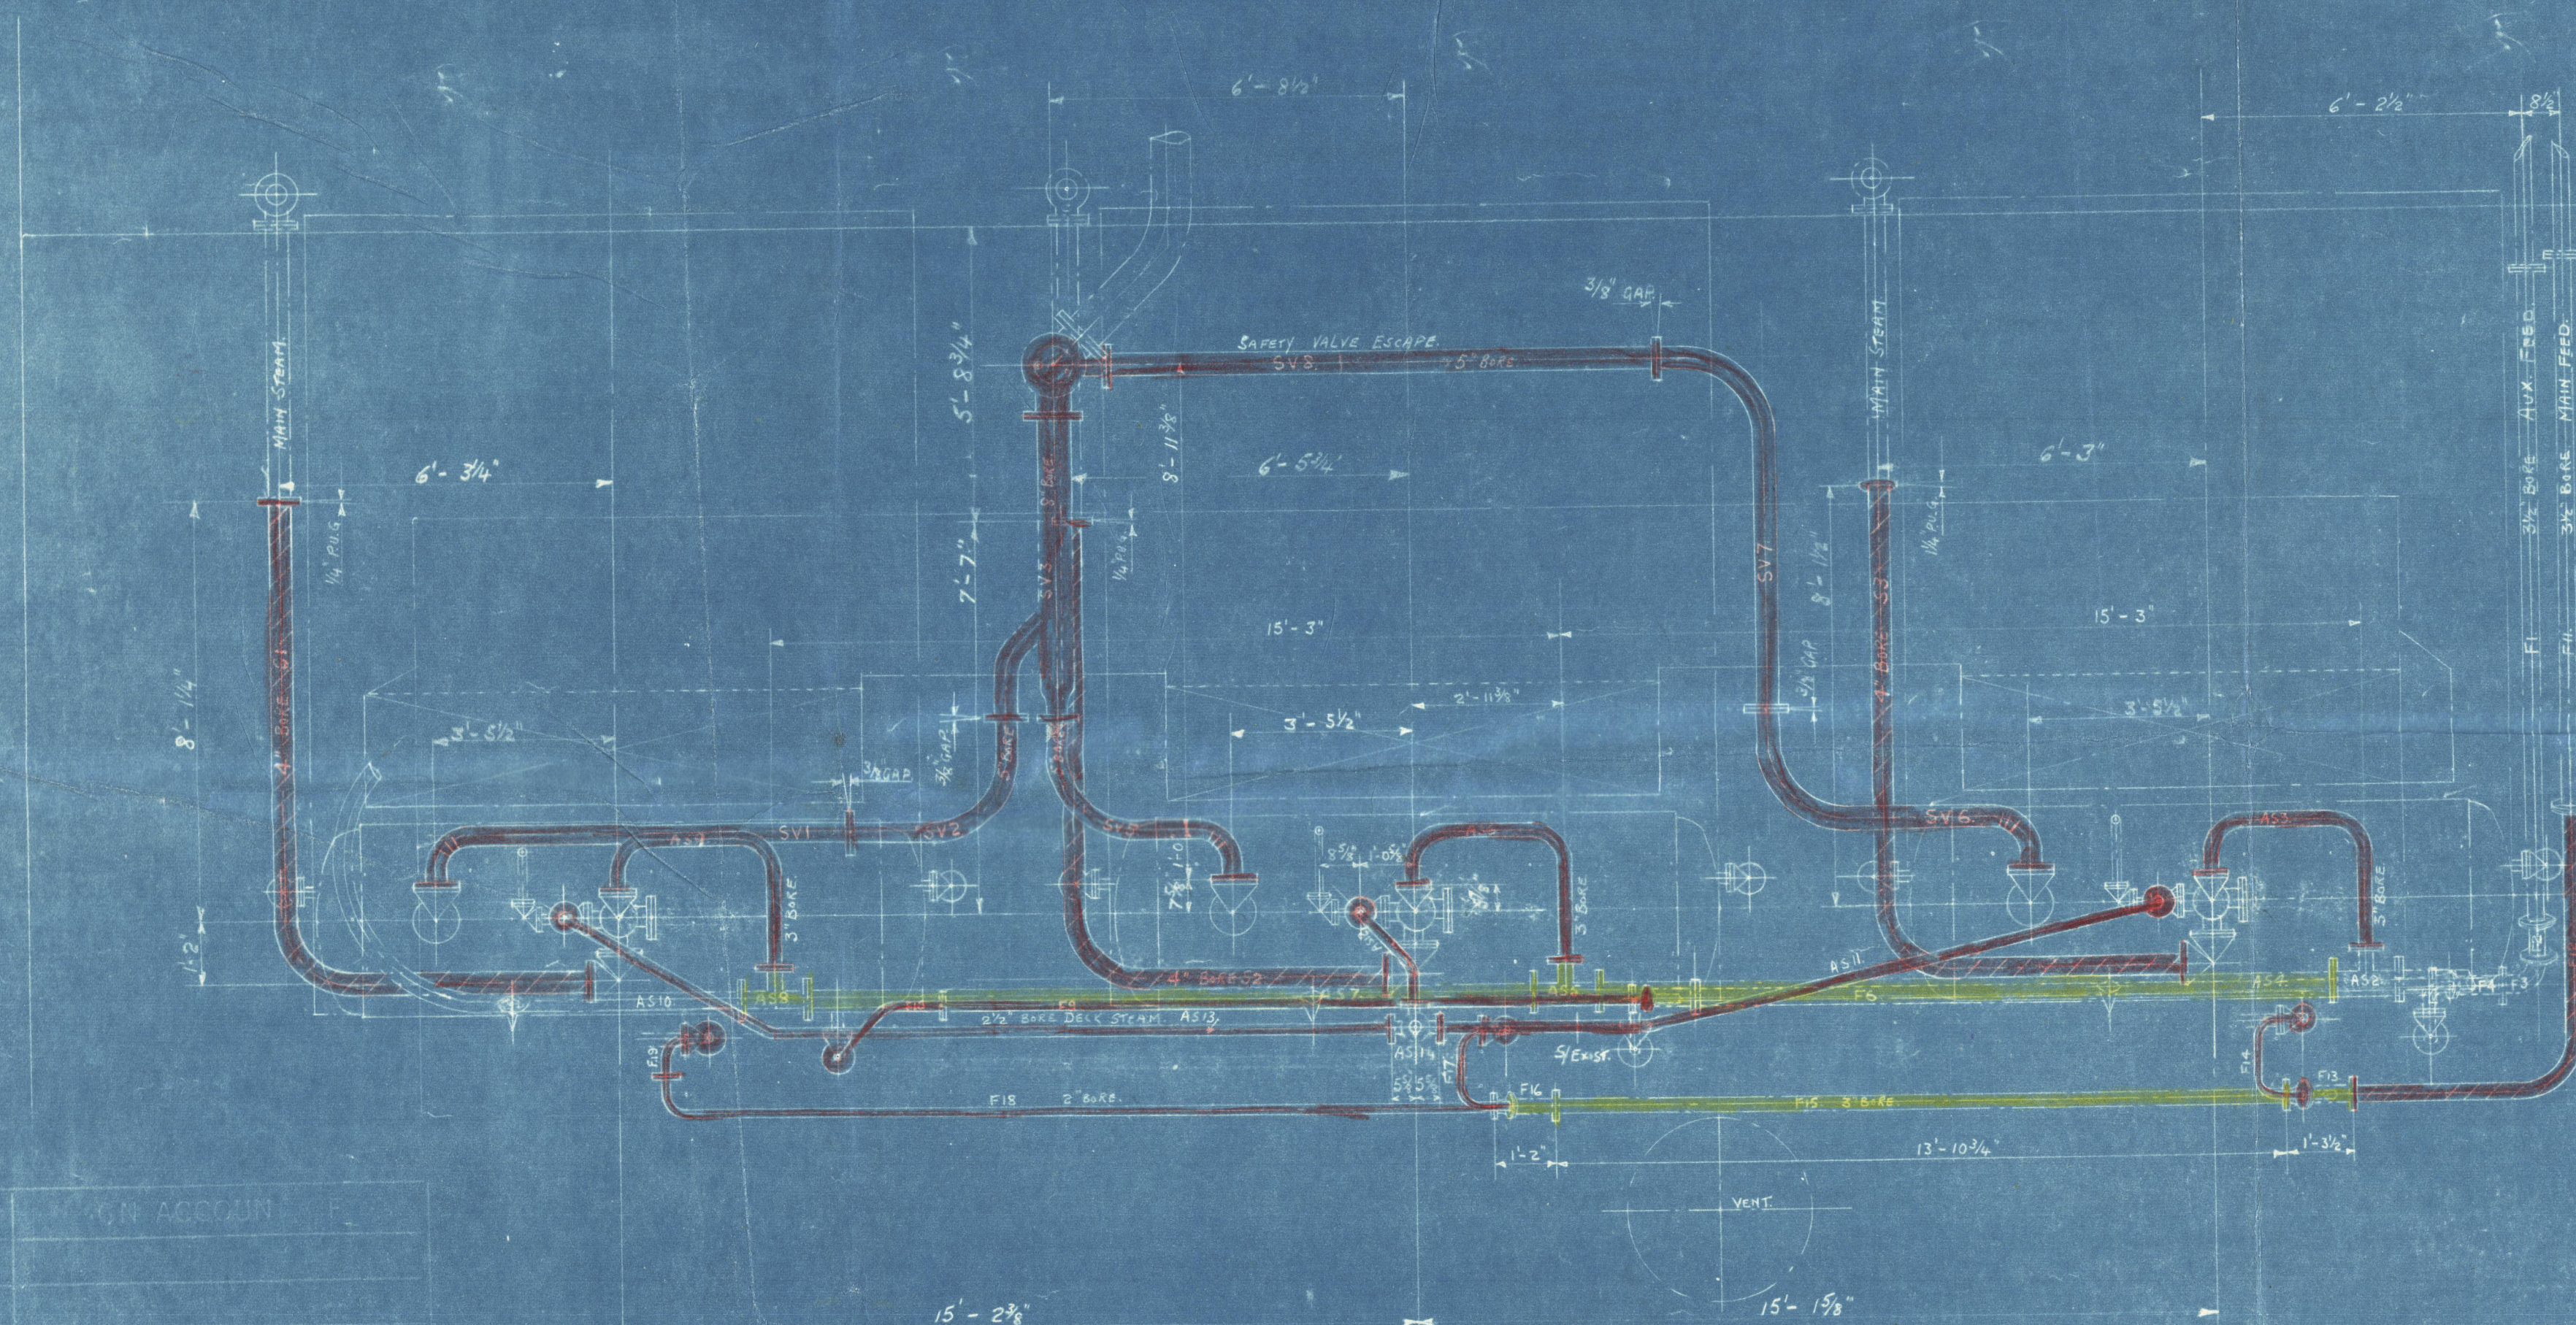

PLAN.


NOTE:

- TEMPLATE PIPES INDICATED THUS: [Symbol]
- LOOSE FLANGE FOR WELDING ON INDICATED: [Symbol]
- EXISTING PIPING SHOWN CHAIN DOTTED: [Symbol]

THIS DESIGN IS THE PROPERTY
OF BABCOCK & WILCOX LTD. AND IS
ONLY ALLOWED TO BE USED BY
EXPRESS PERMISSION & LICENSE
FROM BABCOCK & WILCOX LTD.

DRAWN J. MACDONALD
TRACED
CHECKED
PAID

SIDE ELEVATION

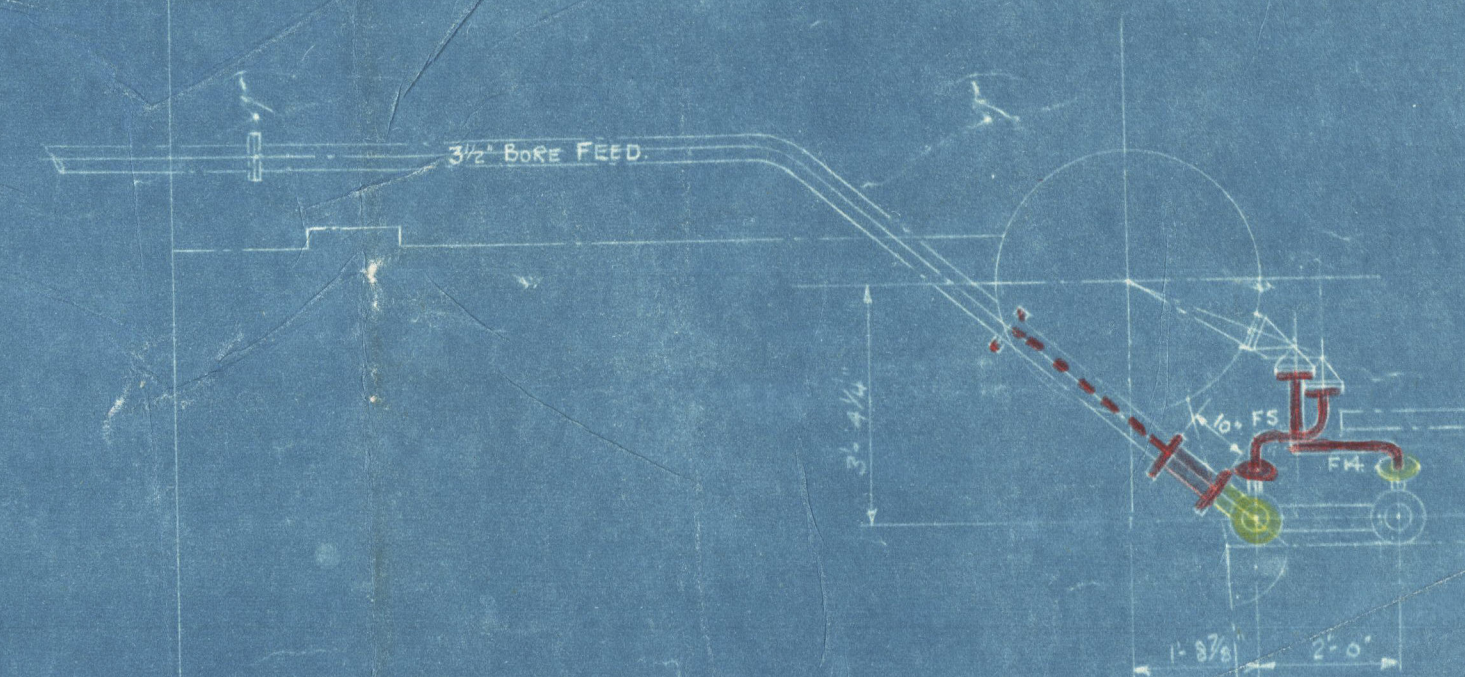

APPROVED
LLOYD'S REGISTER OF SHIPPING
J. R. Beveridge
DATE 17/8/41

BABCOCK & WILCOX LTD. RENFREW
CONTRACT 5/1458
SCALE 3/8" = 1 FOOT
DRG. N° PW. 1458/119.

(4)

Babcock & Wilcox Ltd

6/1458

Boiler Room Piping

Empire Tarpon

GLASGOW REPORT No. 64433

W34- 0107



© 2020

Lloyd's Register
Foundation