


SCALE  $\frac{1}{8}$  INCH = 1 FOOT.

MAST OF STEEL, DOUBLED AS SHOWN. BUTT LAPS DOUBLE RIVETED.  
LANDINGS  $2\frac{1}{4}$ " SINGLE  $\frac{5}{8}$ " RIVETS SPACED  $3\frac{1}{8}$ " CENTRE TO CENTRE.

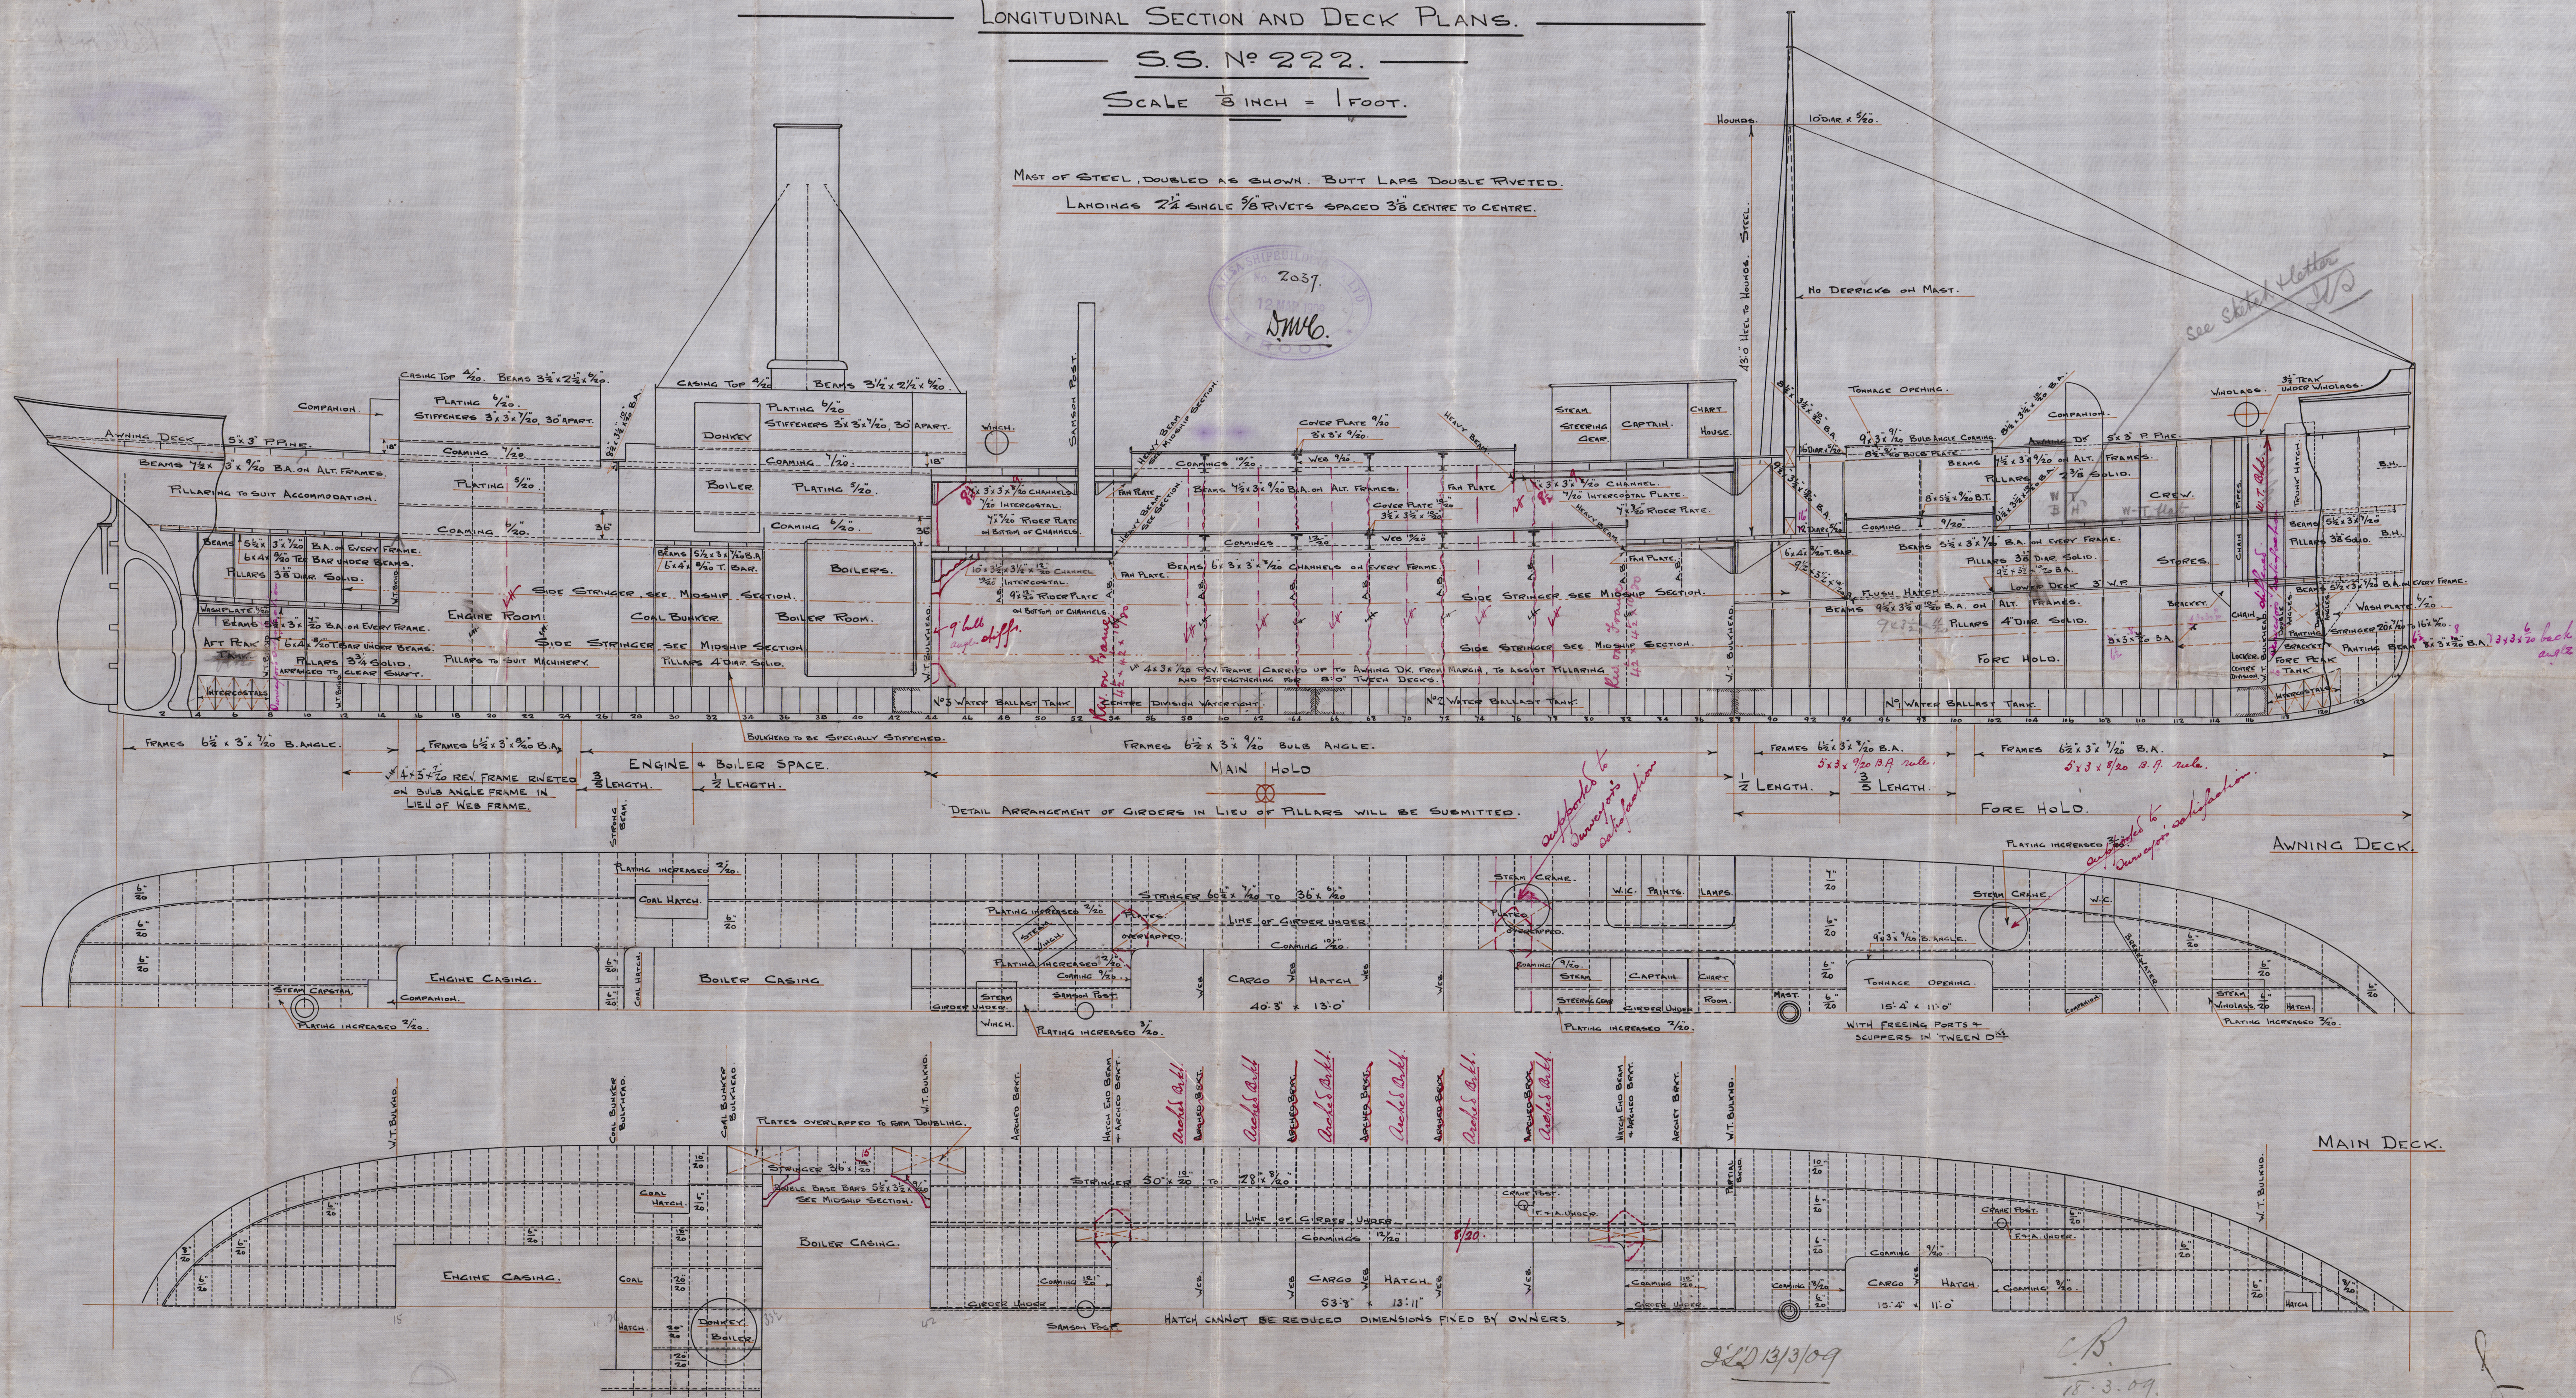

220 13/3/09


C.B.  
18.3.09



Profile & Decks  
Airm. Sh. Coys 222  
J.B. Laverock.

Glasgow Report  
N<sup>o</sup> 28153.

n/n "Bellerock."

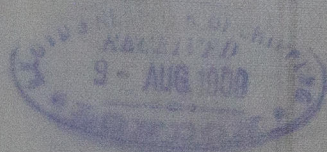


W340-0024



© 2020

Lloyd's Register  
Foundation



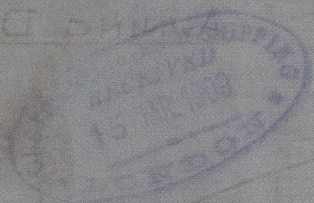

© 2020

W340-0024

Lloyd's Register  
Foundation