


SPACE TO BE
WELL VENTILATED
& EASY OF ACCESS

LED TO OPEN
ABOVE UPPER DECK

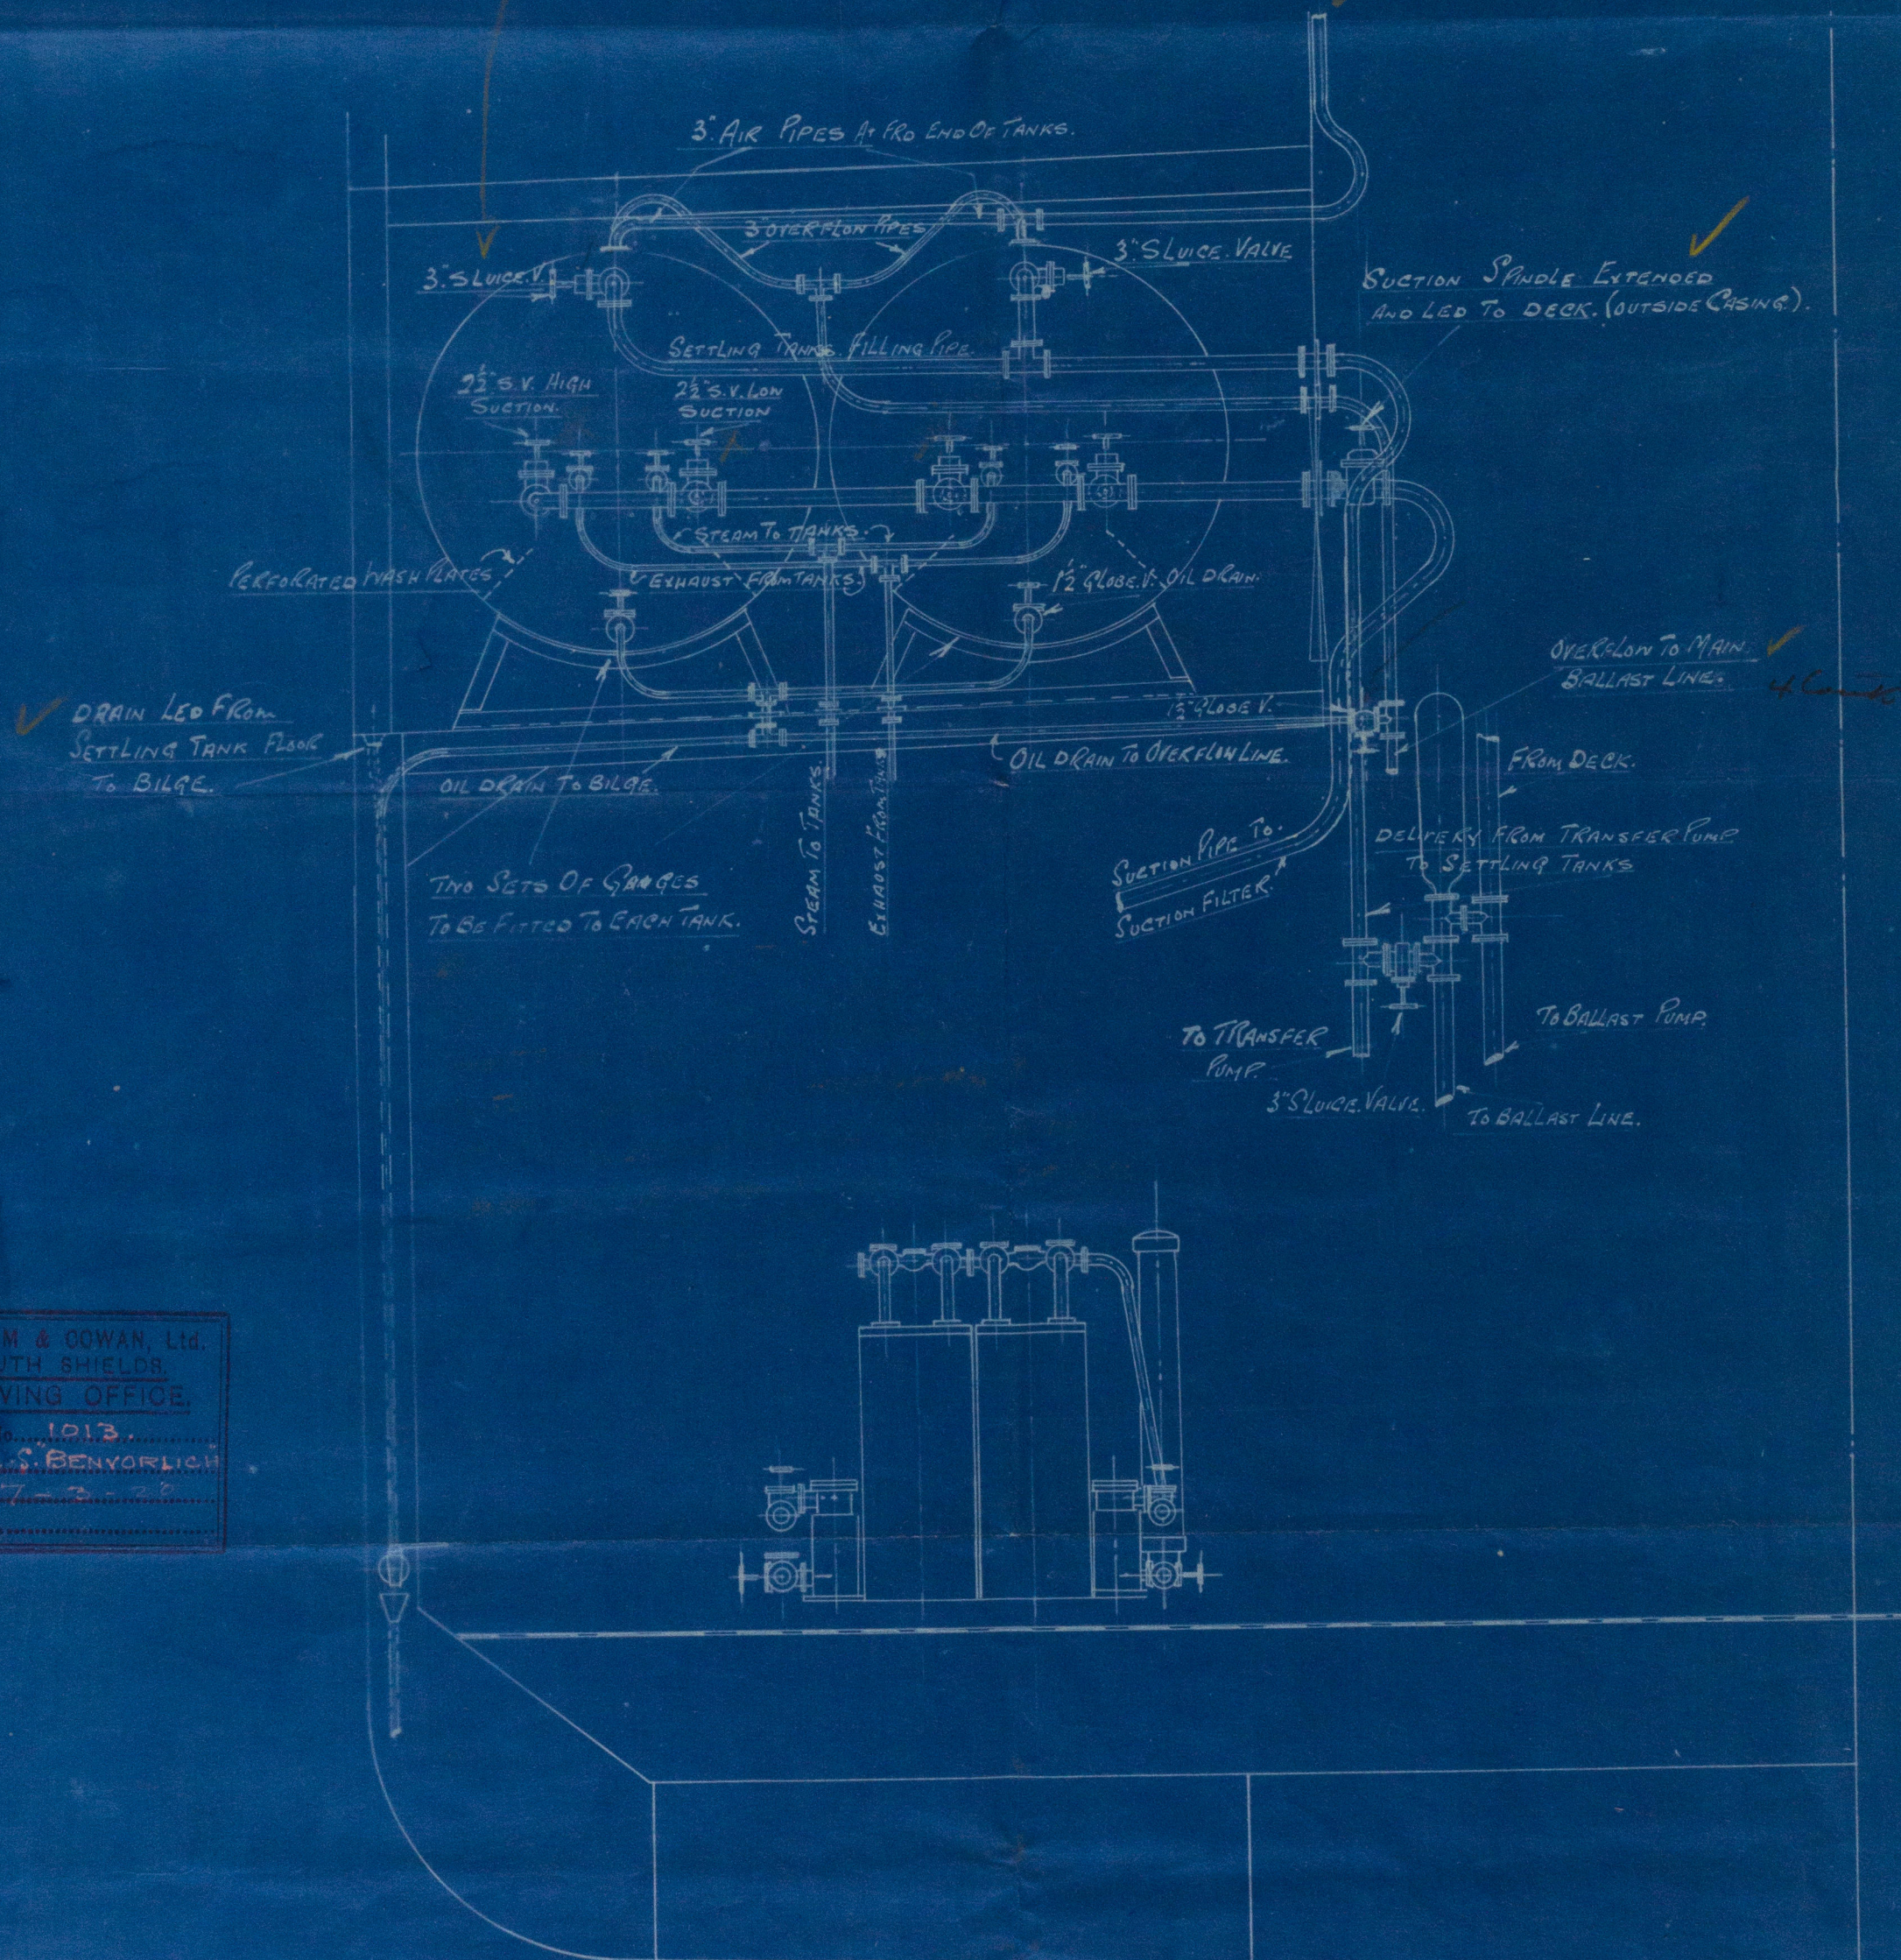

BRIGHAM & COWAN, Ltd.
SOUTH SHIELDS
DRAWING OFFICE
DRAWING No. 1013
CONTRACTOR S. BENYORLICH
DATE 17-2-26

SECTION OF PORT SIDE AT FRAME N° 72. LOOKING PRO.

FLY TO DRAWING N° 1013.

S/S. BENYORLICH



343-0042

W. Hall

S.S. "BENVORLICH"

Len. 82941.

RETAIN



© 2020

Lloyd's Register
Foundation

W343-0042