


3.11.06




PLAN VIEW ON SHELTER DECK

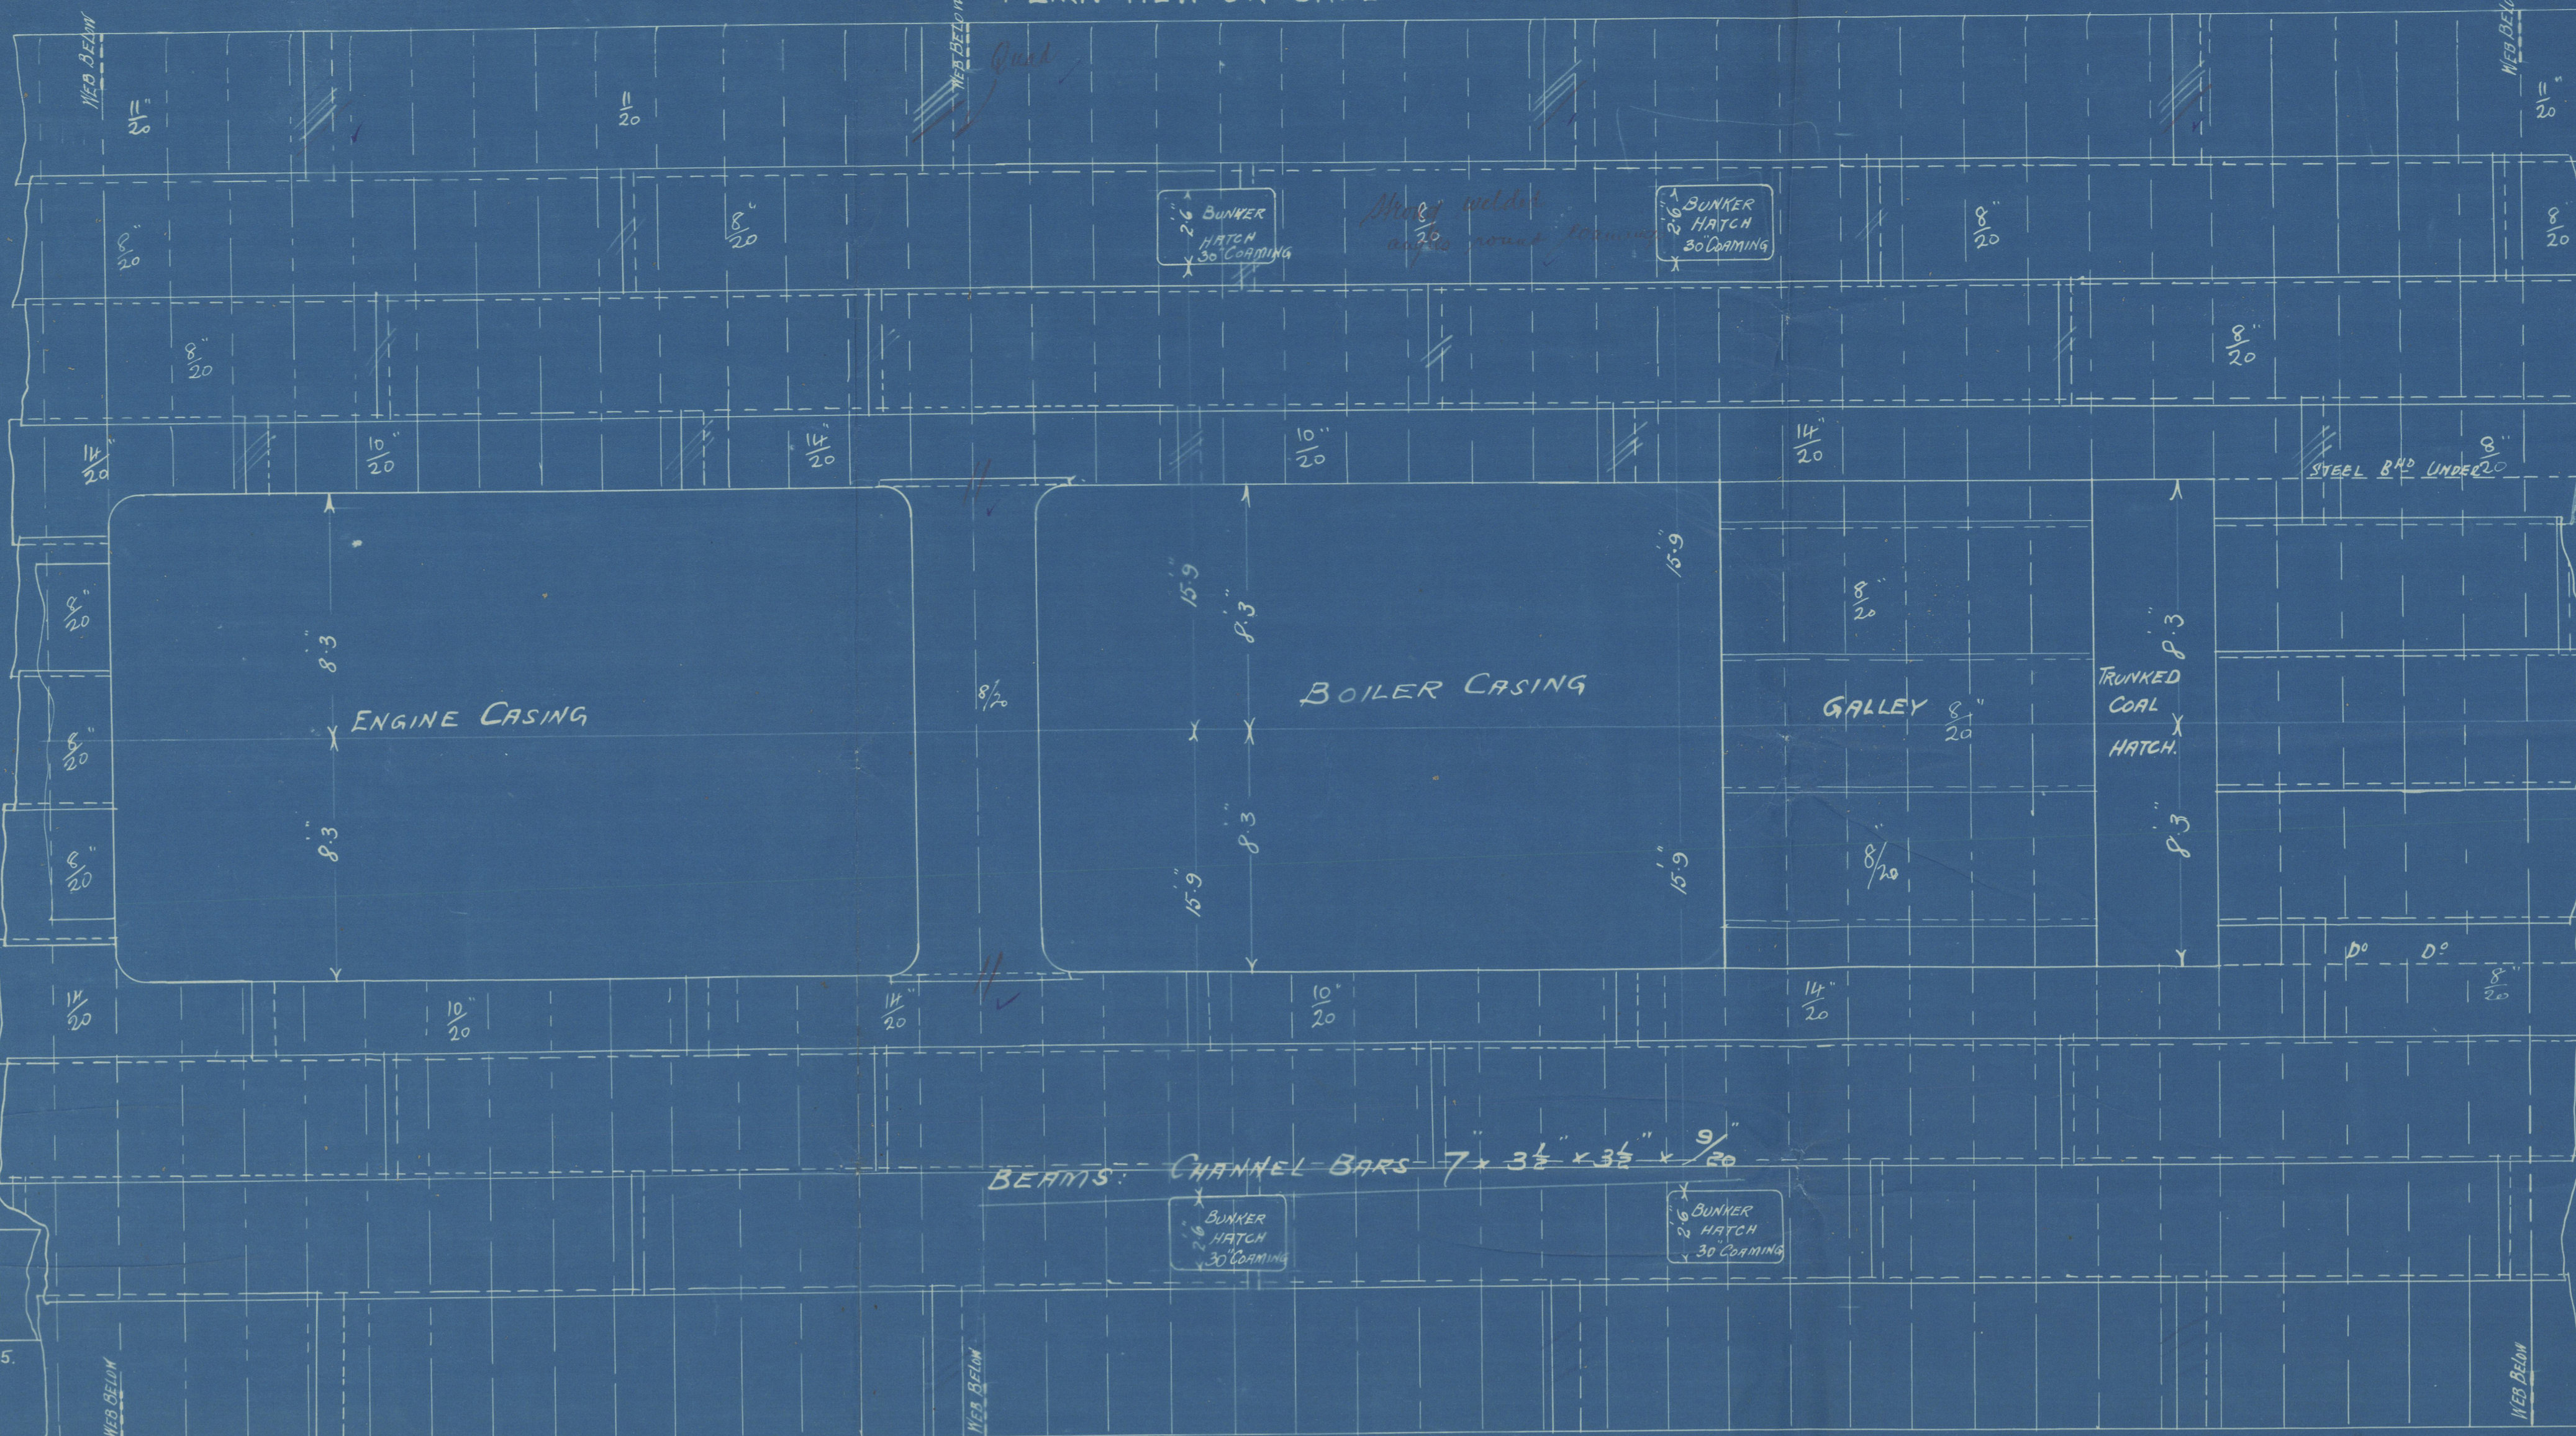


PLAN SHOWING BUNKERS & STRONG BEAMS, IN ENGINE & BOILER ROOMS.

S.S. Nos. 490-1.

SCALE, (EXCEPT WHERE MARKED OTHERWISE) 1/4" = 1 FOOT.

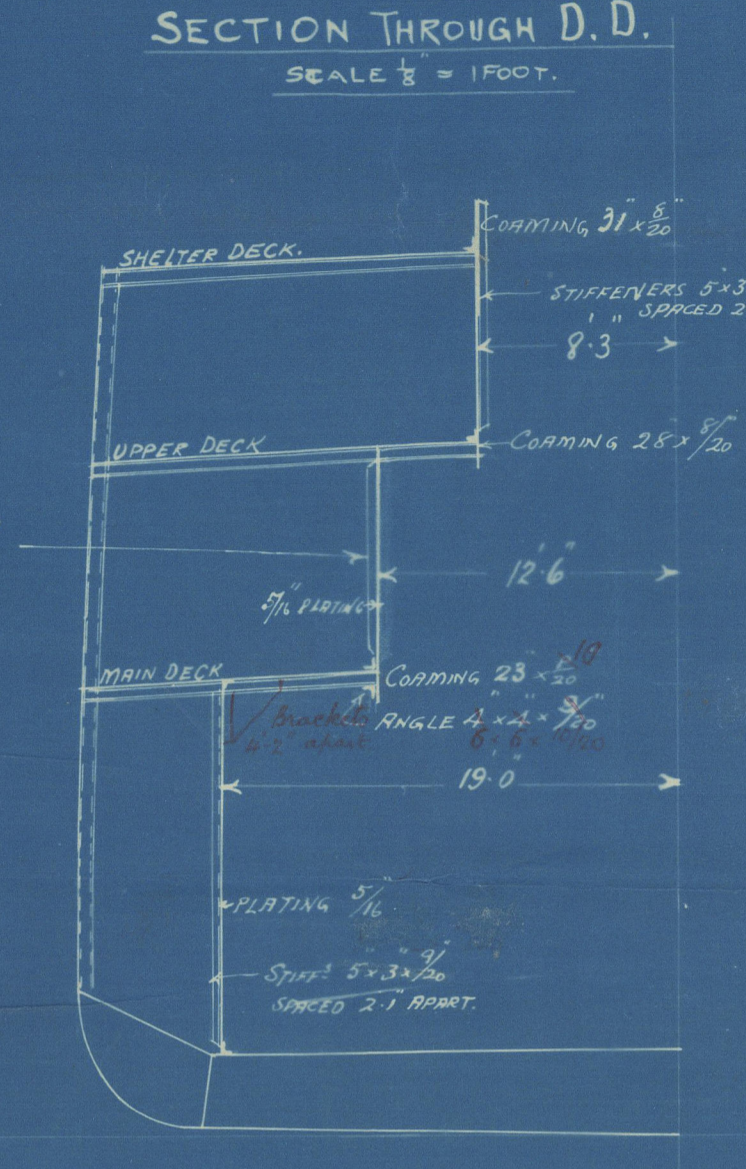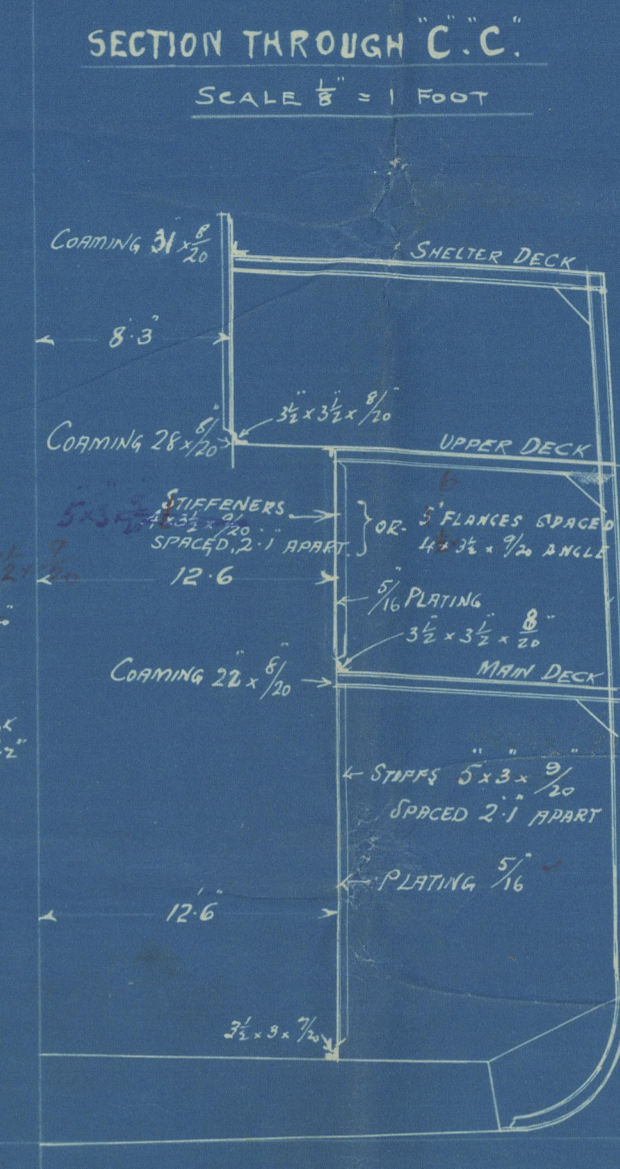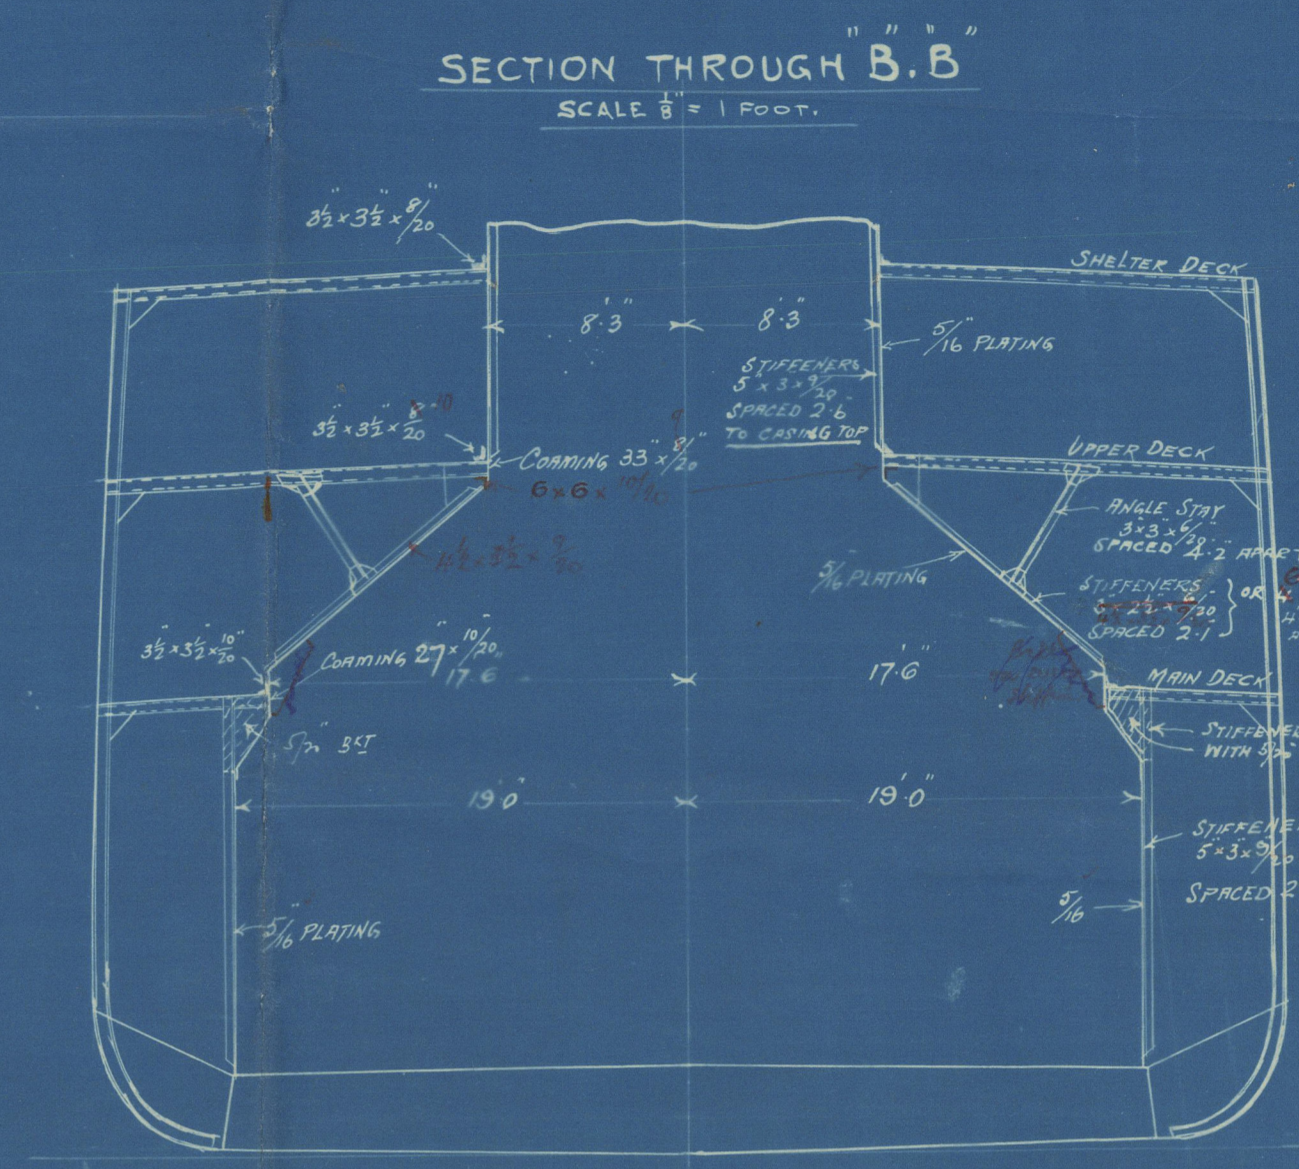

SECTION THROUGH A.A.

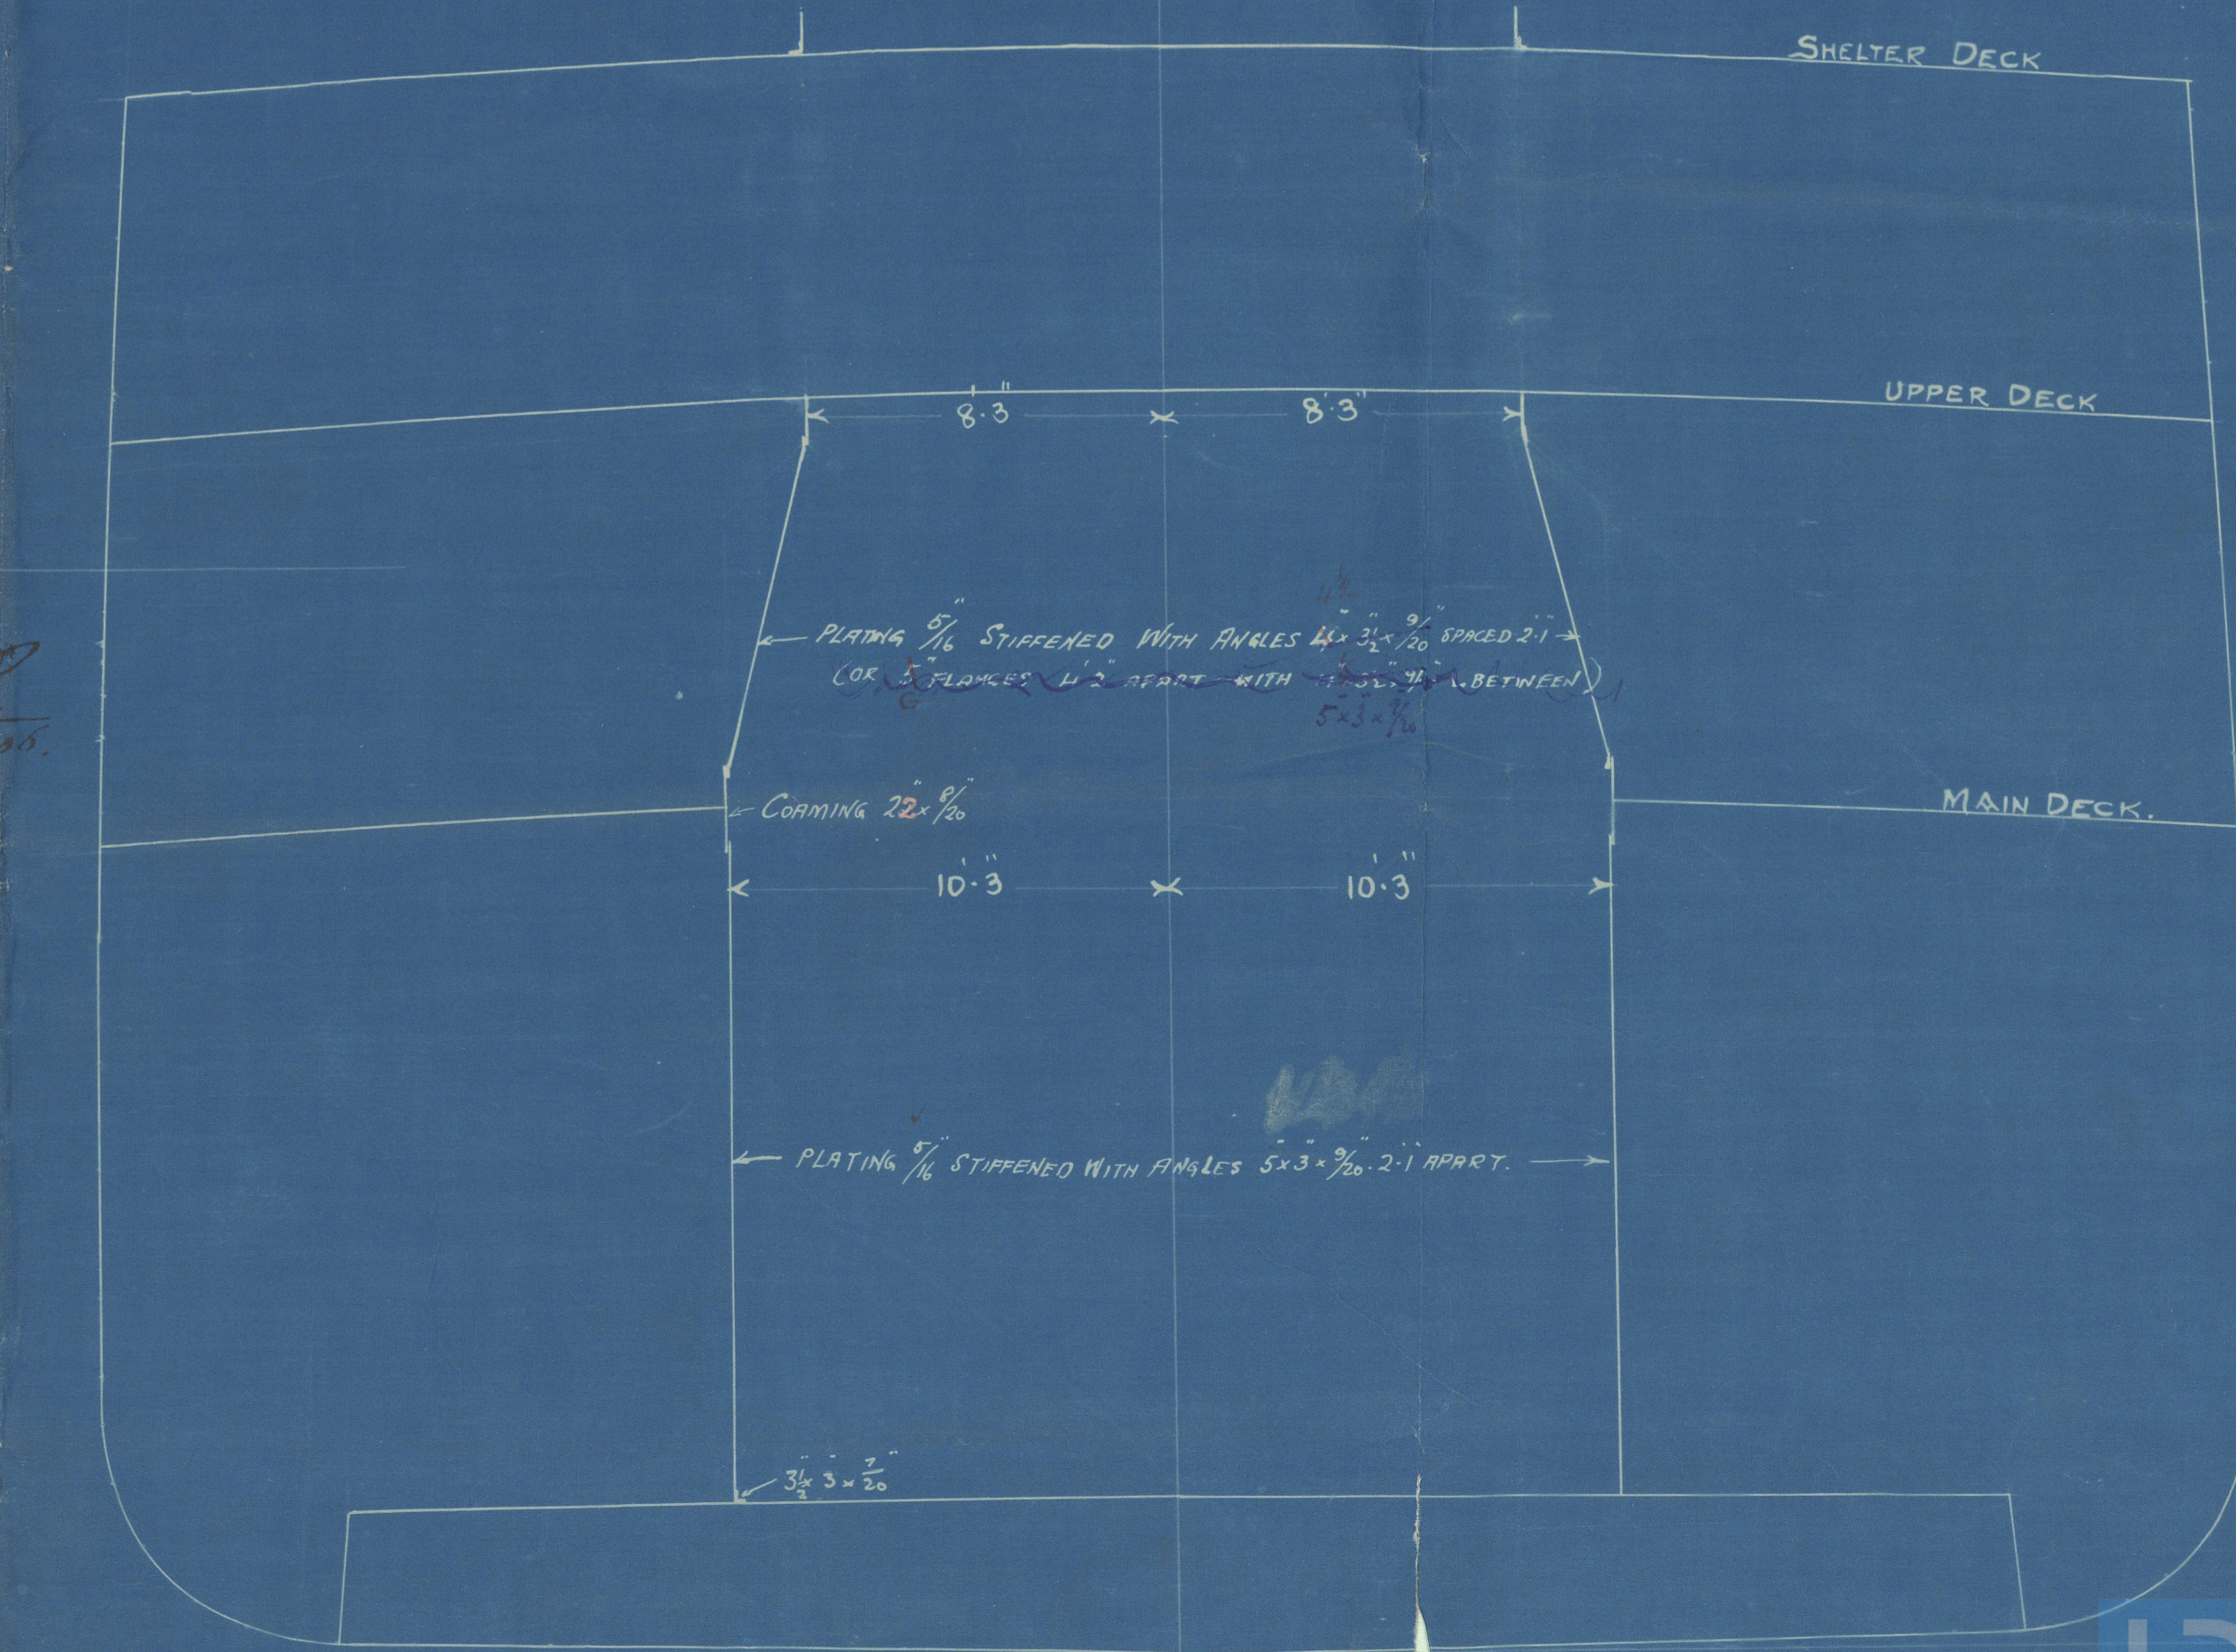


PLAN VIEW ON MAIN DECK

PLAN VIEW ON UPPER DECK

Bunkers & Strong beams
Eng. & Ber room
Nos. 490/1


RETAIN

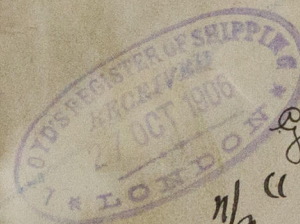

S/s "Huancaed."

Gen. Rpt. 1st

1/2 "BORE VIII"

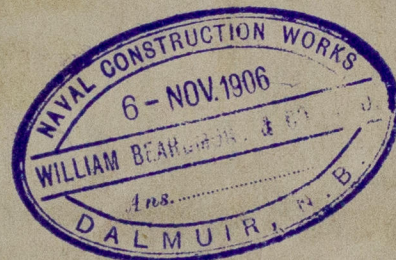

12 22 43

9-12 69-2

12 22 ✓
7 1
19 3 5
9-7 3/4



W344-0021



© 2020

Lloyd's Register
tion