

DETAILS OF DEEP GIRDERS & WIDE


SPACED PILLARS IN No 2 HOLD

3.11.06



S.S. No 490-1

SCALES 1/4" & 1" = ONE FOOT

ELEVATION

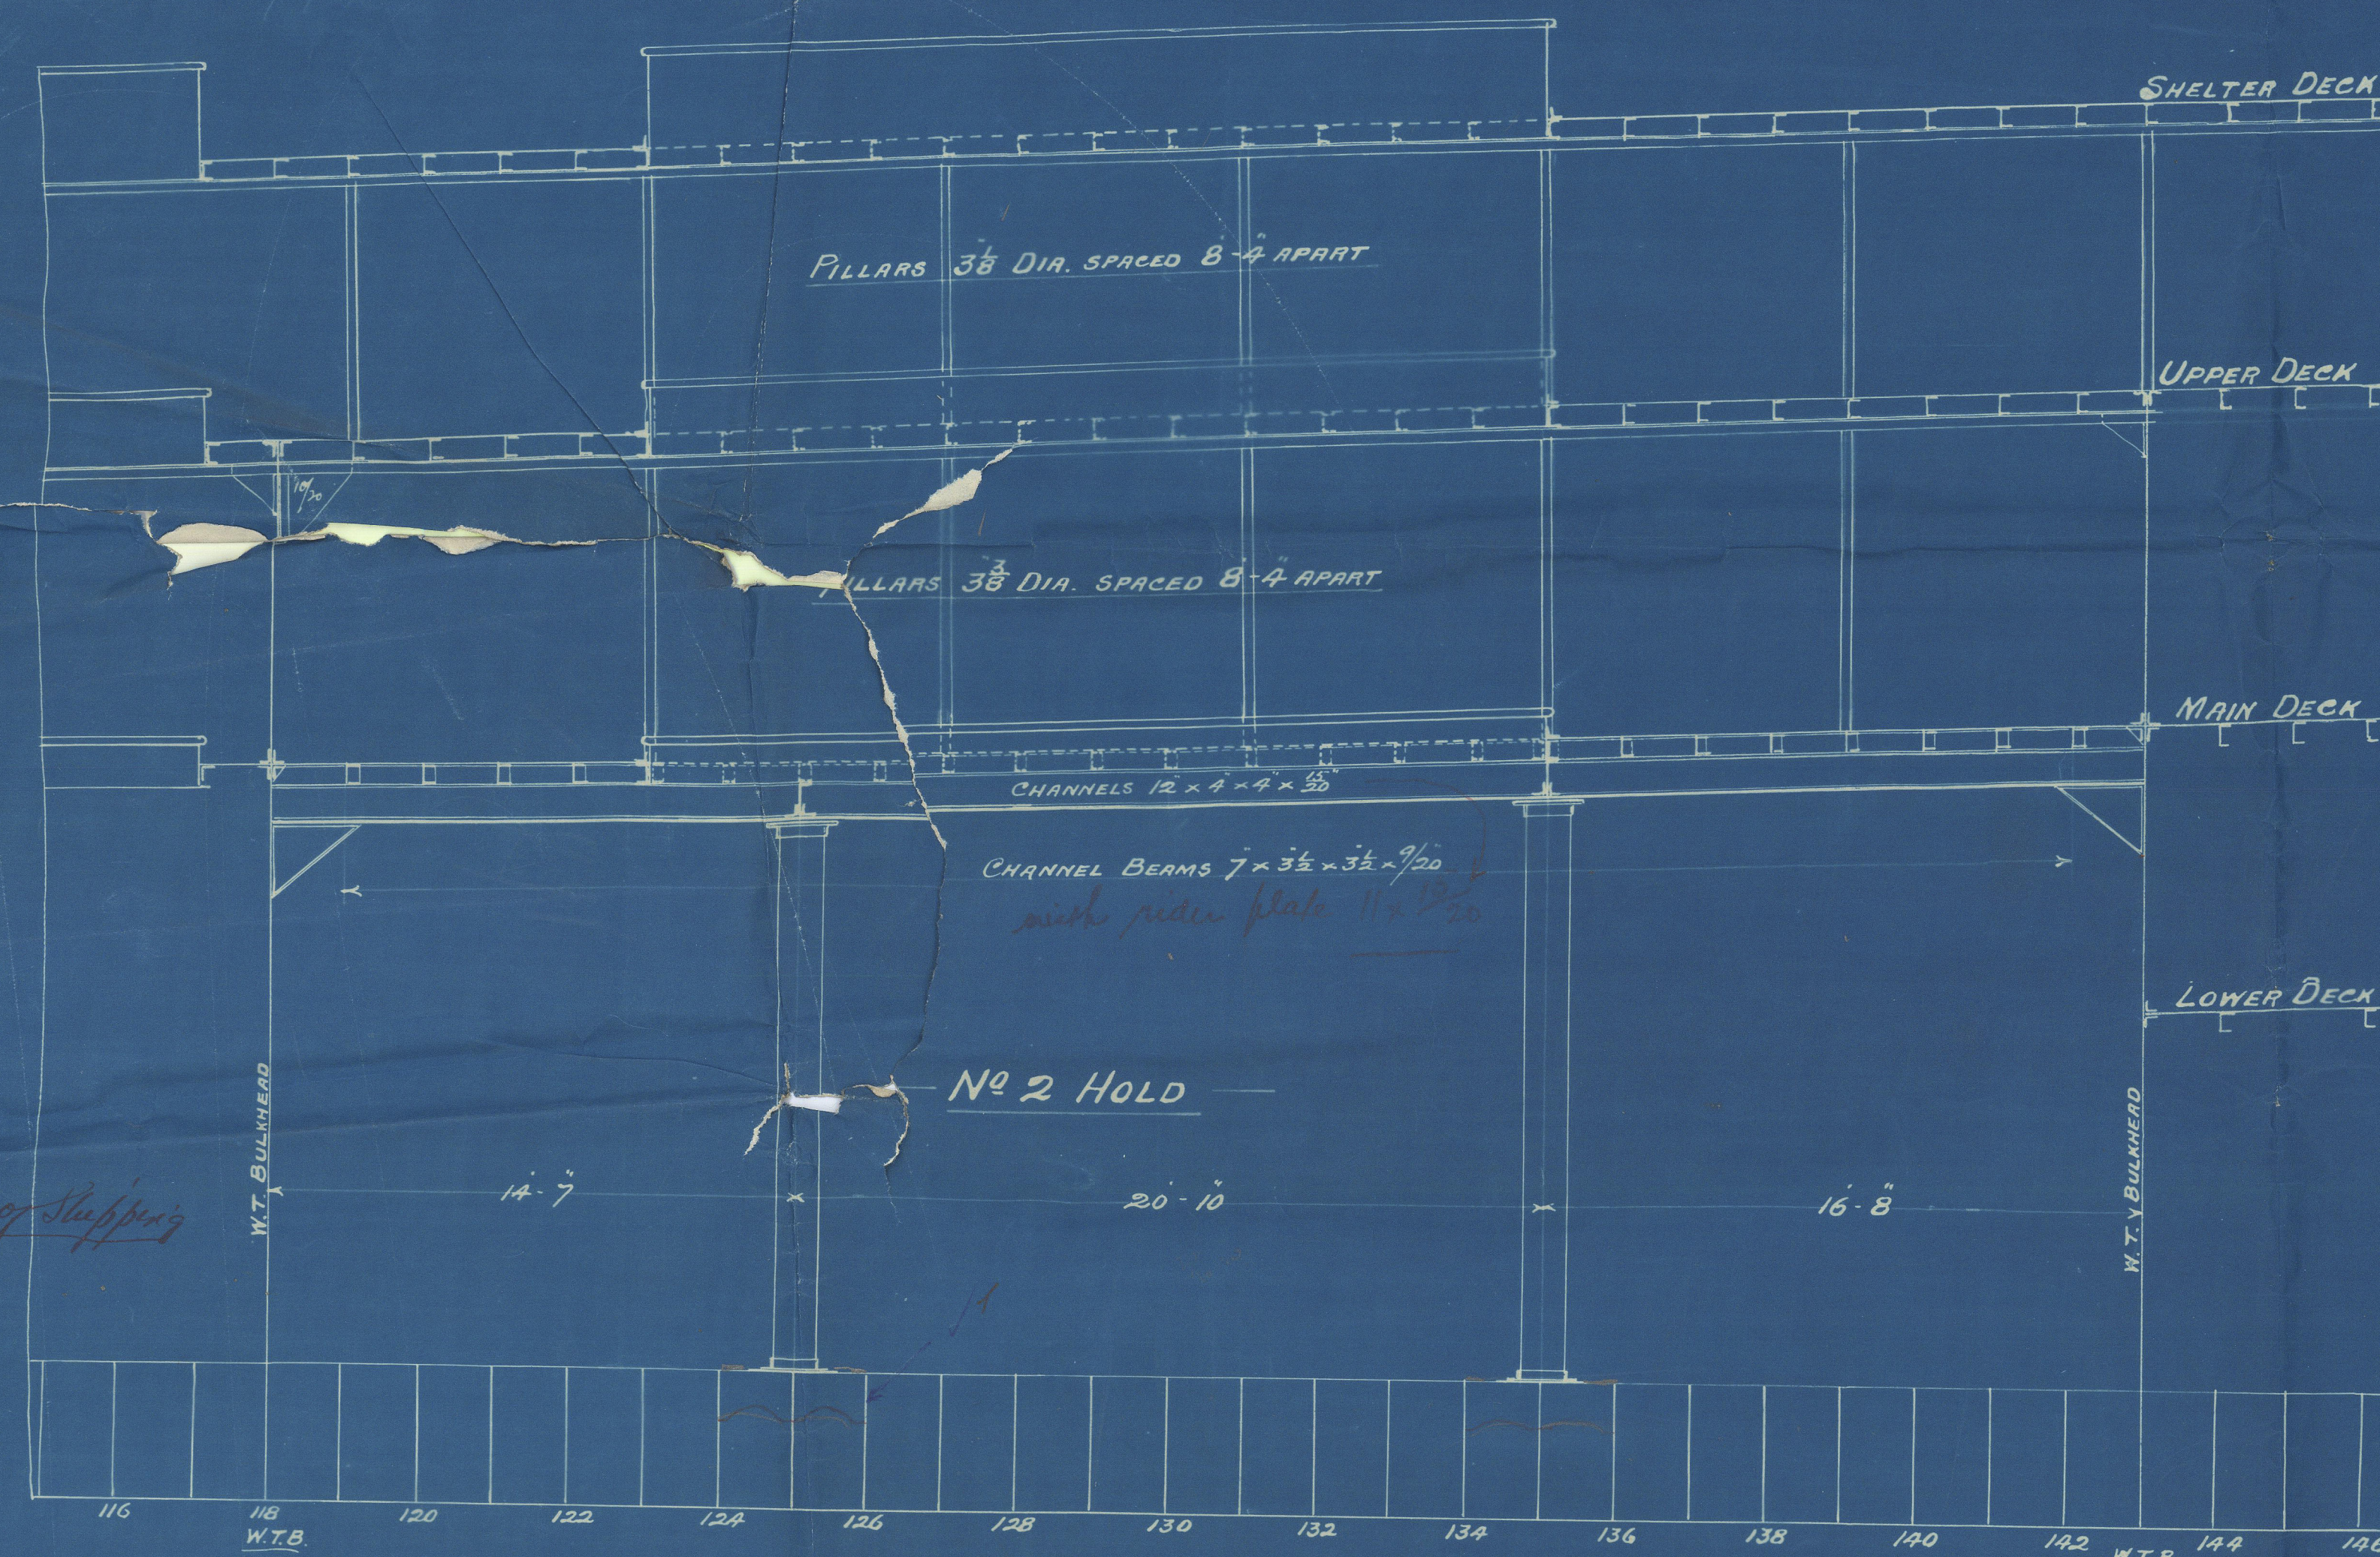


SECTION

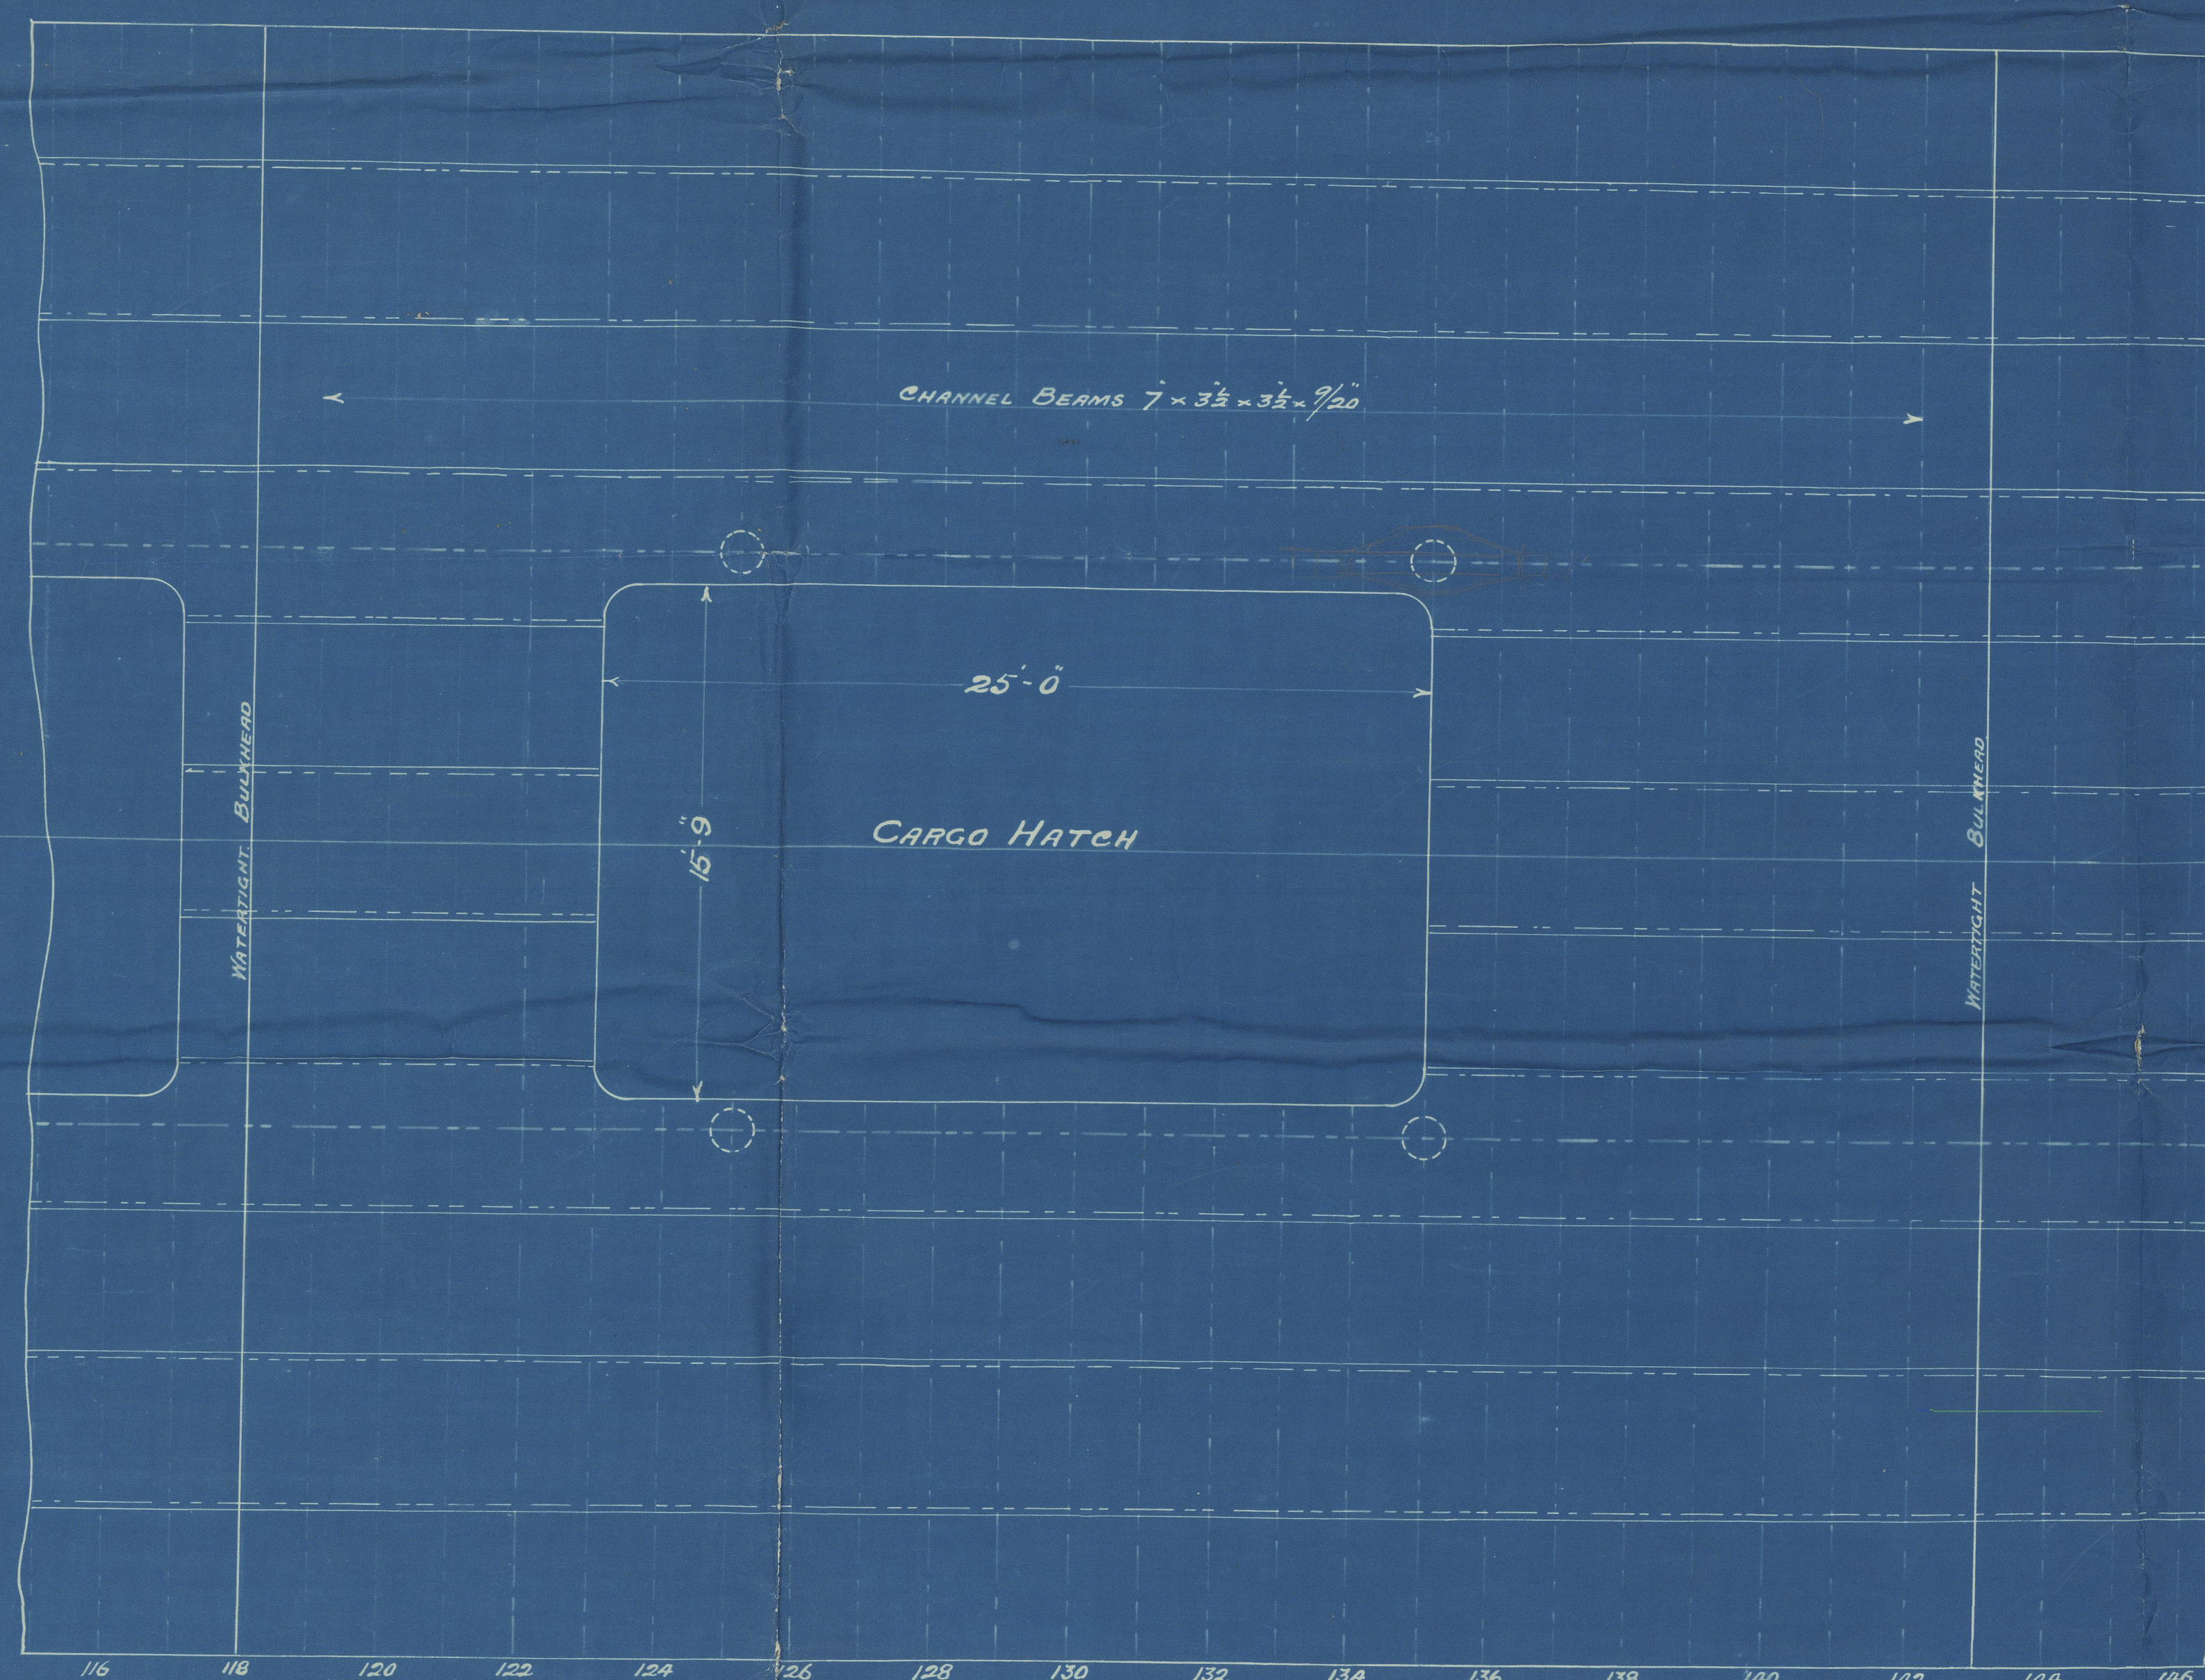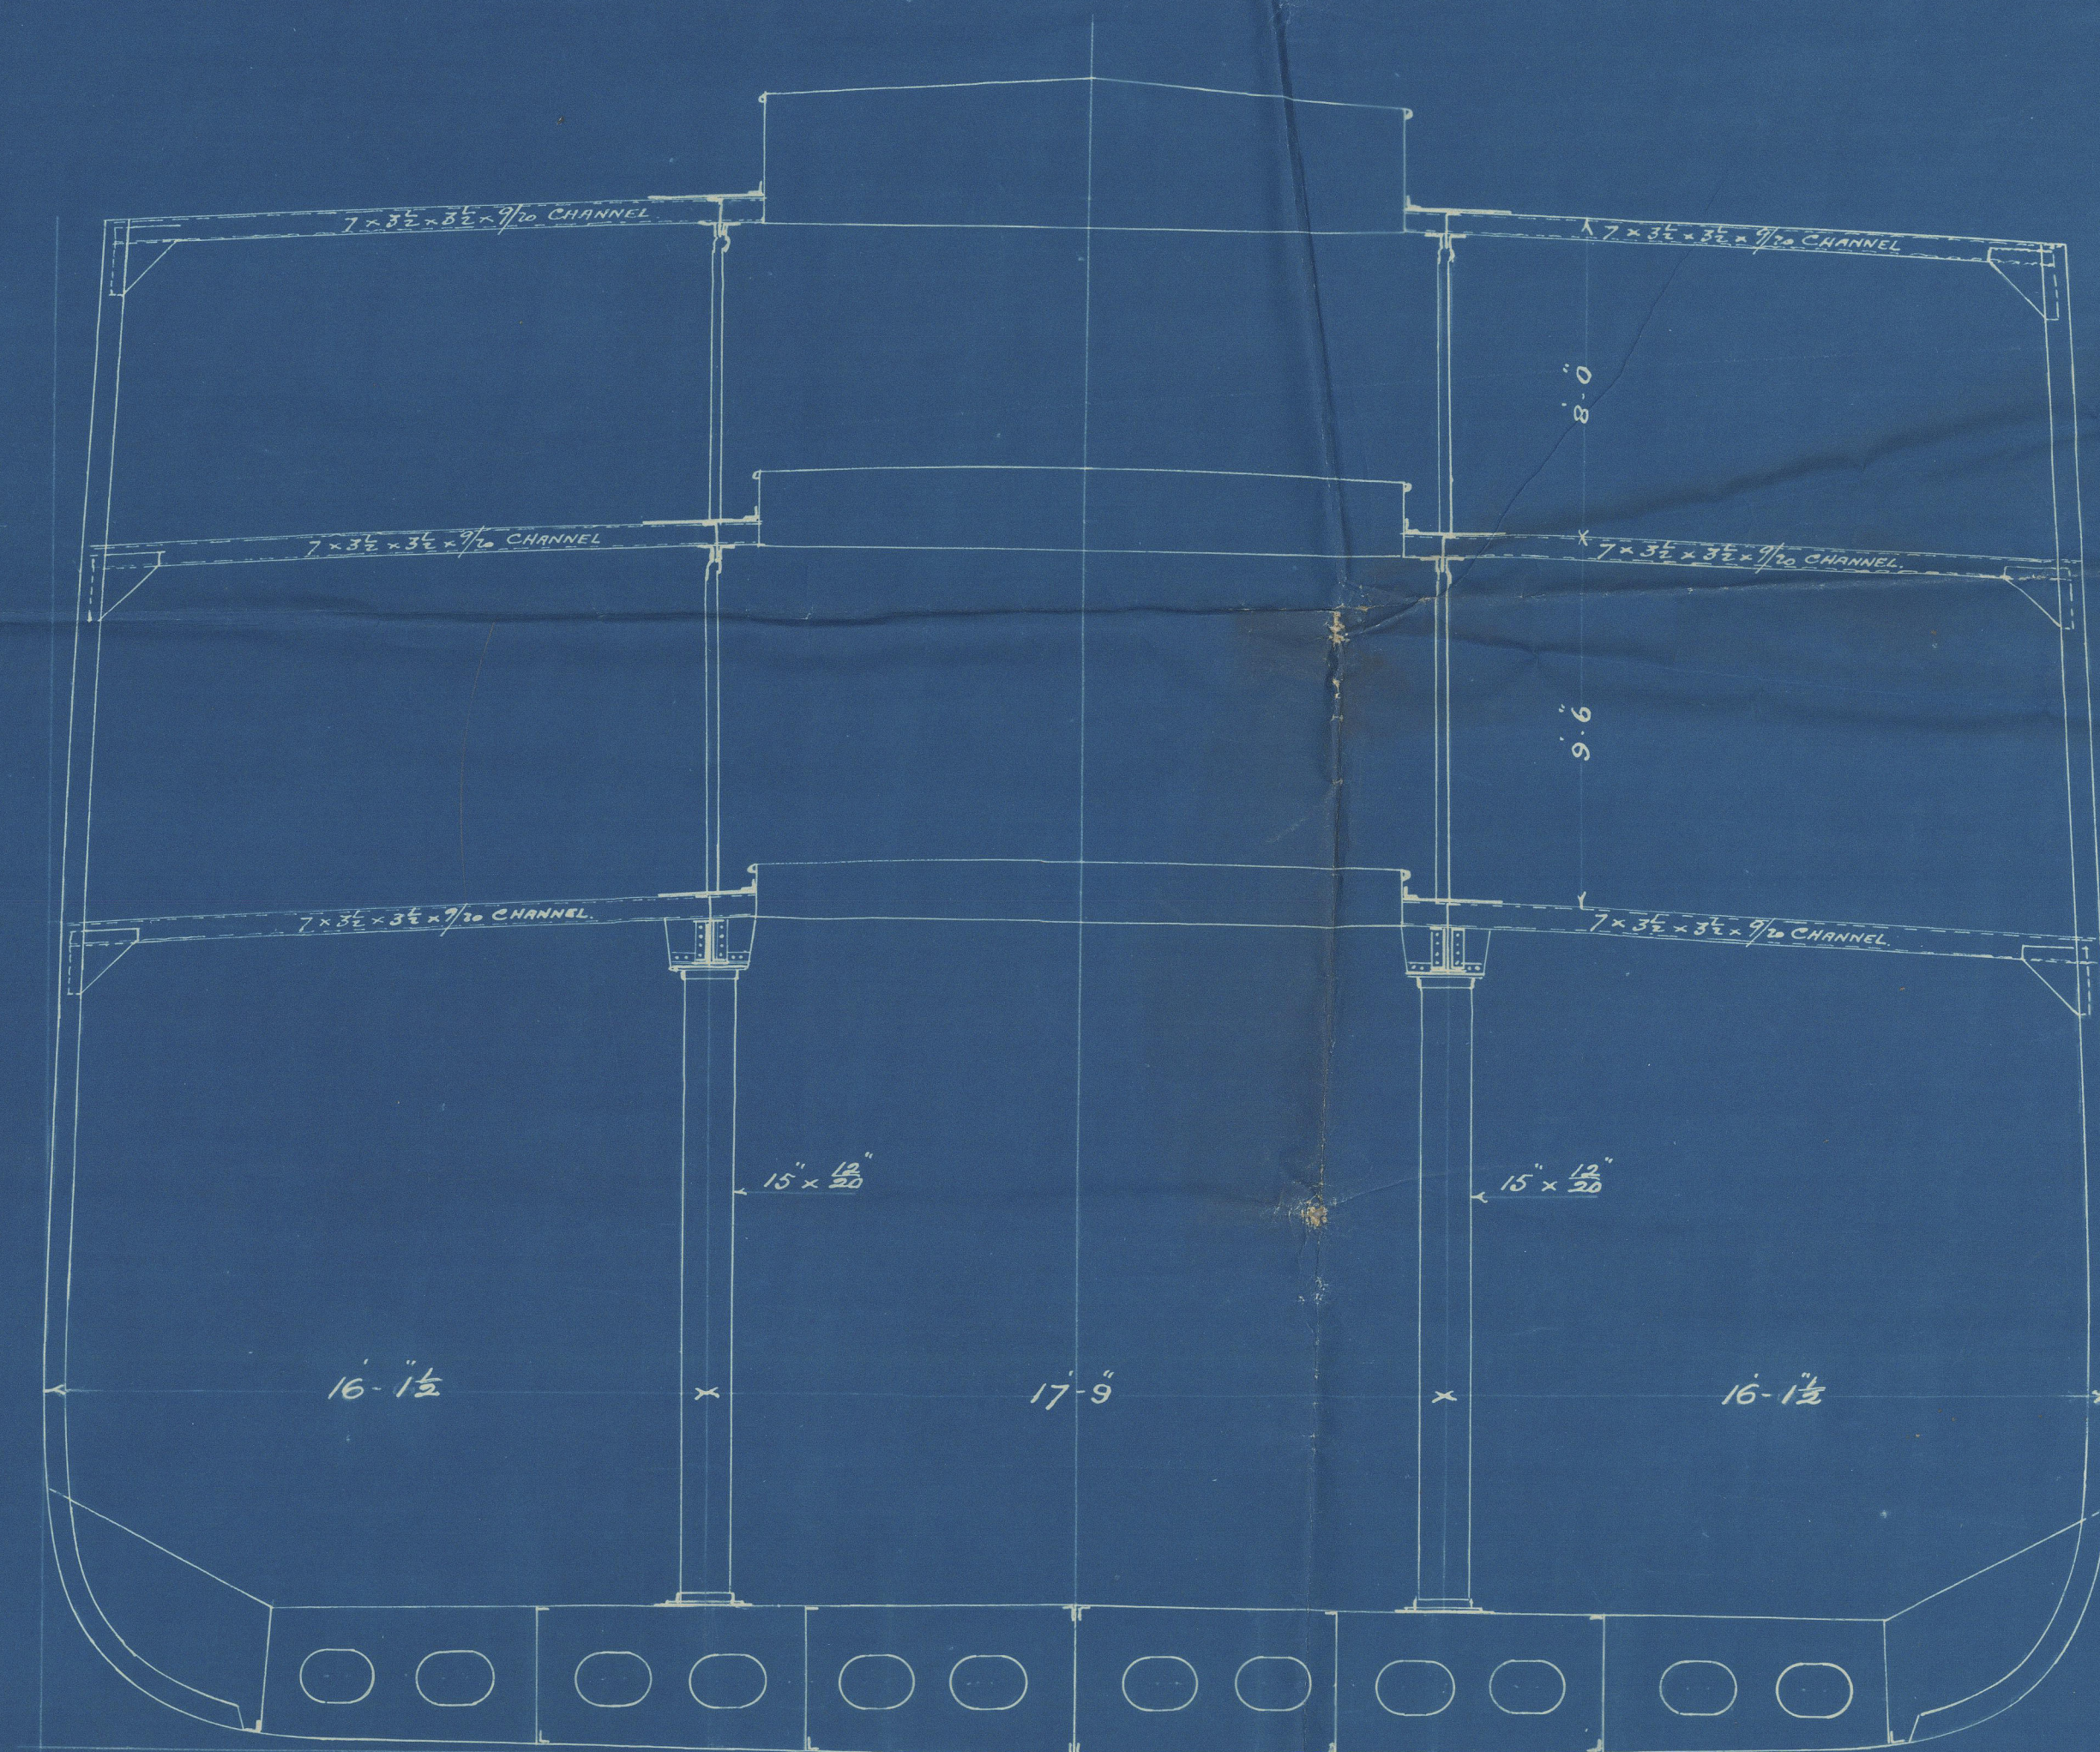


MAIN DECK PLAN


THWARTSHIP SECTION

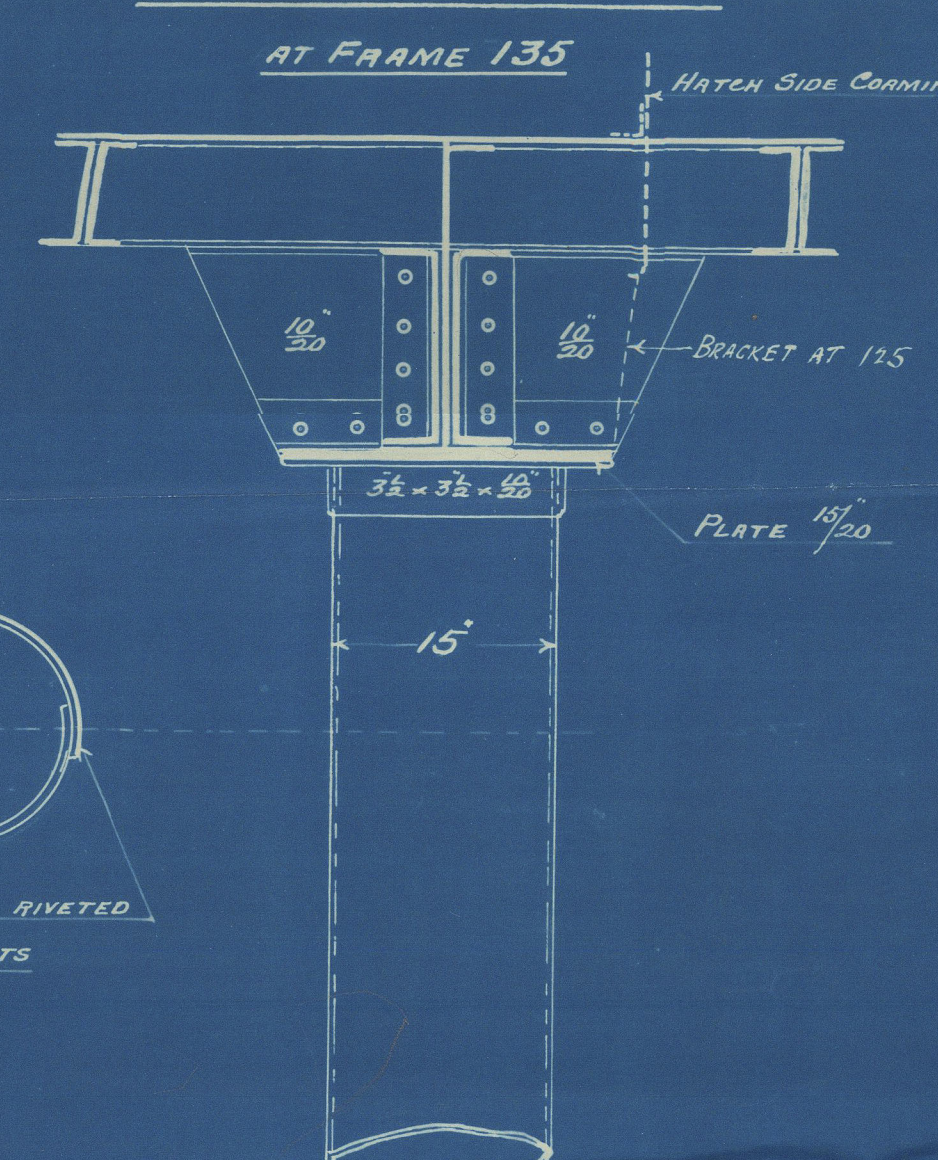


LONGITUDINAL SECTION

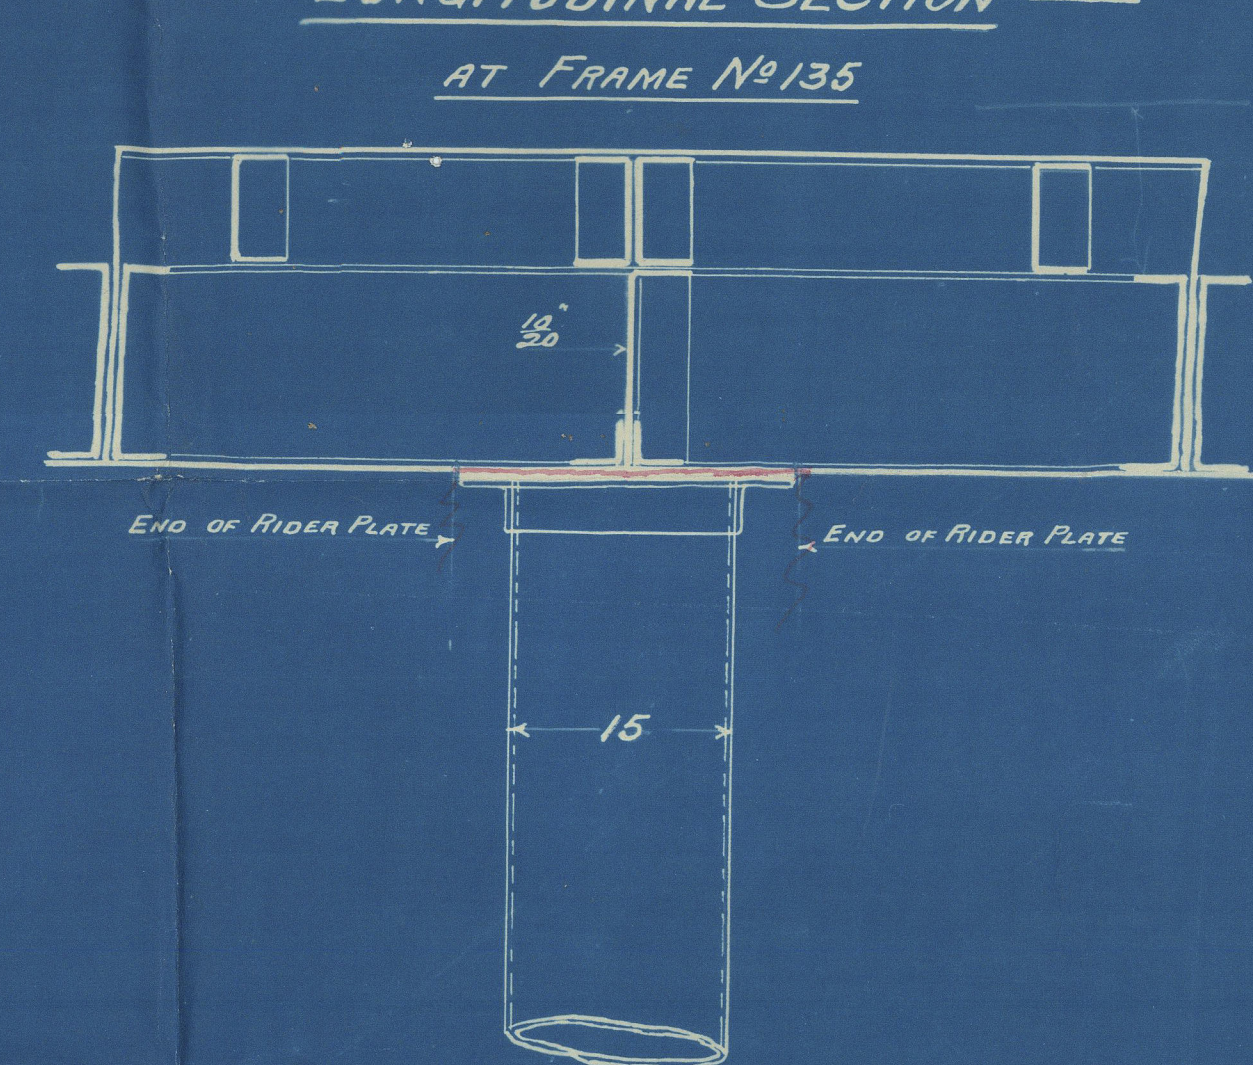

ELEVATION SHEWING CONNECTION OF GIRDER TO BULKHEAD

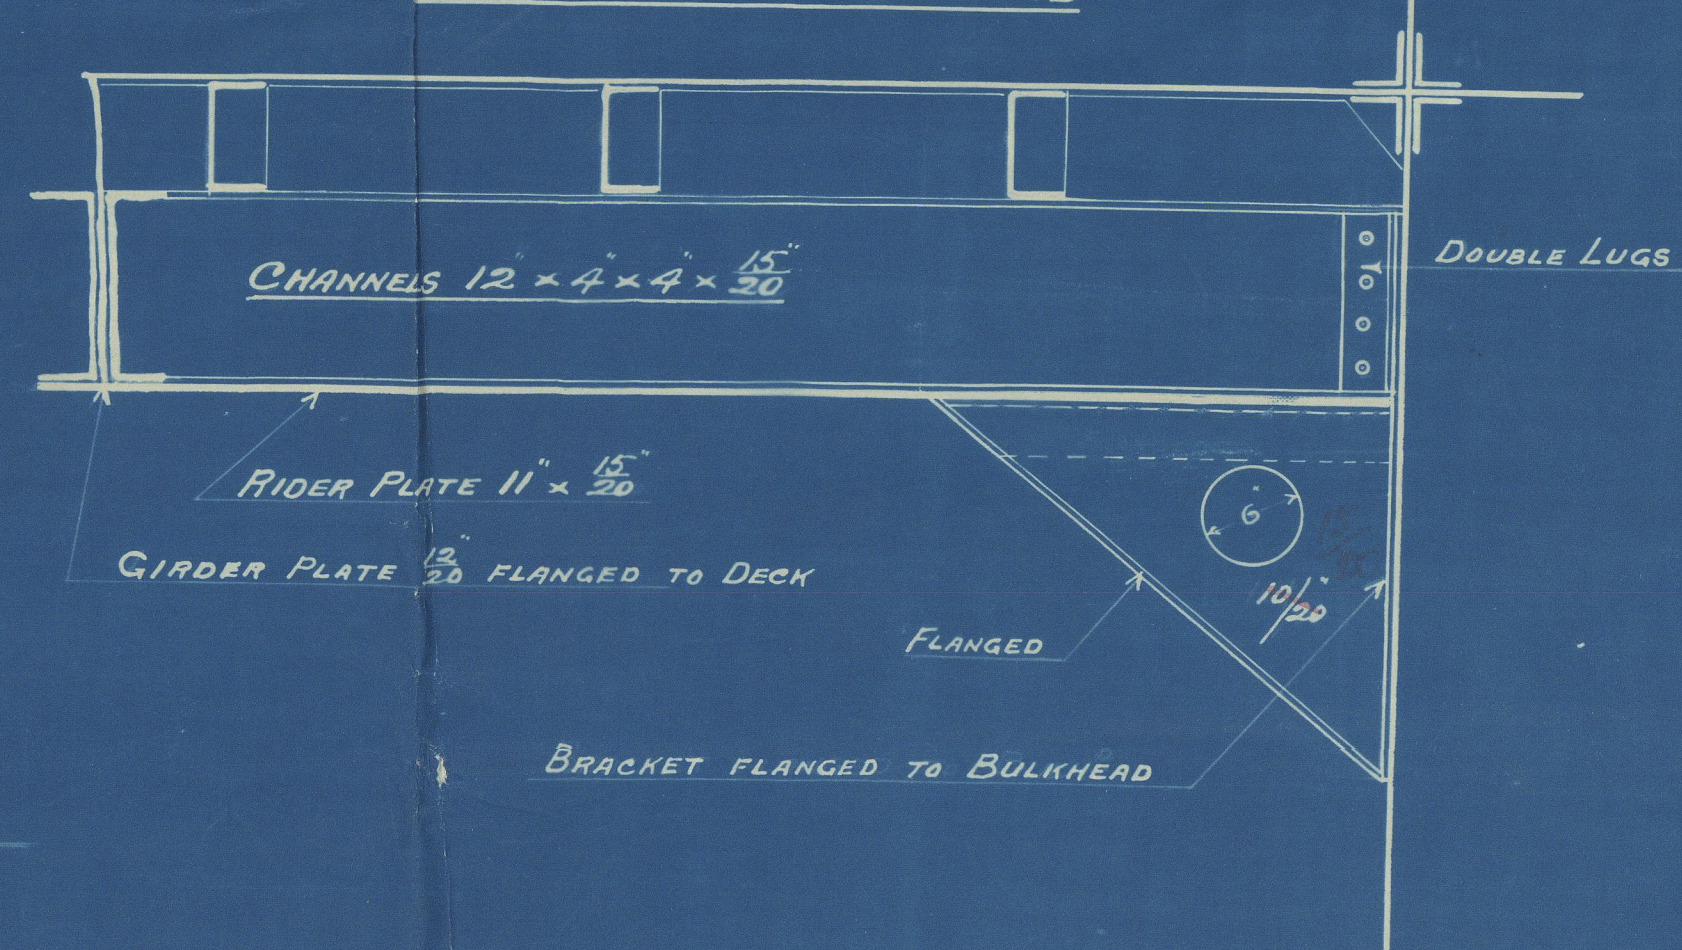

CR
3.11.06

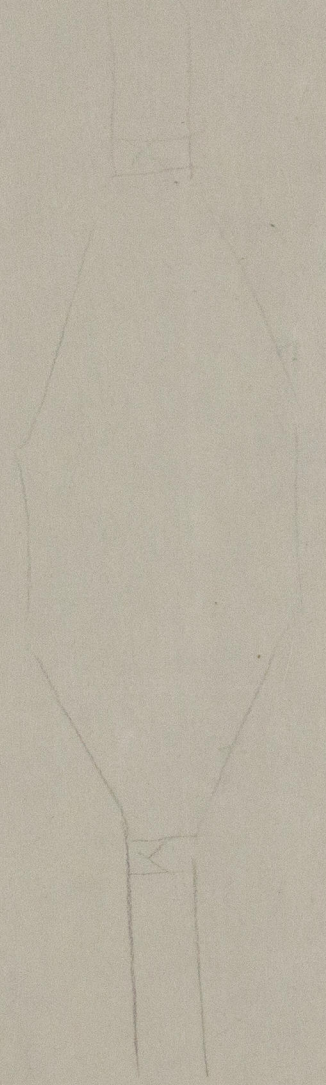

W344-0022



© 2020

Lloyd's Register
Foundation

Deep girders and widely
spaced pillars



No. 2 hold

Nos. 490-1

s/s. "Huanchaco"

Gl. Rpt. N° 25640

n/n "BORE VIII"

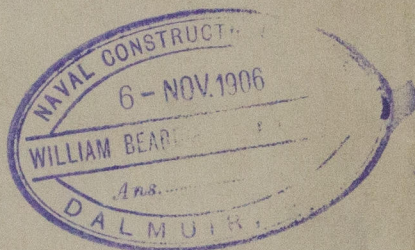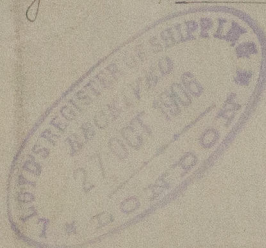

RETAIN

W344-0022



© 2020

Lloyd's Register
Foundation