



S.S. 490-1.

SPECIMEN B<sup>HD</sup>.

SCALE 1/4" = 1 FOOT.

8.10.06

STIFFENERS SPACED 2'-5"

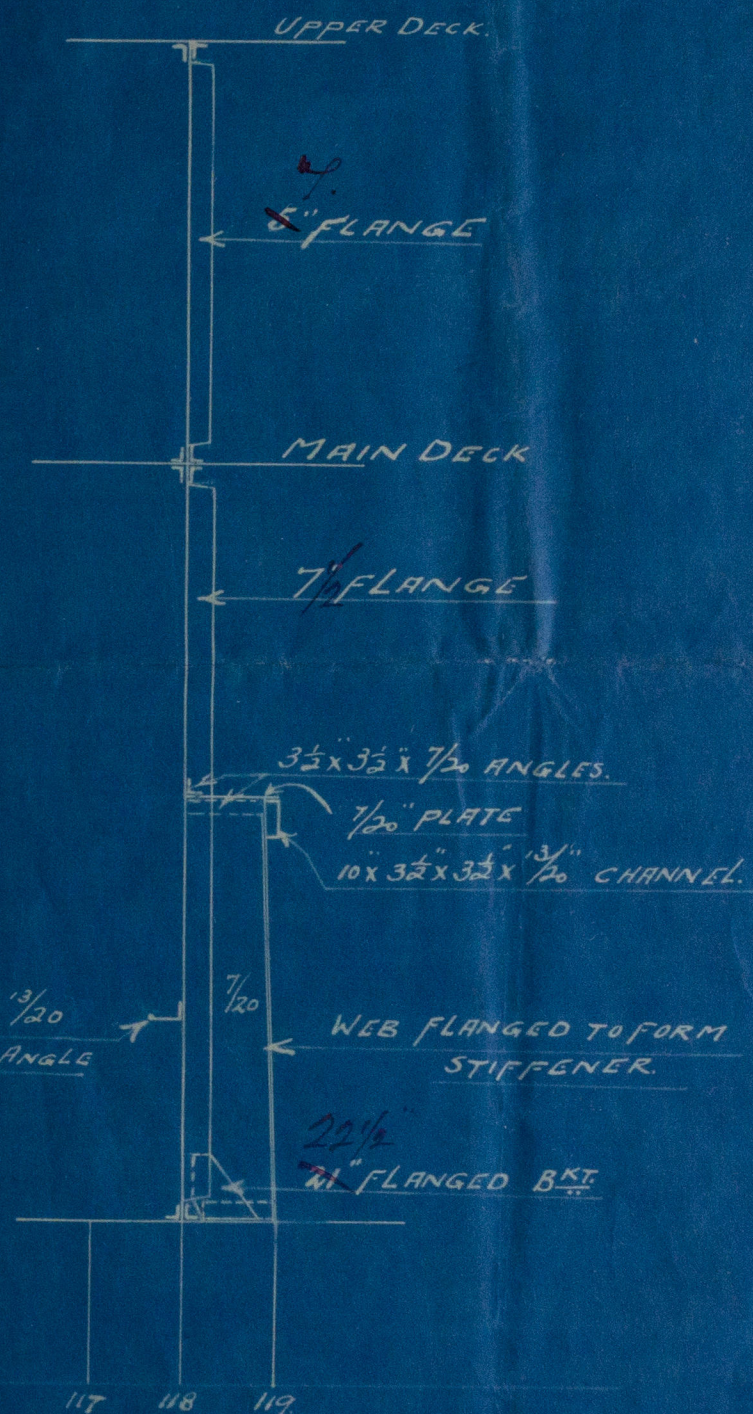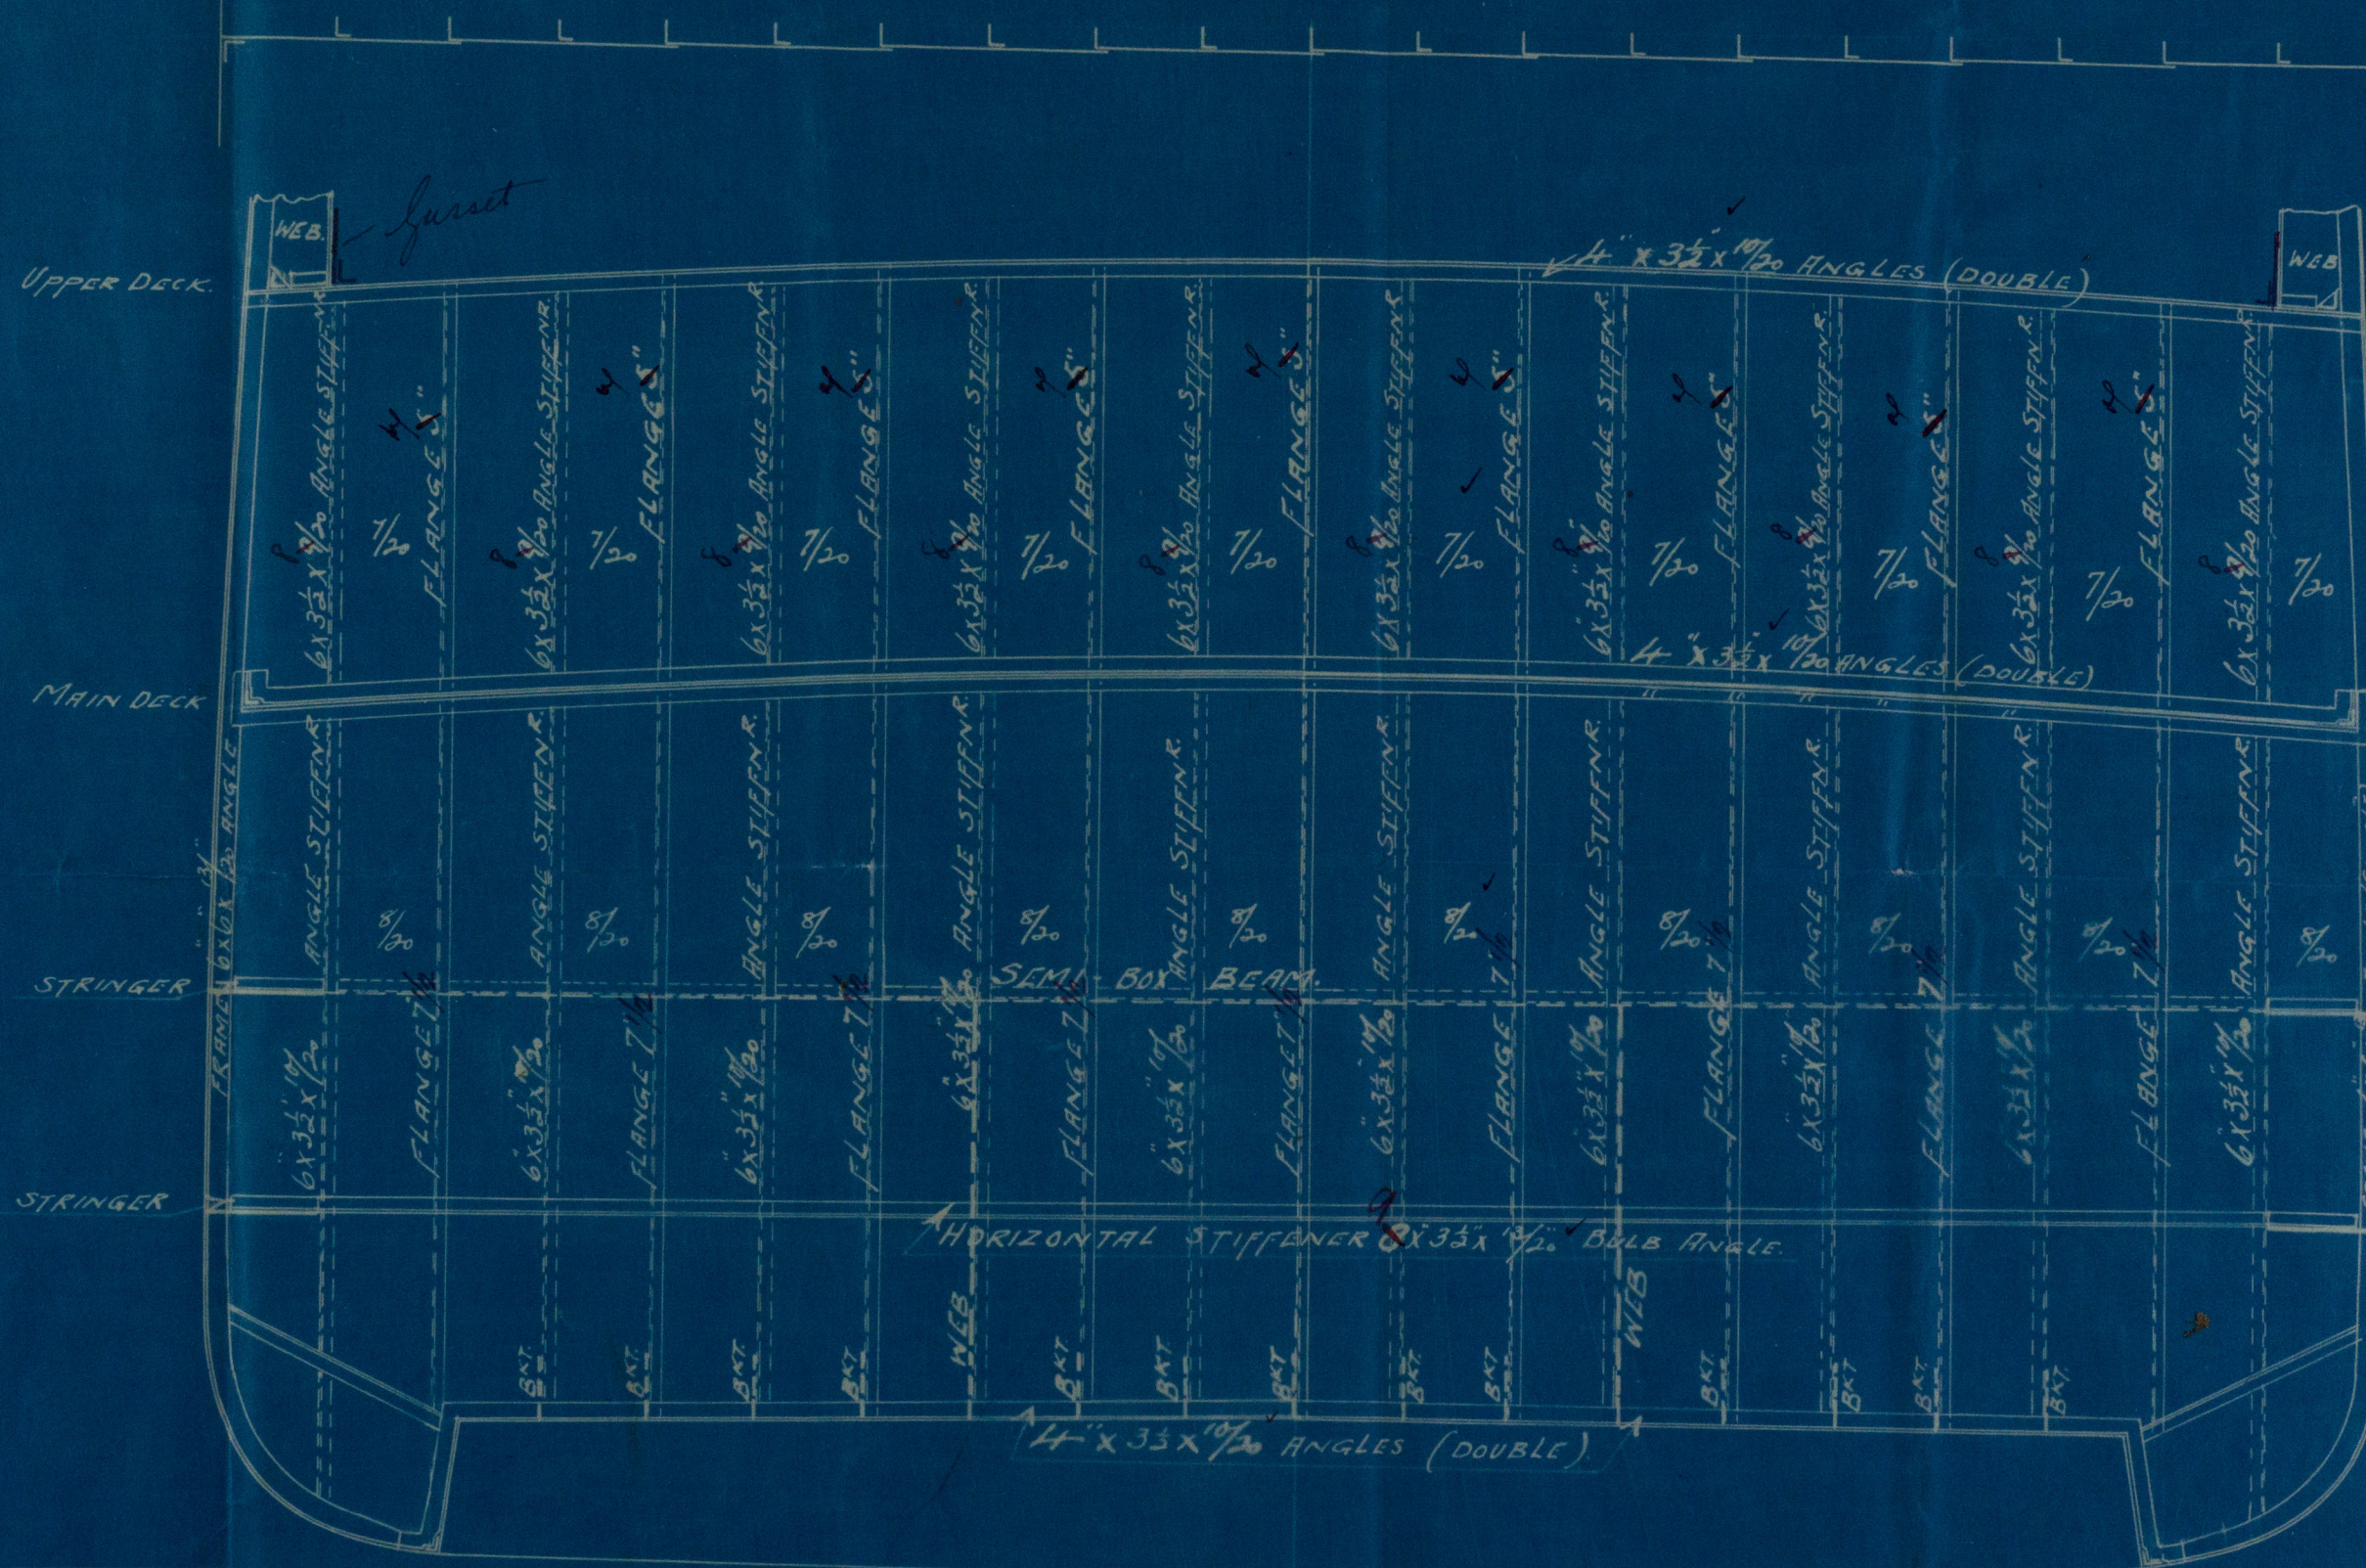

ALTERNATIVE ARRANGEMENT.

VERTICAL STIFFENERS 8x3 1/2 x 1/20 BULB ANGLES, SPACED 30' TO MAIN DECK, WITH NO HORIZONTAL STIFFENERS, SEMI-BOX BEAM OR WEB PLATE.

This arrangement adopted



W361 0026





S/s. "Huanchaco."

Gls. Rpt. N. 25640.

n/n "BORE VIII

Specimen Bulkhead.

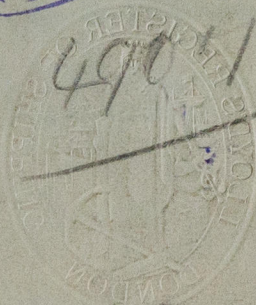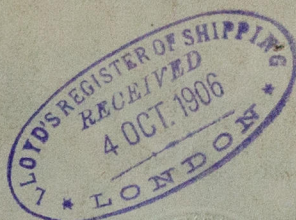

RETAIN

W344-0024



© 2020

Lloyd's Register  
Foundation