
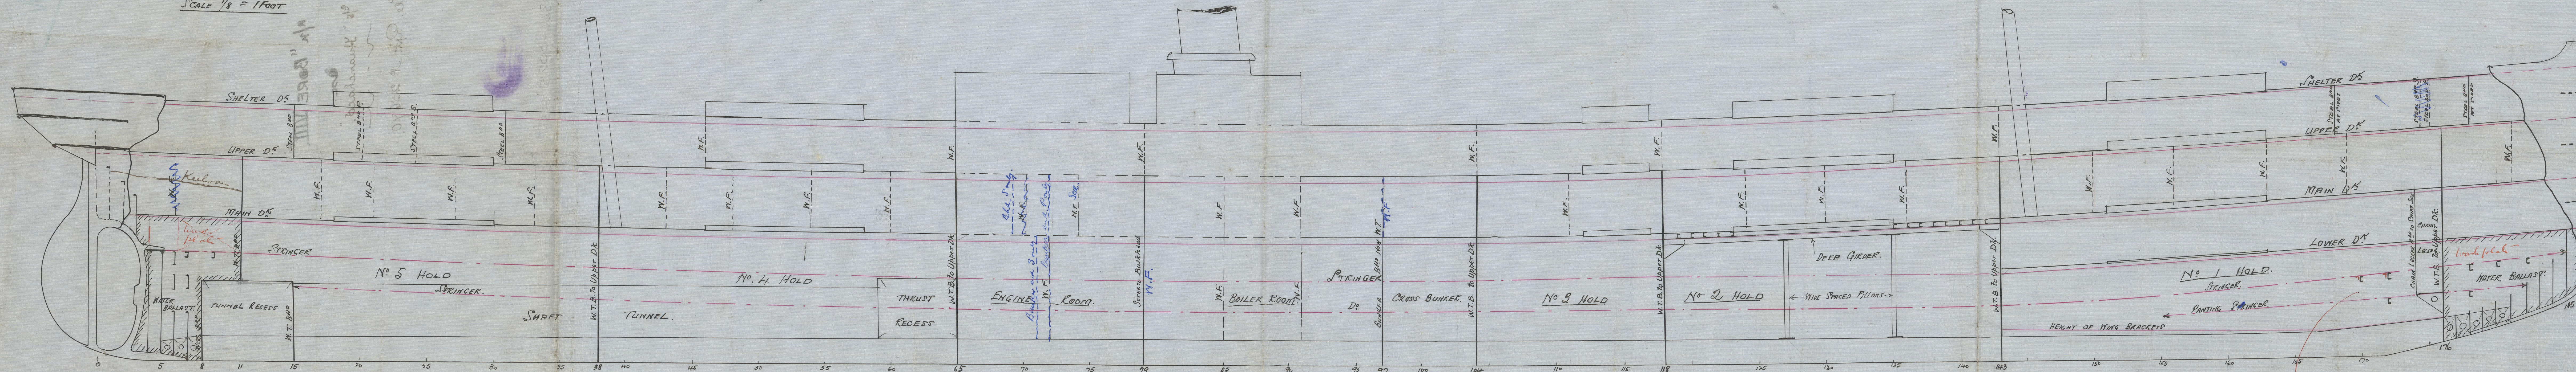


FLY

No. 490.91

OUTLINE OF PROFILE SHEWING ALTERED POSITION
OF BULKHEADS, WITH ADDITIONAL BULKHEAD
AND REARRANGEMENT OF WIDE SPACED
PILLARS IN No. 2 HOLD

SCALE 1/8" = 1 FOOT

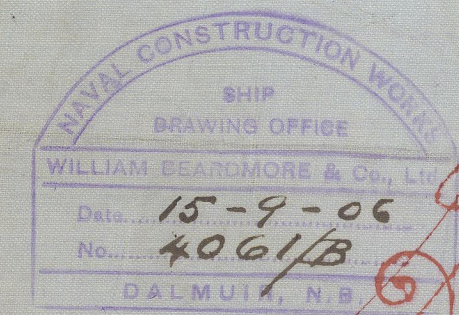

Painting beams in hold
to have back was put in
also of T & T section

W344-0025

5/5 "Huanchaco."

Gls. Rpt. No. 25640.