
 


10/12/12
10/12/12

PROFILE & DECK PLANS
DIM. LBP 430'-0" x 57'-8" BREADTH M.L.P. x 34'-3" DEPTH M.L.P.
SCALE = 1/8" = 1 FOOT

ISHERWOOD BRACKETLESS SYSTEM (PATENT)

Length Numbers
L10 = 430 x 54.5 = 14727
L1(8+8) = 430 x (54.5 + 54.5) = 59521
L10 = 15.8

 

J. W. ISHERWOOD,
4 LLOYD'S AVENUE,
LONDON, E.C.
ISHERWOOD SYSTEM OF
SHIP CONSTRUCTION
DATE 10/12/12

MESSRS. PALMER & CO. LTD.
HARBOR-ON-TIME
10/12/12

2

Palmer's

959

Profile + deck plans

S. S. BRITISH INVENTOR
NEWCASTLE ON TYNE

Report No. 80522

10 RETAIN



.W346-0036

W346-0036 2/2

477 656 52 777 5077

DECK 100

DECK LONGS 6 x 3 x 30 119

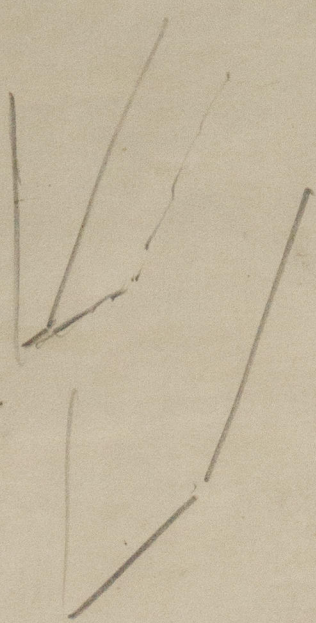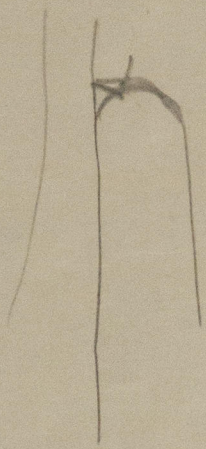

Lloyds

Wfe



© 2020

Lloyd's Register
Foundation