



ENLARGED SECTION THRU CIRCUMFERENTIAL JOINT AT MANHEAD

ENLARGED SECTION AT LONGITUDINAL JOINT


ENLARGED SECTION THRU CIRCUMFERENTIAL JOINT AT PLAINHEAD

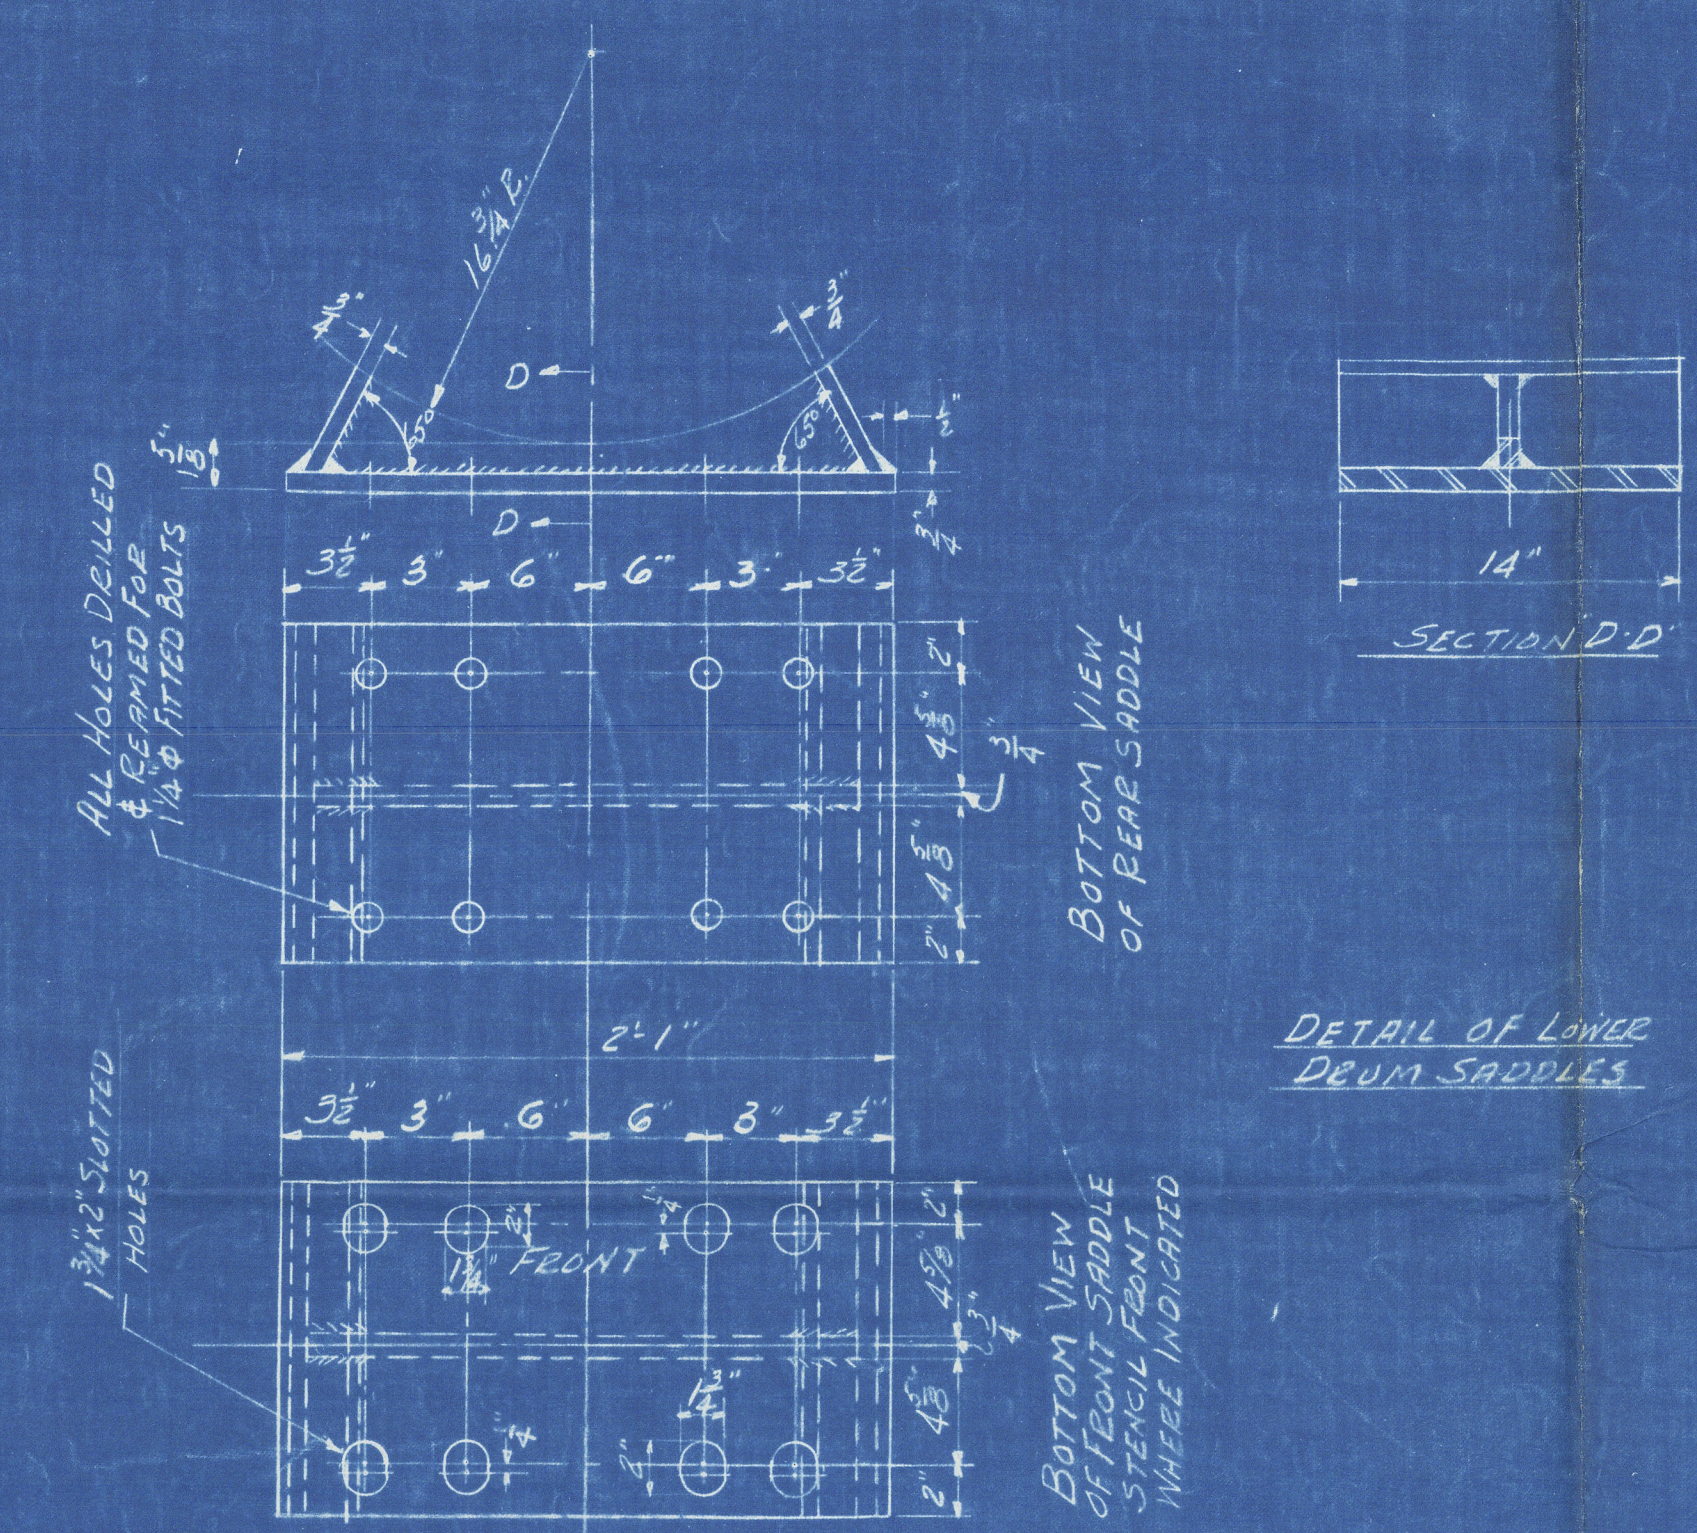


DETAIL OF LOWER DRUM SADDLES

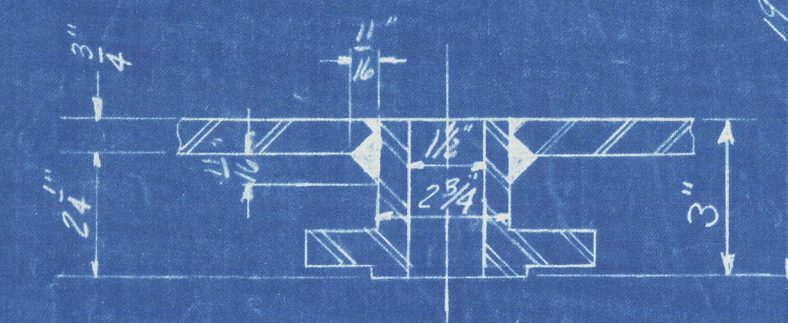


SECTION B-B ENLARGED SECTION THRU 1/4" BOTTOM B.O.

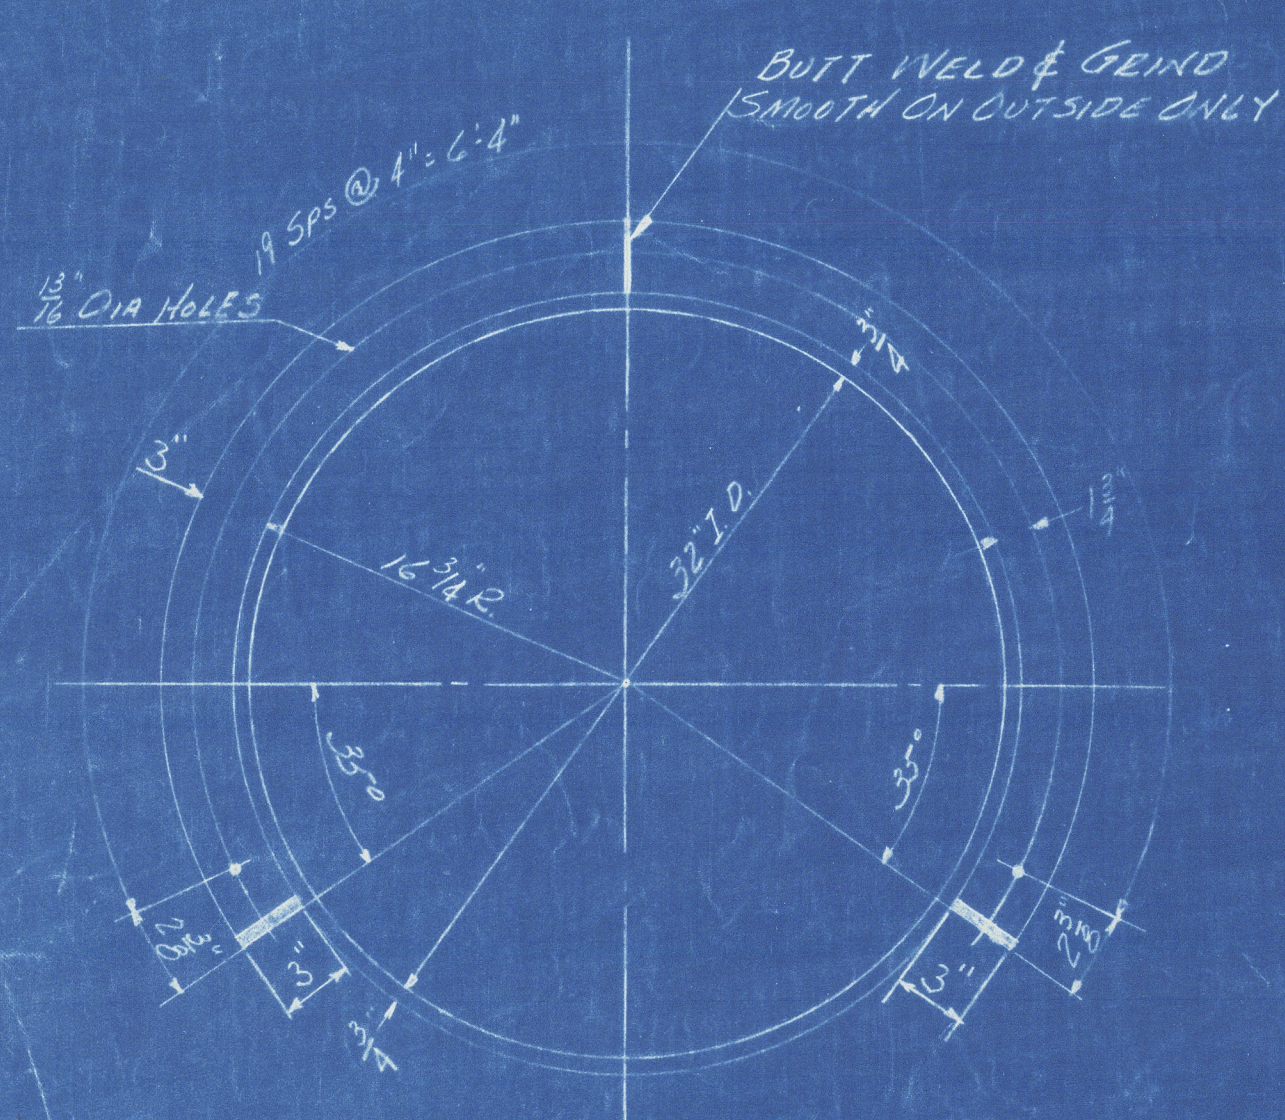

SECTION C-C

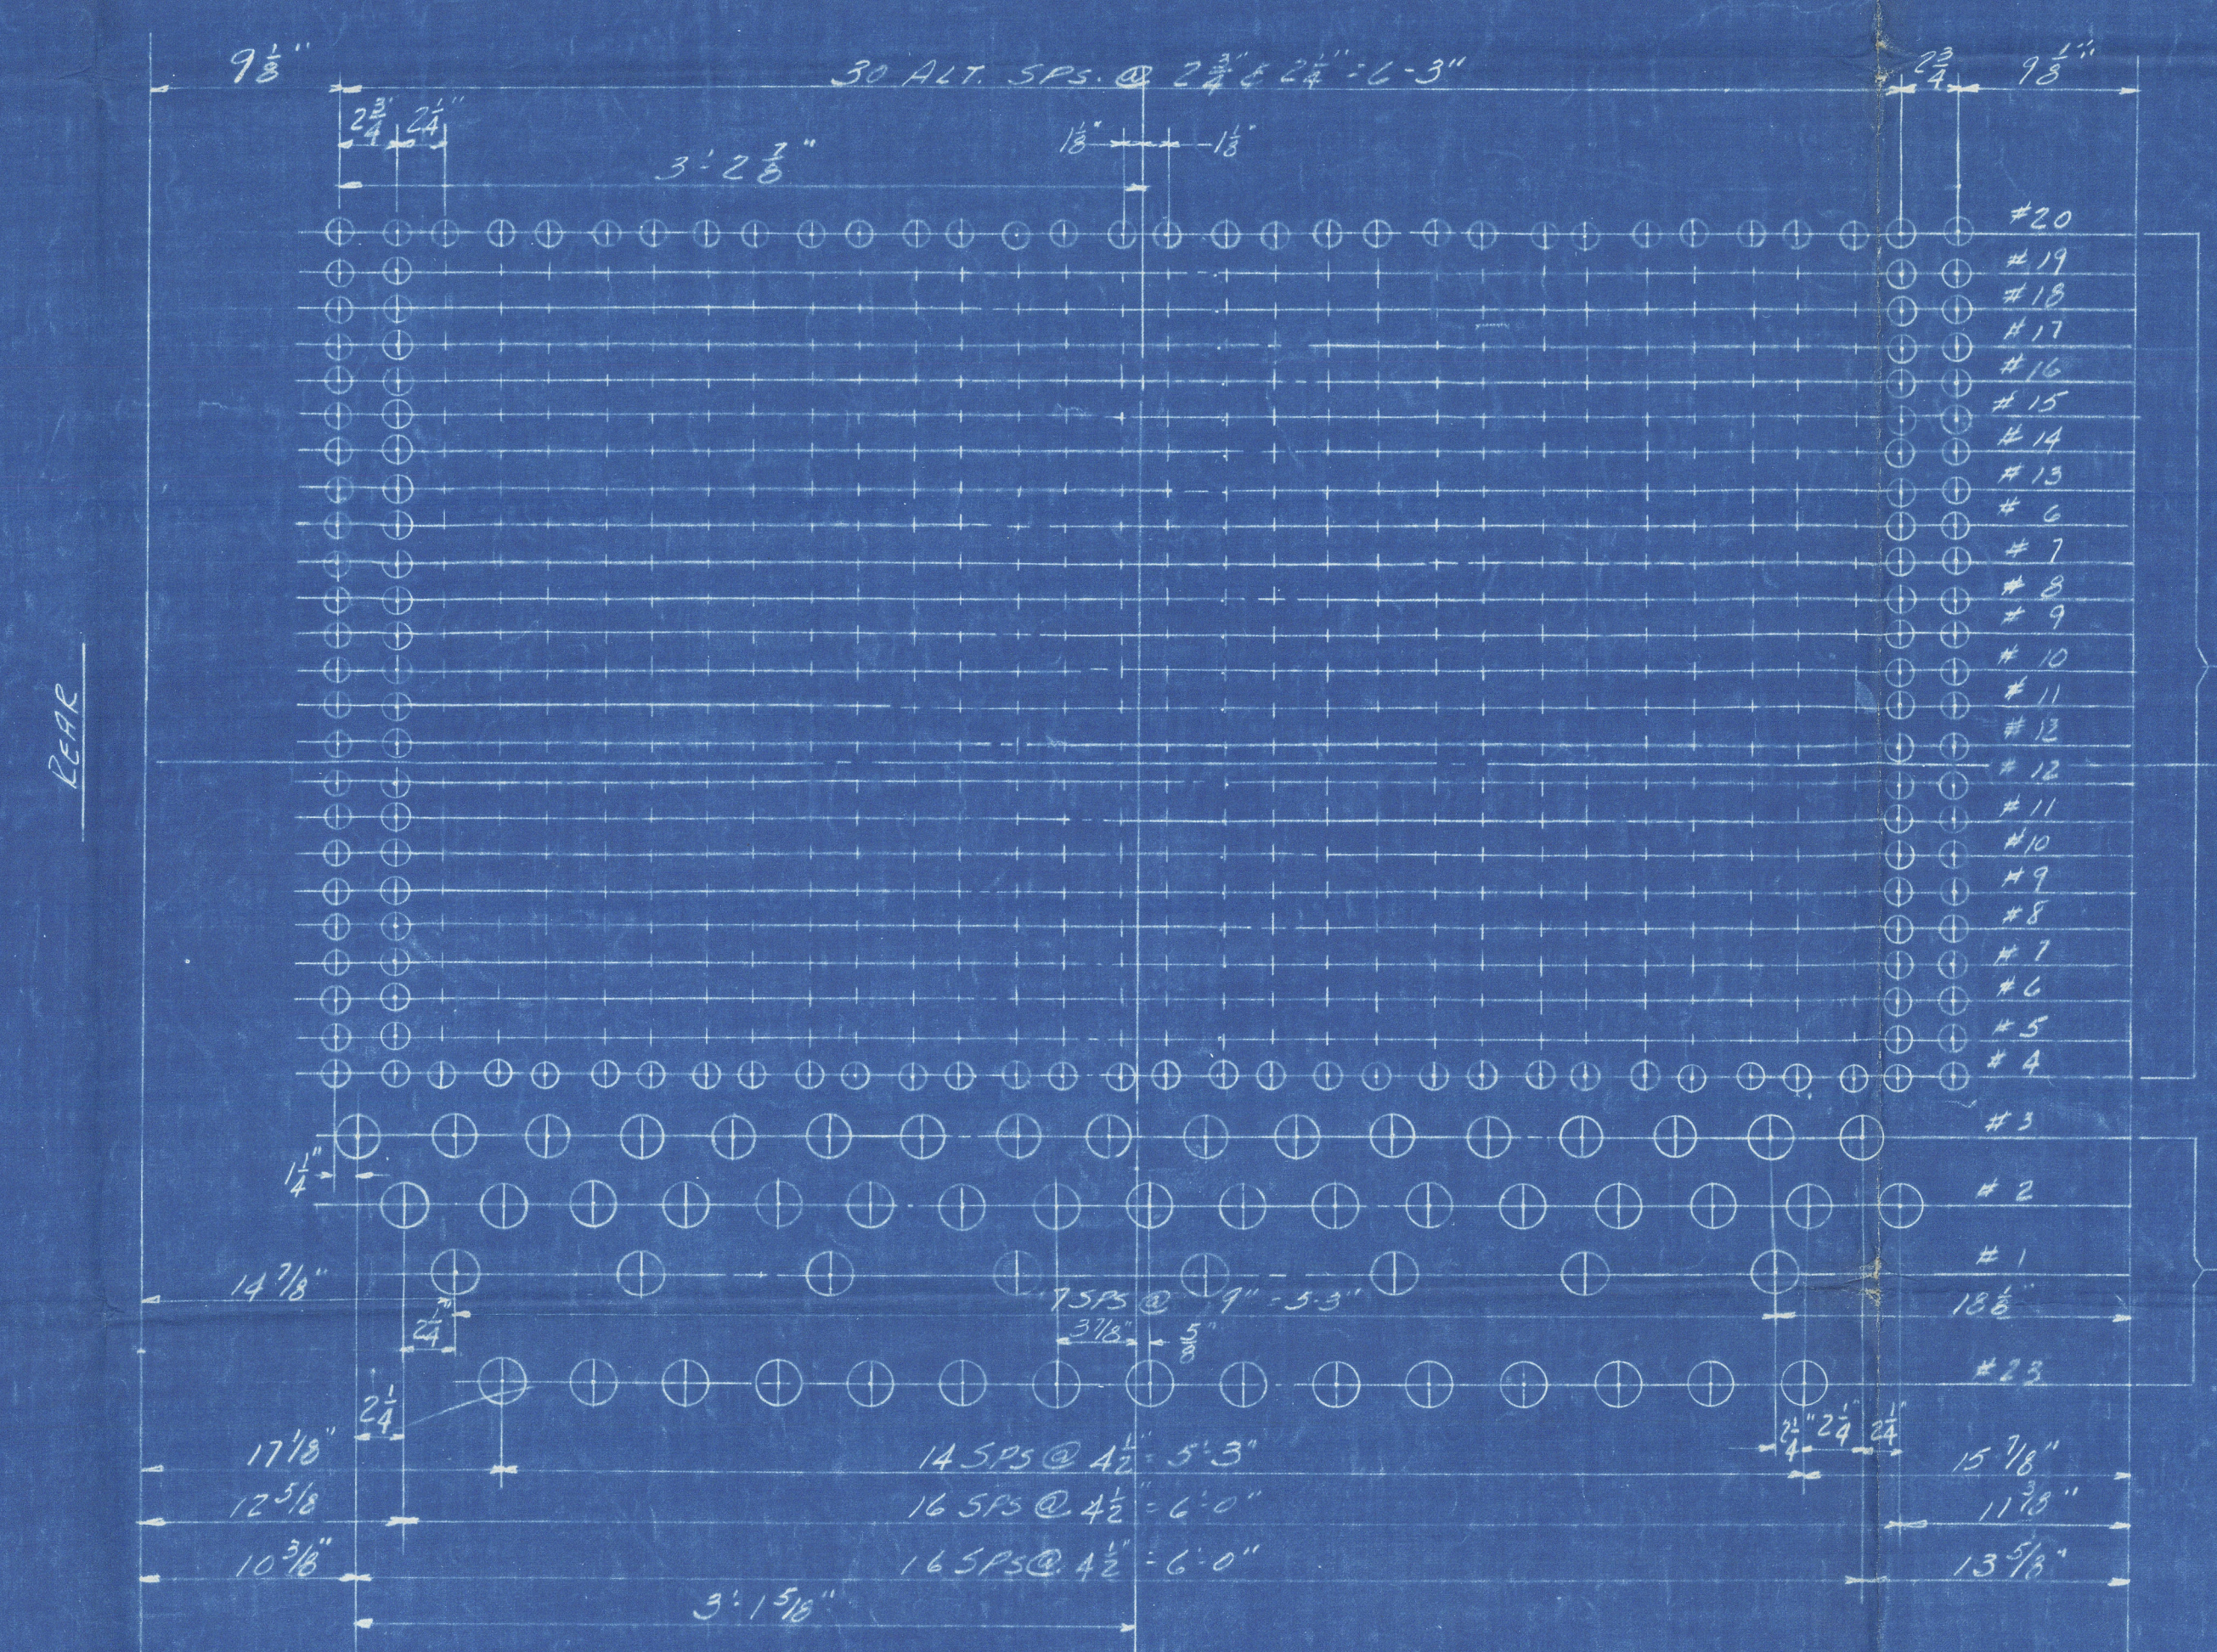


DEVELOPMENT OF PLATE OUTSIDE VIEW 8'0" OVERALL LENGTH OF DRUM (APPROX)

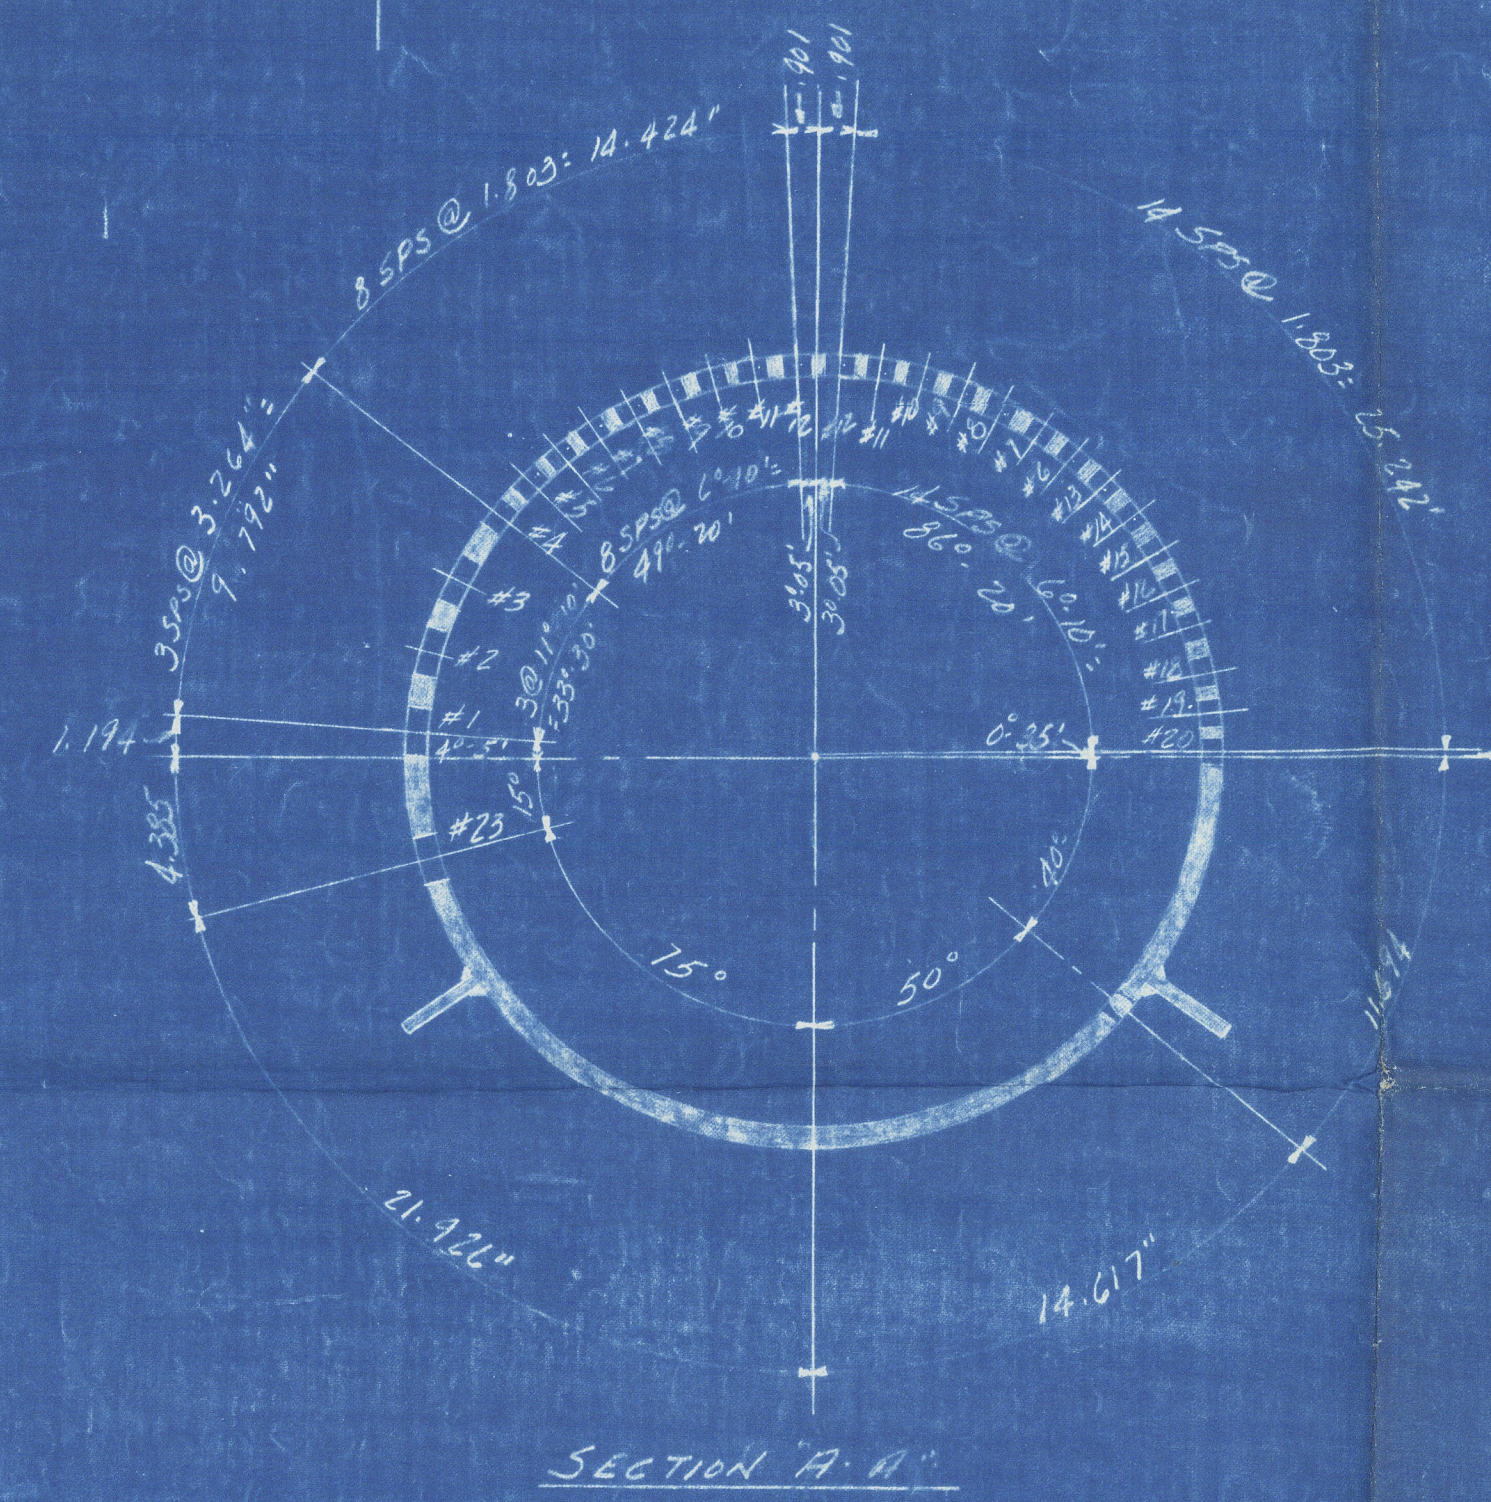


SECTION A-A


NOTE: CIRCUMF. DIMENSIONS ARE MEASURED ON OUTSIDE OF SHELL AFTER ROLLING. CIRCUMFERENCE = 105.243" QUADRANT = 26.311"

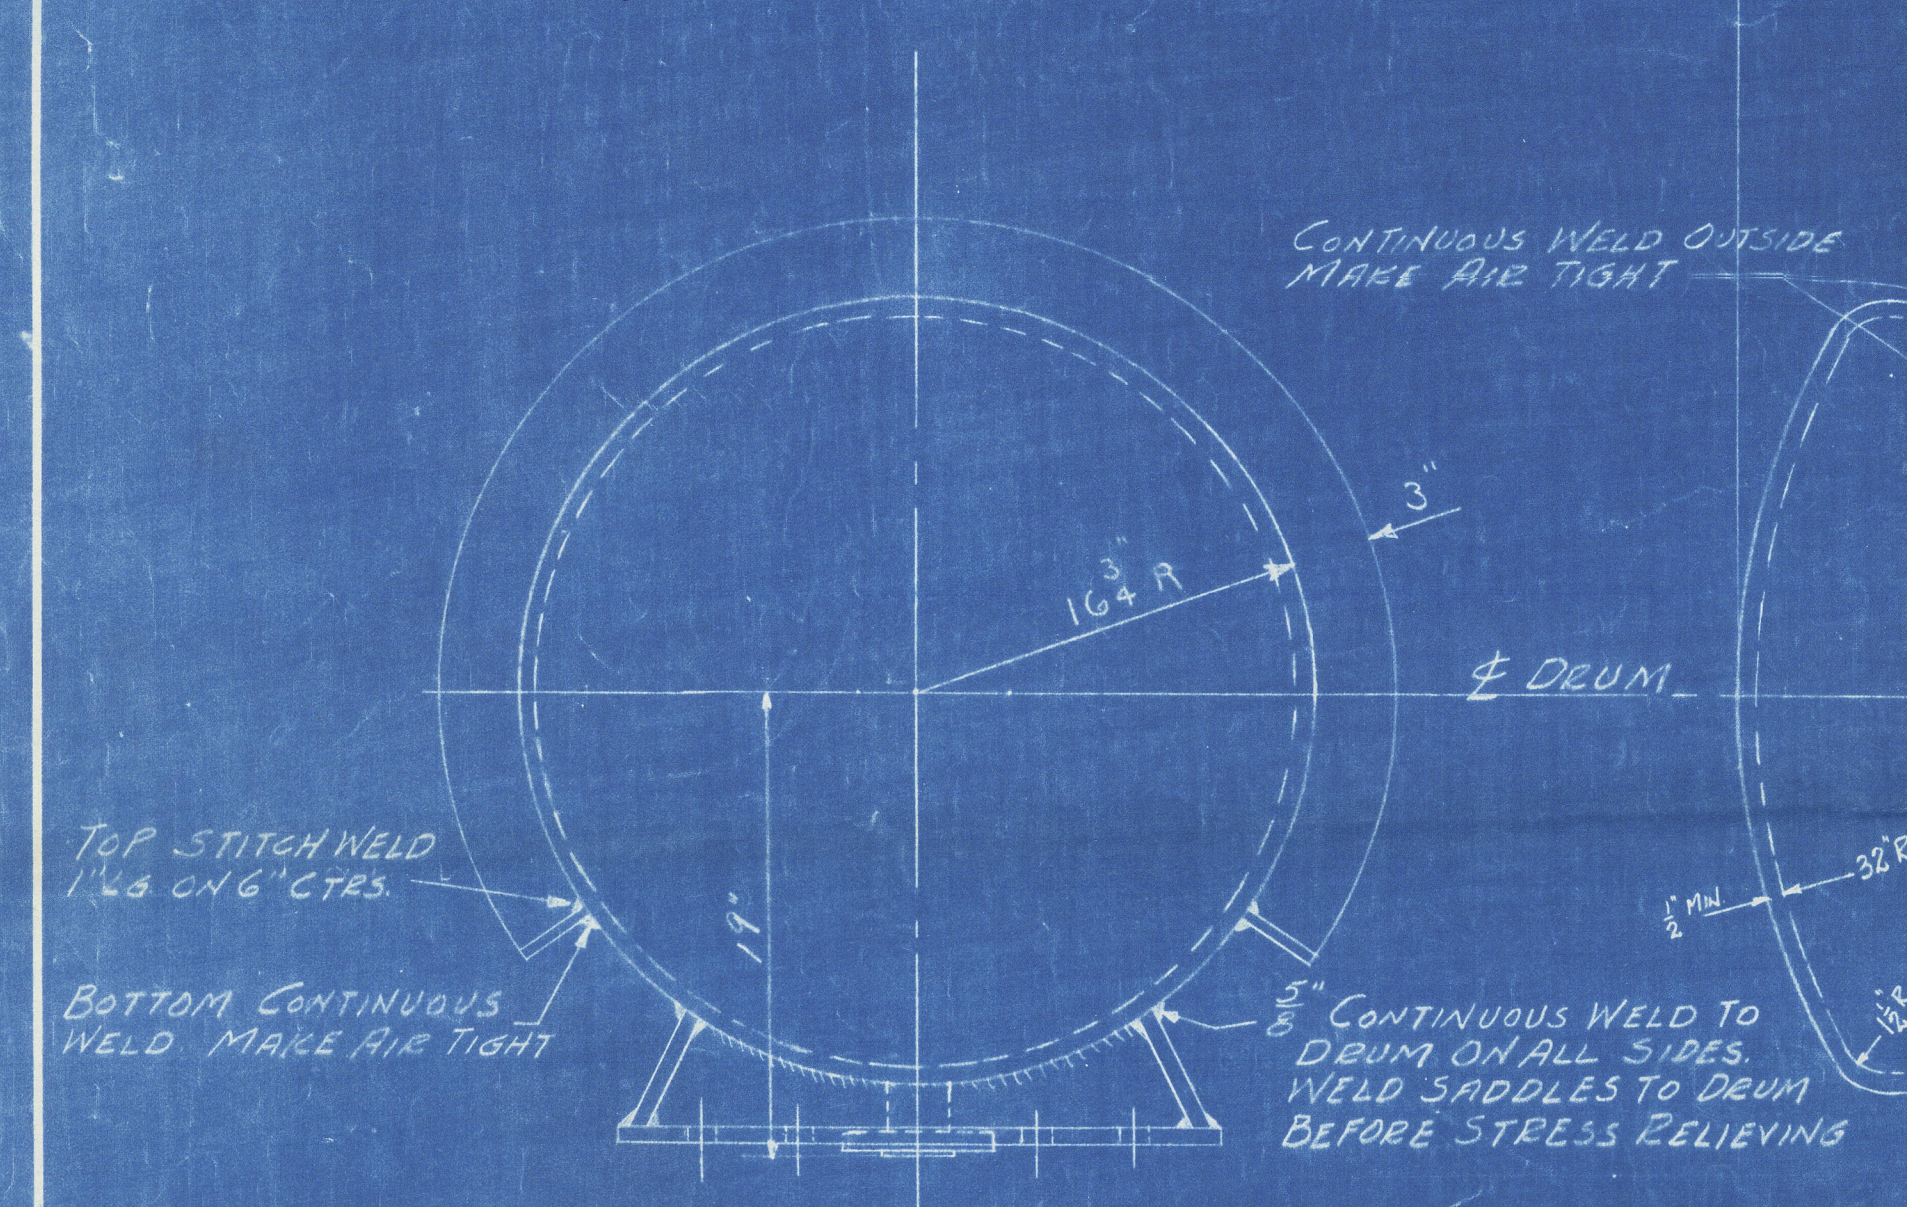

REAR ELEVATION

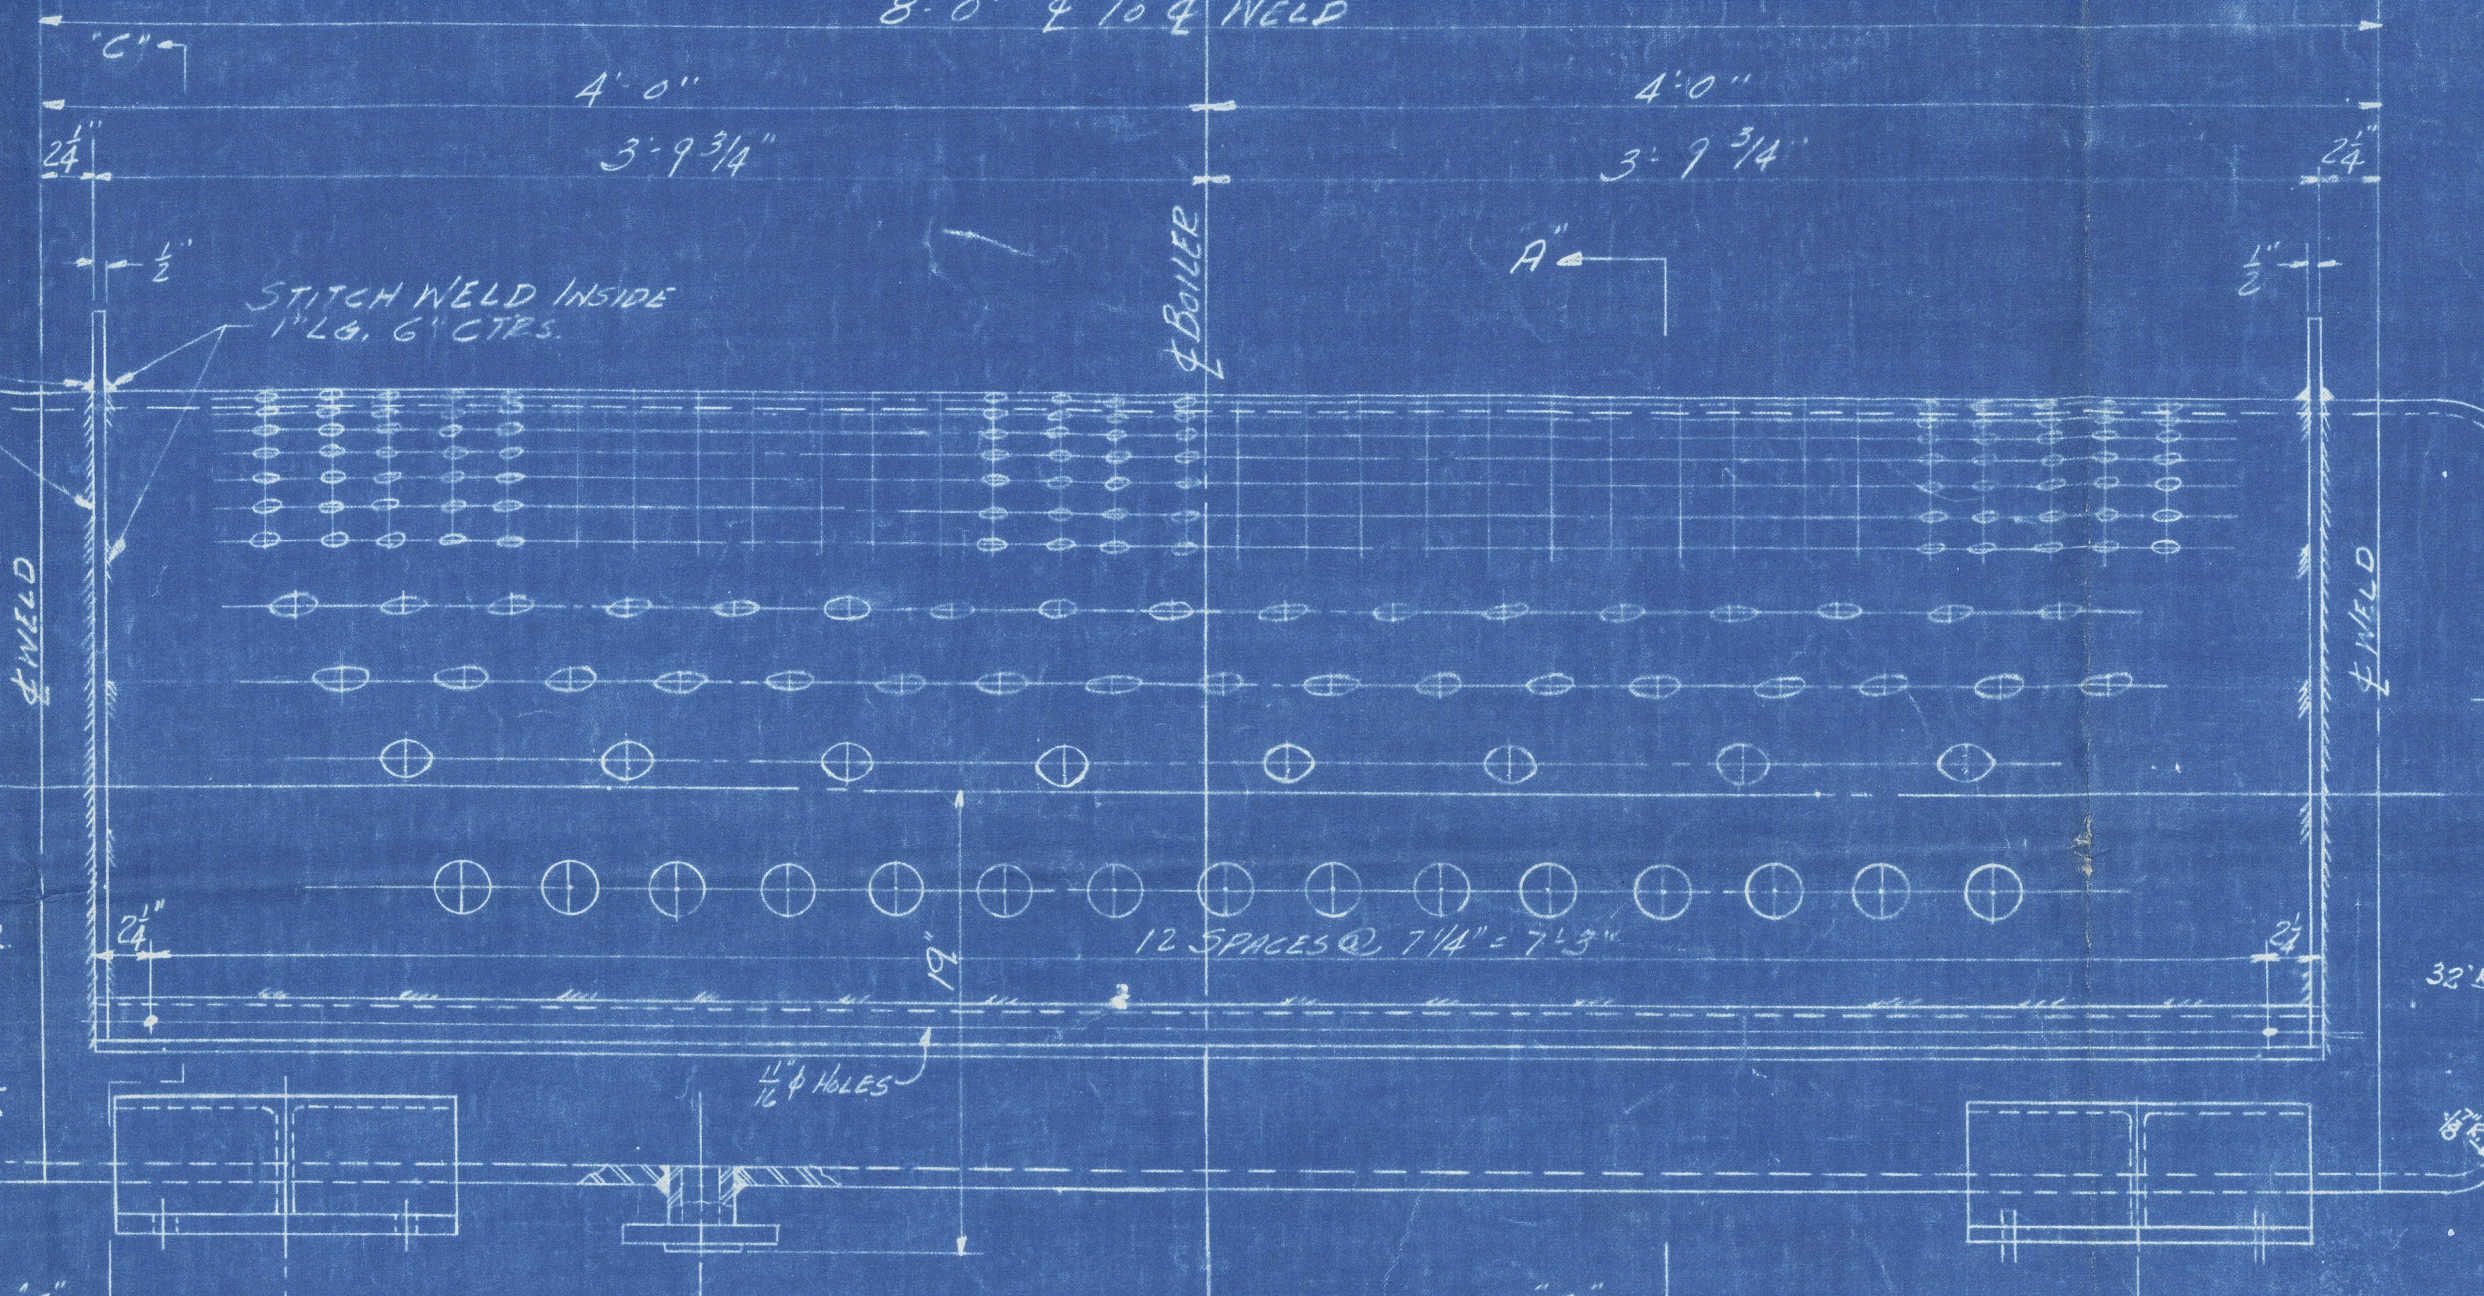

BOTTOM OF DRUM

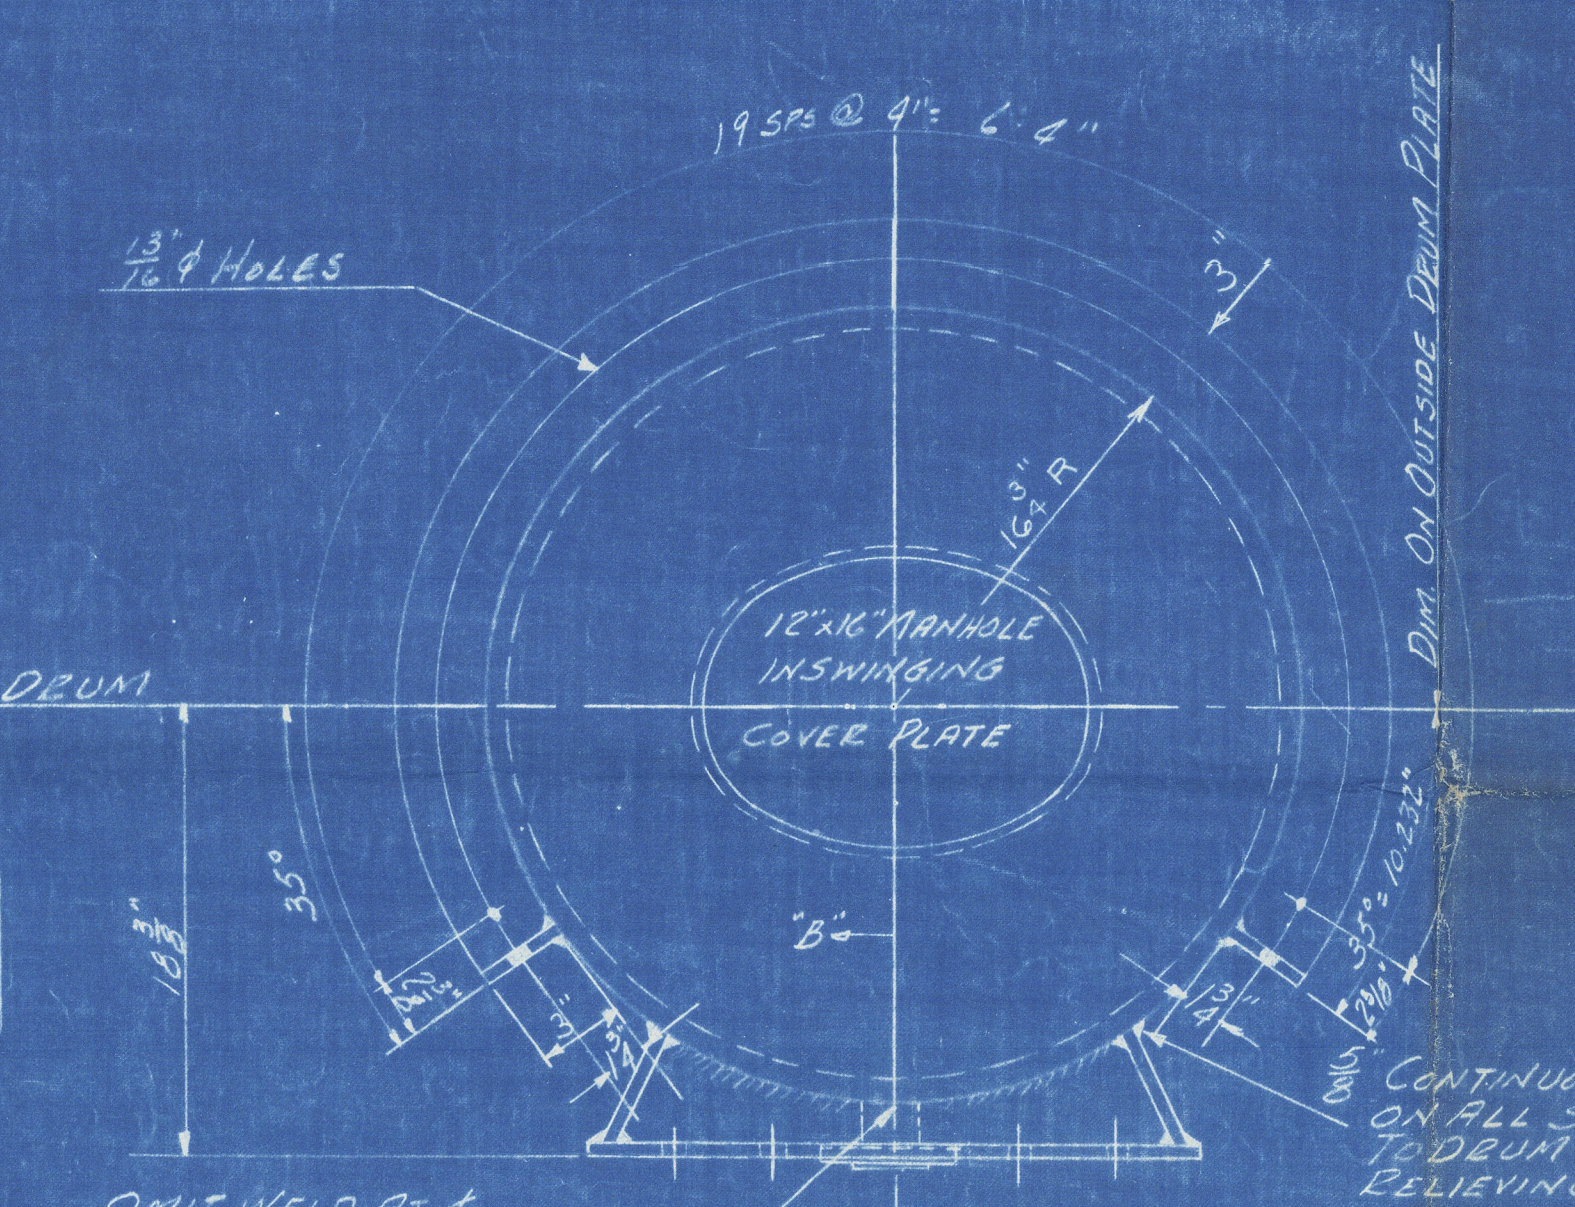

FRONT ELEVATION

CONTINUOUS WELD TO DRUM ON ALL SIDES. WELD SADDLES TO DRUM BEFORE STRESS RELIEVING DRUM.

NOTE: 1. DRUM RECD. AS SHOWN. 2. CDD HAND.

RETAIN

APPROVED OCT 21 1942 LLOYD'S REGISTER OF SHIPPING NEW YORK

John S. Hoad

CONTRACT		
C. D. MALLOY & CO.		NY 410-322
DESIGN PRESSURE		230#
HYDROSTATIC TEST PRESS.		345#
FINAL "30P"		460/19"
REFERENCE DRAWINGS		
GENERAL REQD.	NY 410-322	
TUBE SHEET	NY 410-312	
UPPER DRUM DETAIL	NY 410-320	
LOWER DRUM DETAIL	NY 410-321	
MANHOLE COVER PLATE	NY 410-323	
STEEL WELDS & FORGE CO'S PART 12-242		
MANHOLE COVER HINGE		NY 343-185-C
MATERIAL SPECIFICATIONS		
THE DRUMS ON THIS CONTRACT ARE TO BE FUSION WELDED CONSTRUCTION AND ARE TO BE BUILT IN ACCORDANCE WITH THE UNITED STATES DEPT. OF COMMERCE, BUREAU OF MARINE INSPECTION & NAVIGATION, RECOMMENDED RULES, 1934, 1935, 1936,39		