


R.M.S. "ORFORD"

PORT. HP. TURBINE BOTTOM HALF CASING
SHOWING POSITION OF CRACKS.

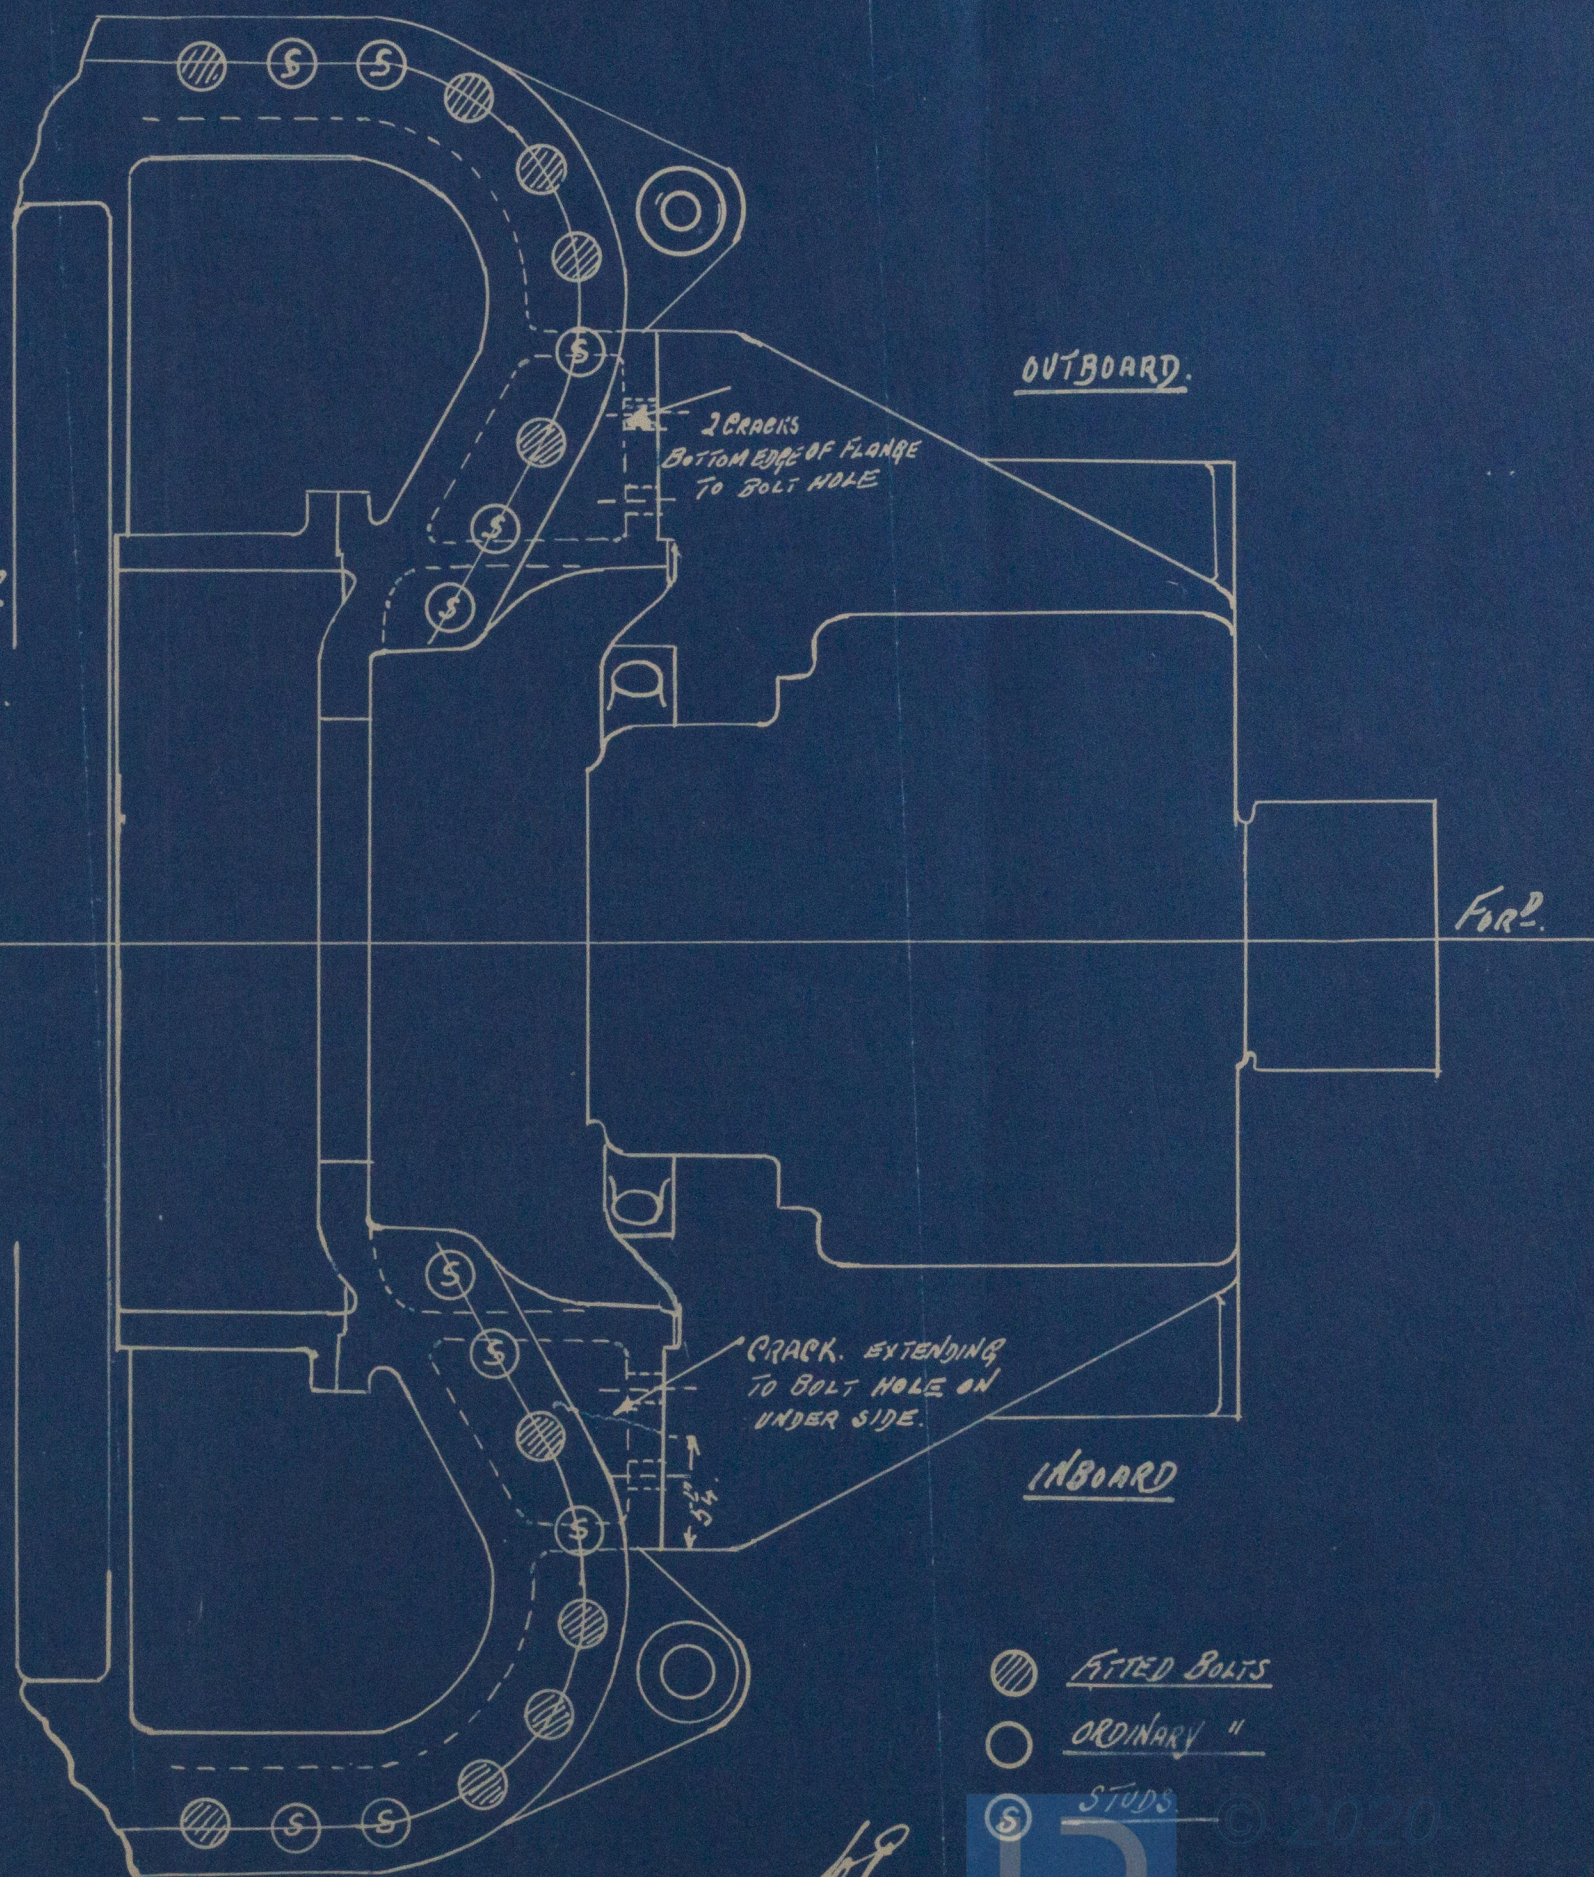

© 2020
Lloyd's Register
Foundation

8/5 "Orford"

London Rps No 107055

Port HPTurbine
cracked casing



© 2020

Lloyd's Register
Foundation

W347-0096