


RMS. "ORFORD"

STARRD H.P. TURBINE BOTTOM HALF CASING

SHOWING POSITION OF CRACKS

FEBRUARY. 1939.

SCALE: - $1\frac{1}{2}" = 1\text{ FT.}$

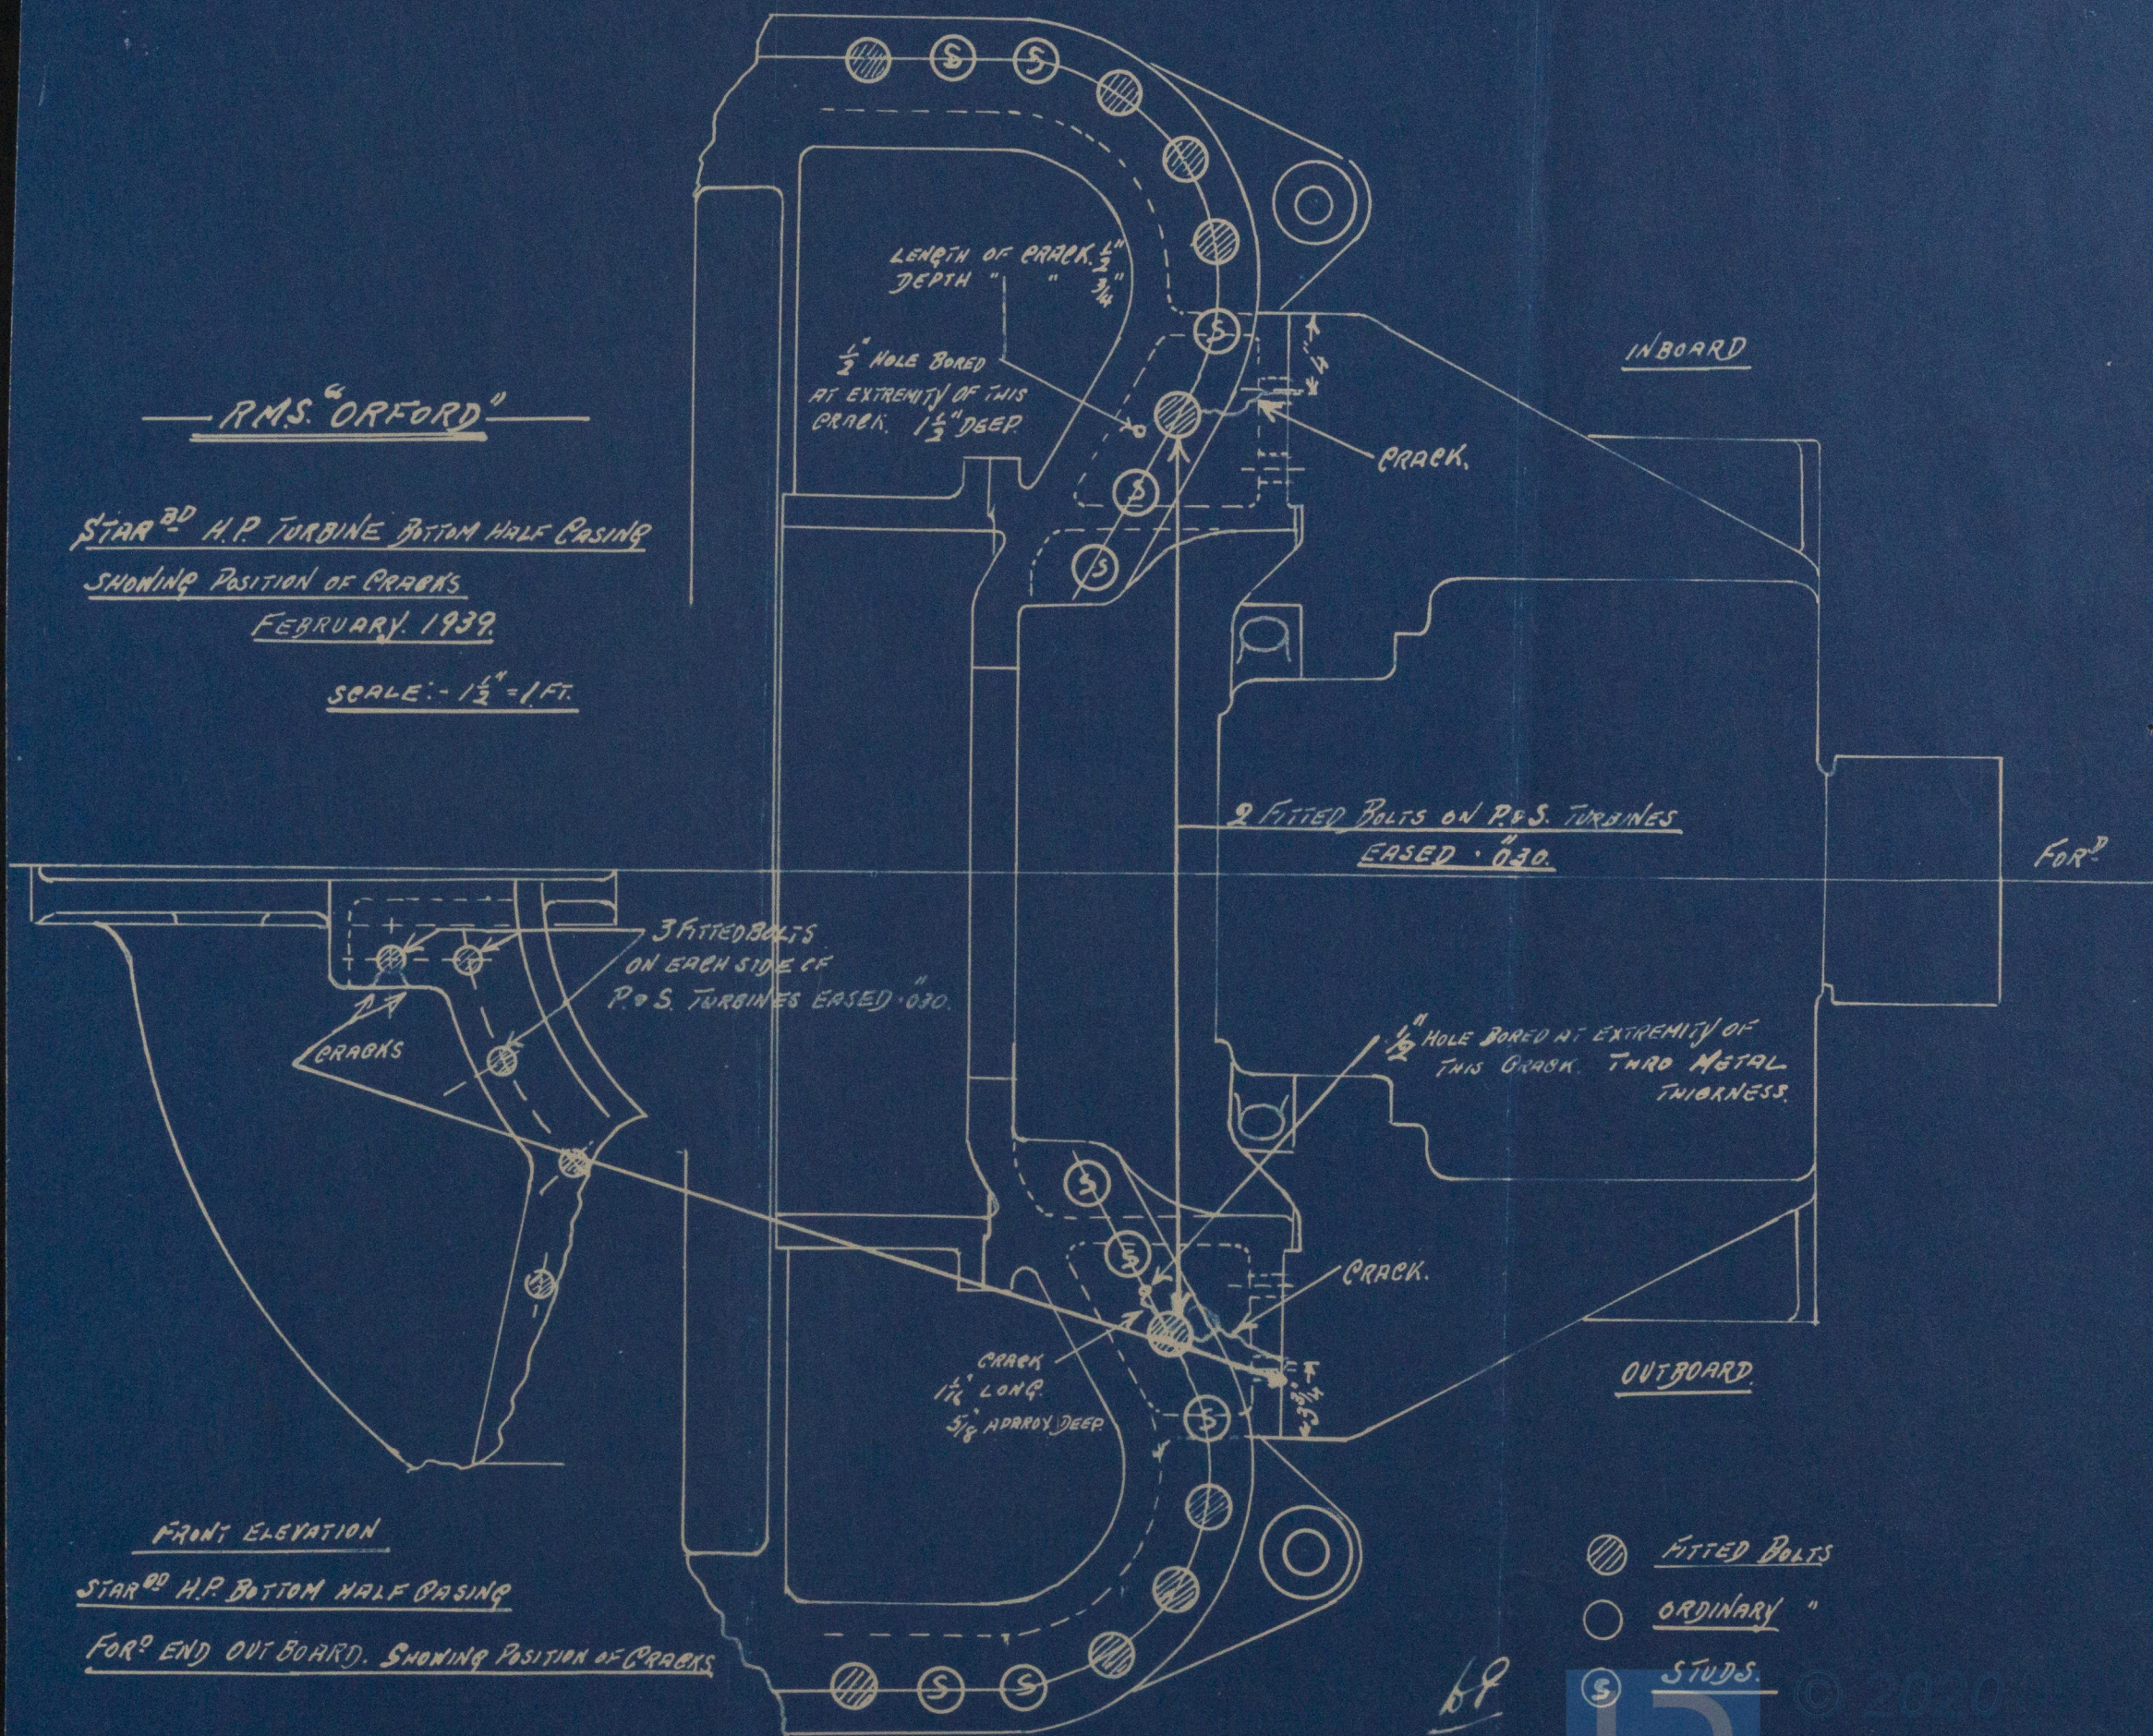

FRONT ELEVATION

STARRD H.P. BOTTOM HALF CASING

FORRD END OUT BOARD. SHOWING POSITION OF CRACKS

\odot FITTED BOLTS
 \circ ORDINARY "
 \oplus STUDS.



© 2020 Lloyd's Register Foundation

5/5 "Orford"

London Reg No 107055

Of H P Turbure
Arched casing



© 2020

Lloyd's Register
Foundation

W347-0097