
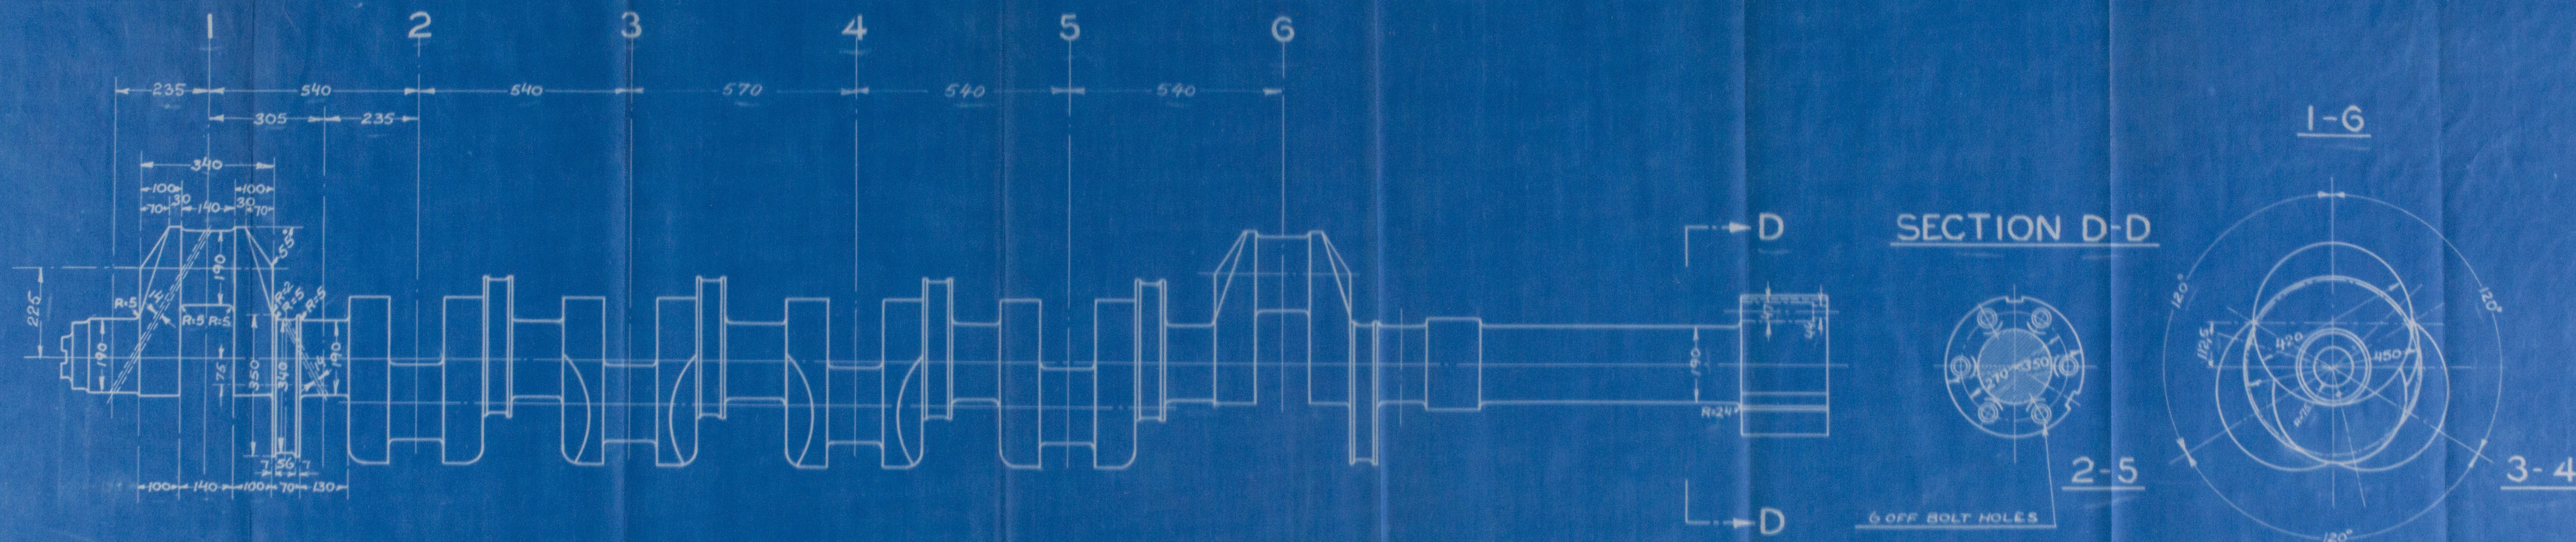


109451

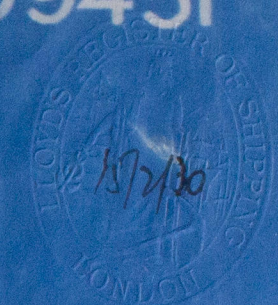

THIS DRAWING AND THE DESIGN SHOWN
THEREIN, IS THE PROPERTY
OF BURMEISTER & WAIN LIMITED, AND
IS ONLY ALLOWED TO BE USED BY
EXPRESS PERMISSION AND LICENSE FROM
BURMEISTER & WAIN LIMITED
COPENHAGEN

CRANK SHAFT FOR YARD N° 581

6 CYLINDER 2 S.C.S.A. DIESEL ENGINE WITH SOLID INJECTION

AUXILIARY MOTOR

CYL. DIAM. 280 M/M STROKE 450 M/M


AKTIESELSKABET
BURMEISTER & WAIN MASKIN- OG SKIBSBYGGERT

Car. O. O. O.

WSS-0132




Lloyd's Register
Foundation

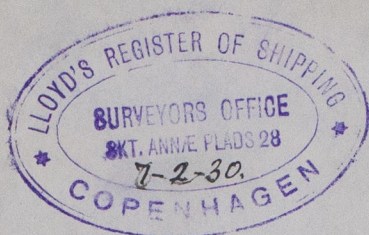

Plan of
CRANK SHAFT for the 6 Cyl.
2 S.C.S.A. Auxiliary Diesel oil engine
for the Screw Motor Vessel
Yard No 581
being built by

**AKTIESELSKABET
BURMEISTER & WAIN MASKIN- OG SKIBSBYGERI**
Copenhagen

M/S "EUROPA" of Copenhagen
Copenhagen Report No 8517.

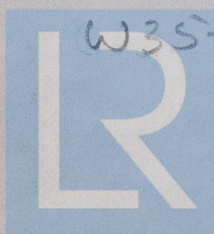

W35-003 2020

Lloyd's Register
Foundation