


SHIP No 357. PROFILE & DECKS.

To CLASS 100 A1 "WITH FREEBOARD" (CORRESPONDING TO A C.S.S. VESSEL WITH TONNAGE OPENING.)

DIMS:- LENGTH 250'-0" B.P. BREADTH 38'-0"

DEPTH TO MAIN DECK 15'-3"; DEPTH TO UPPER DECK 22'-9".

SCALE:- 1/8" = 1 FOOT.

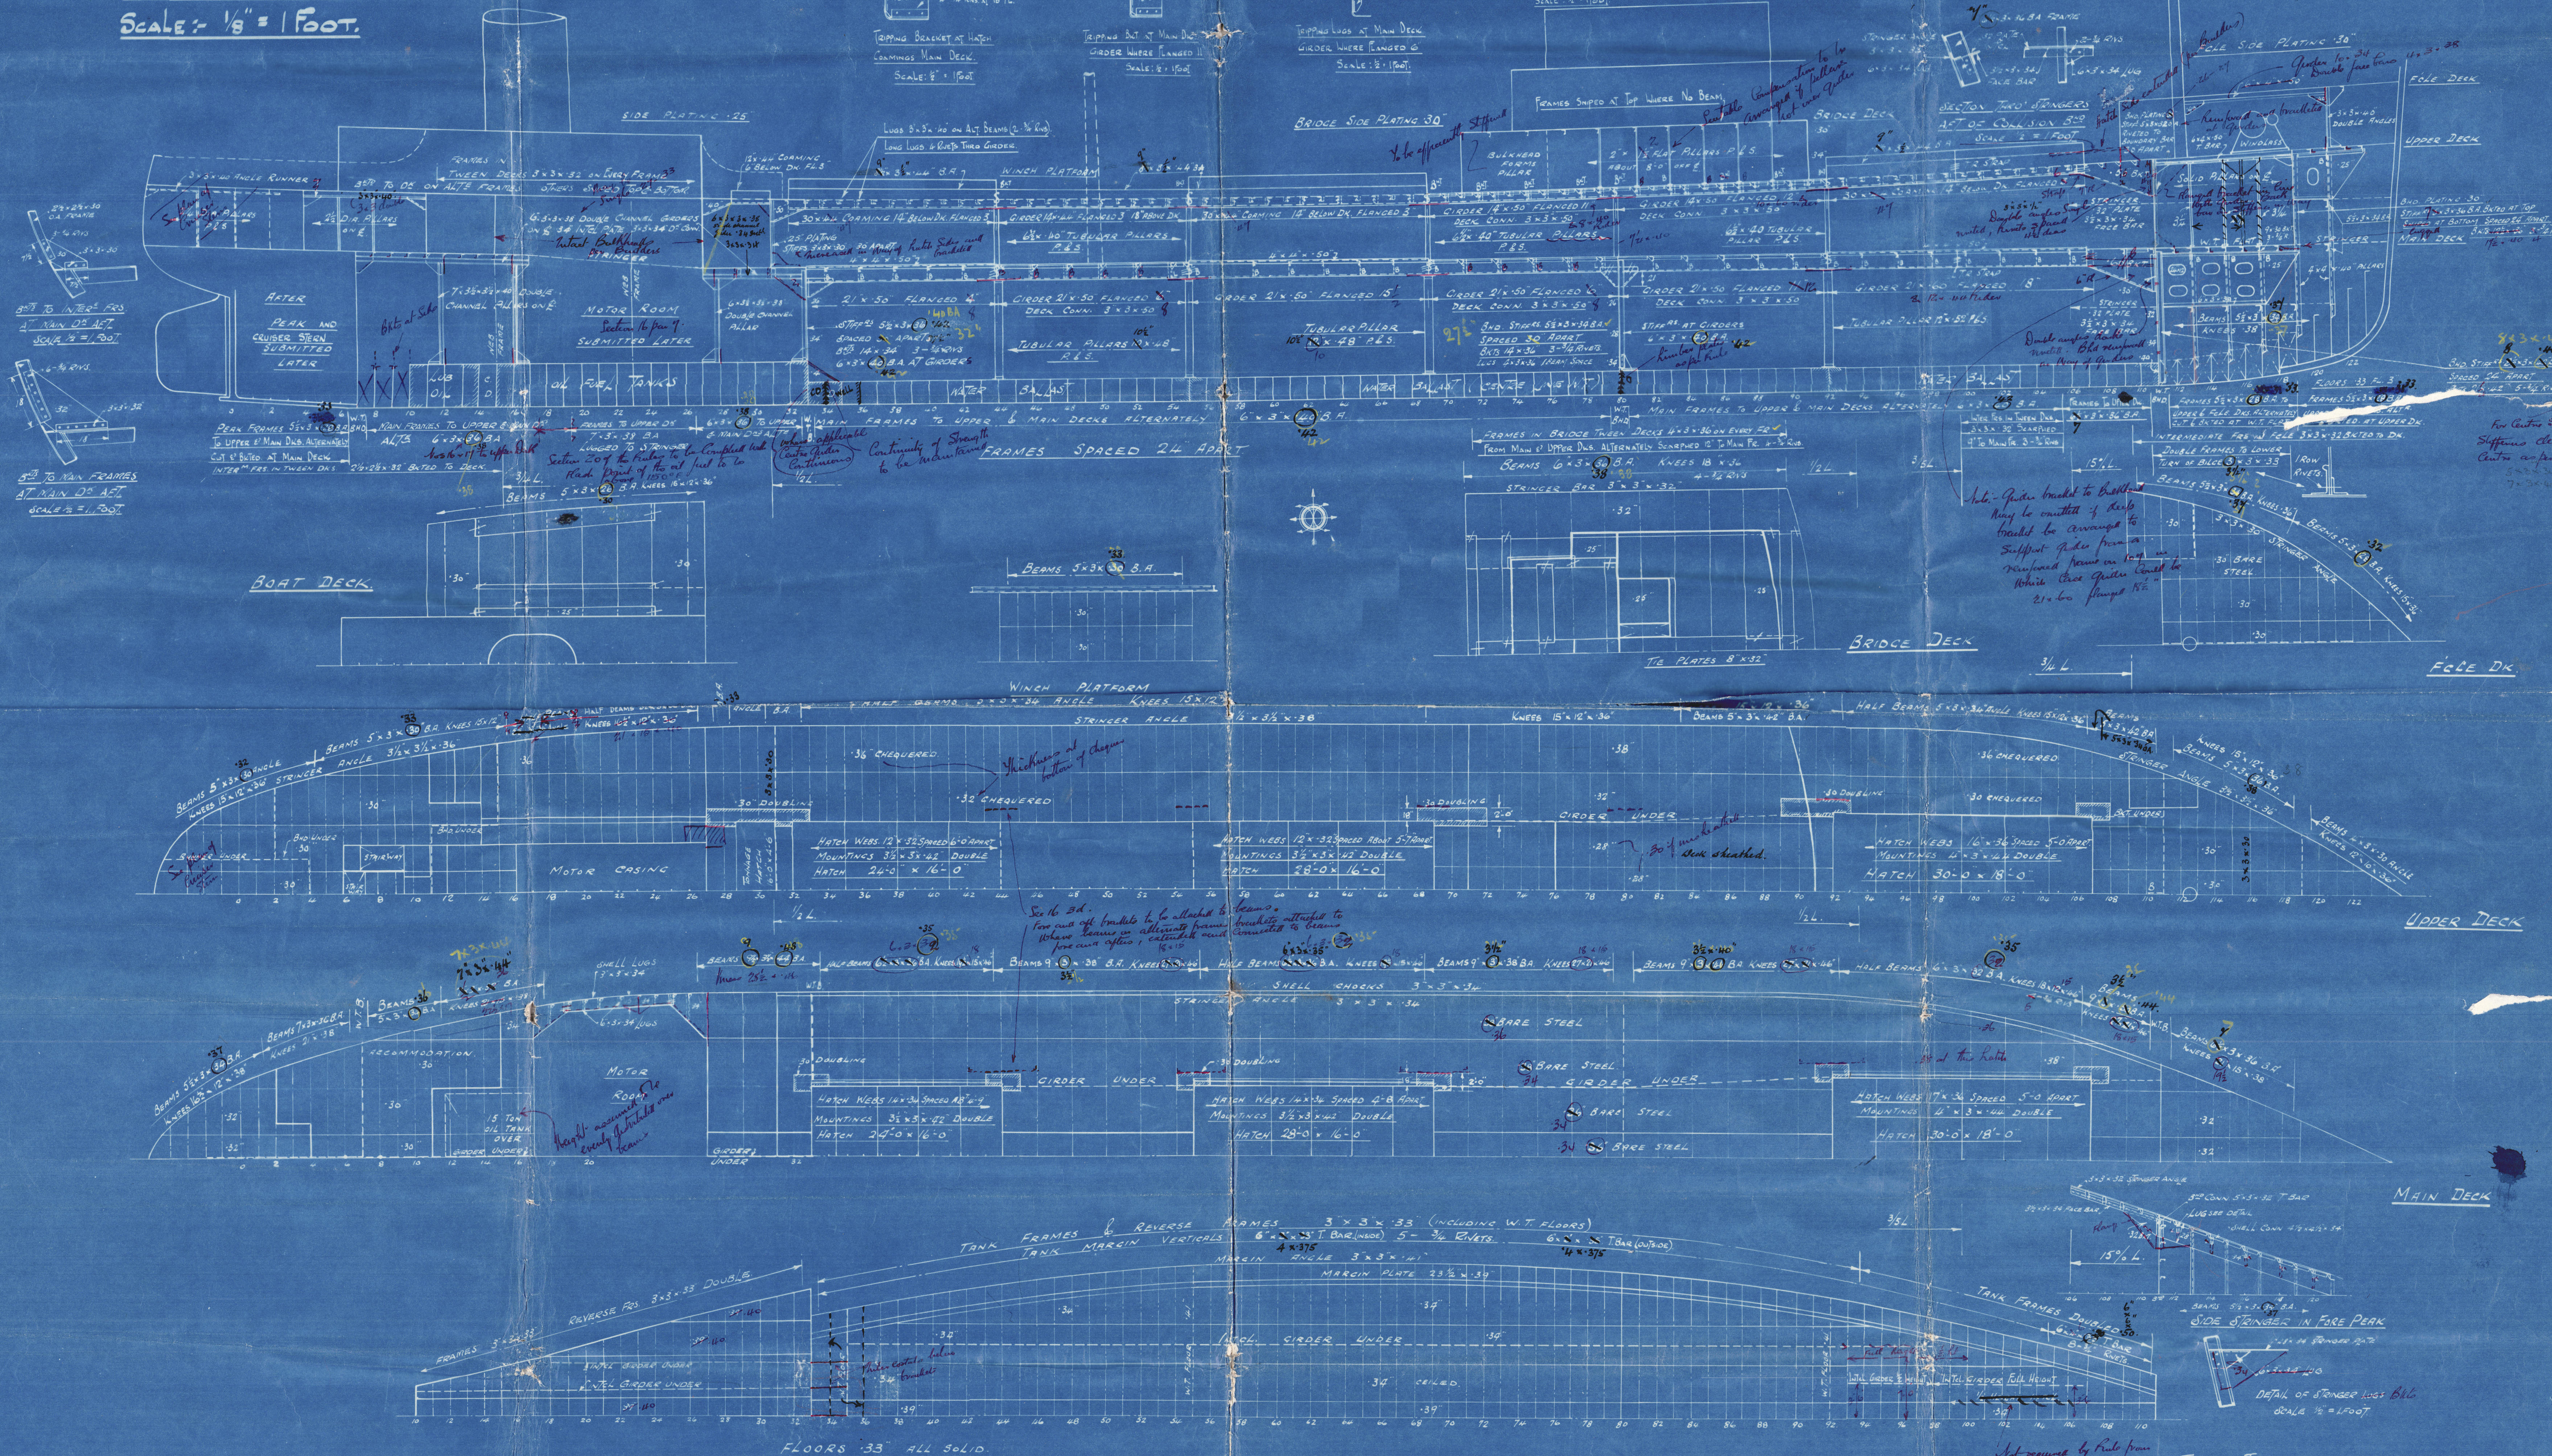

Bolt angles assumed 1700 Standard Section

to Manholes in floors or girders under pillars

Subular and Solid pillars to have a bearing fit at head and heel



Arrangements at heads and heels of pillars and following


Supporter Subular:

Standard of Subular pillars and Subular pillars

Standard 26 to 32 tons per sq ft

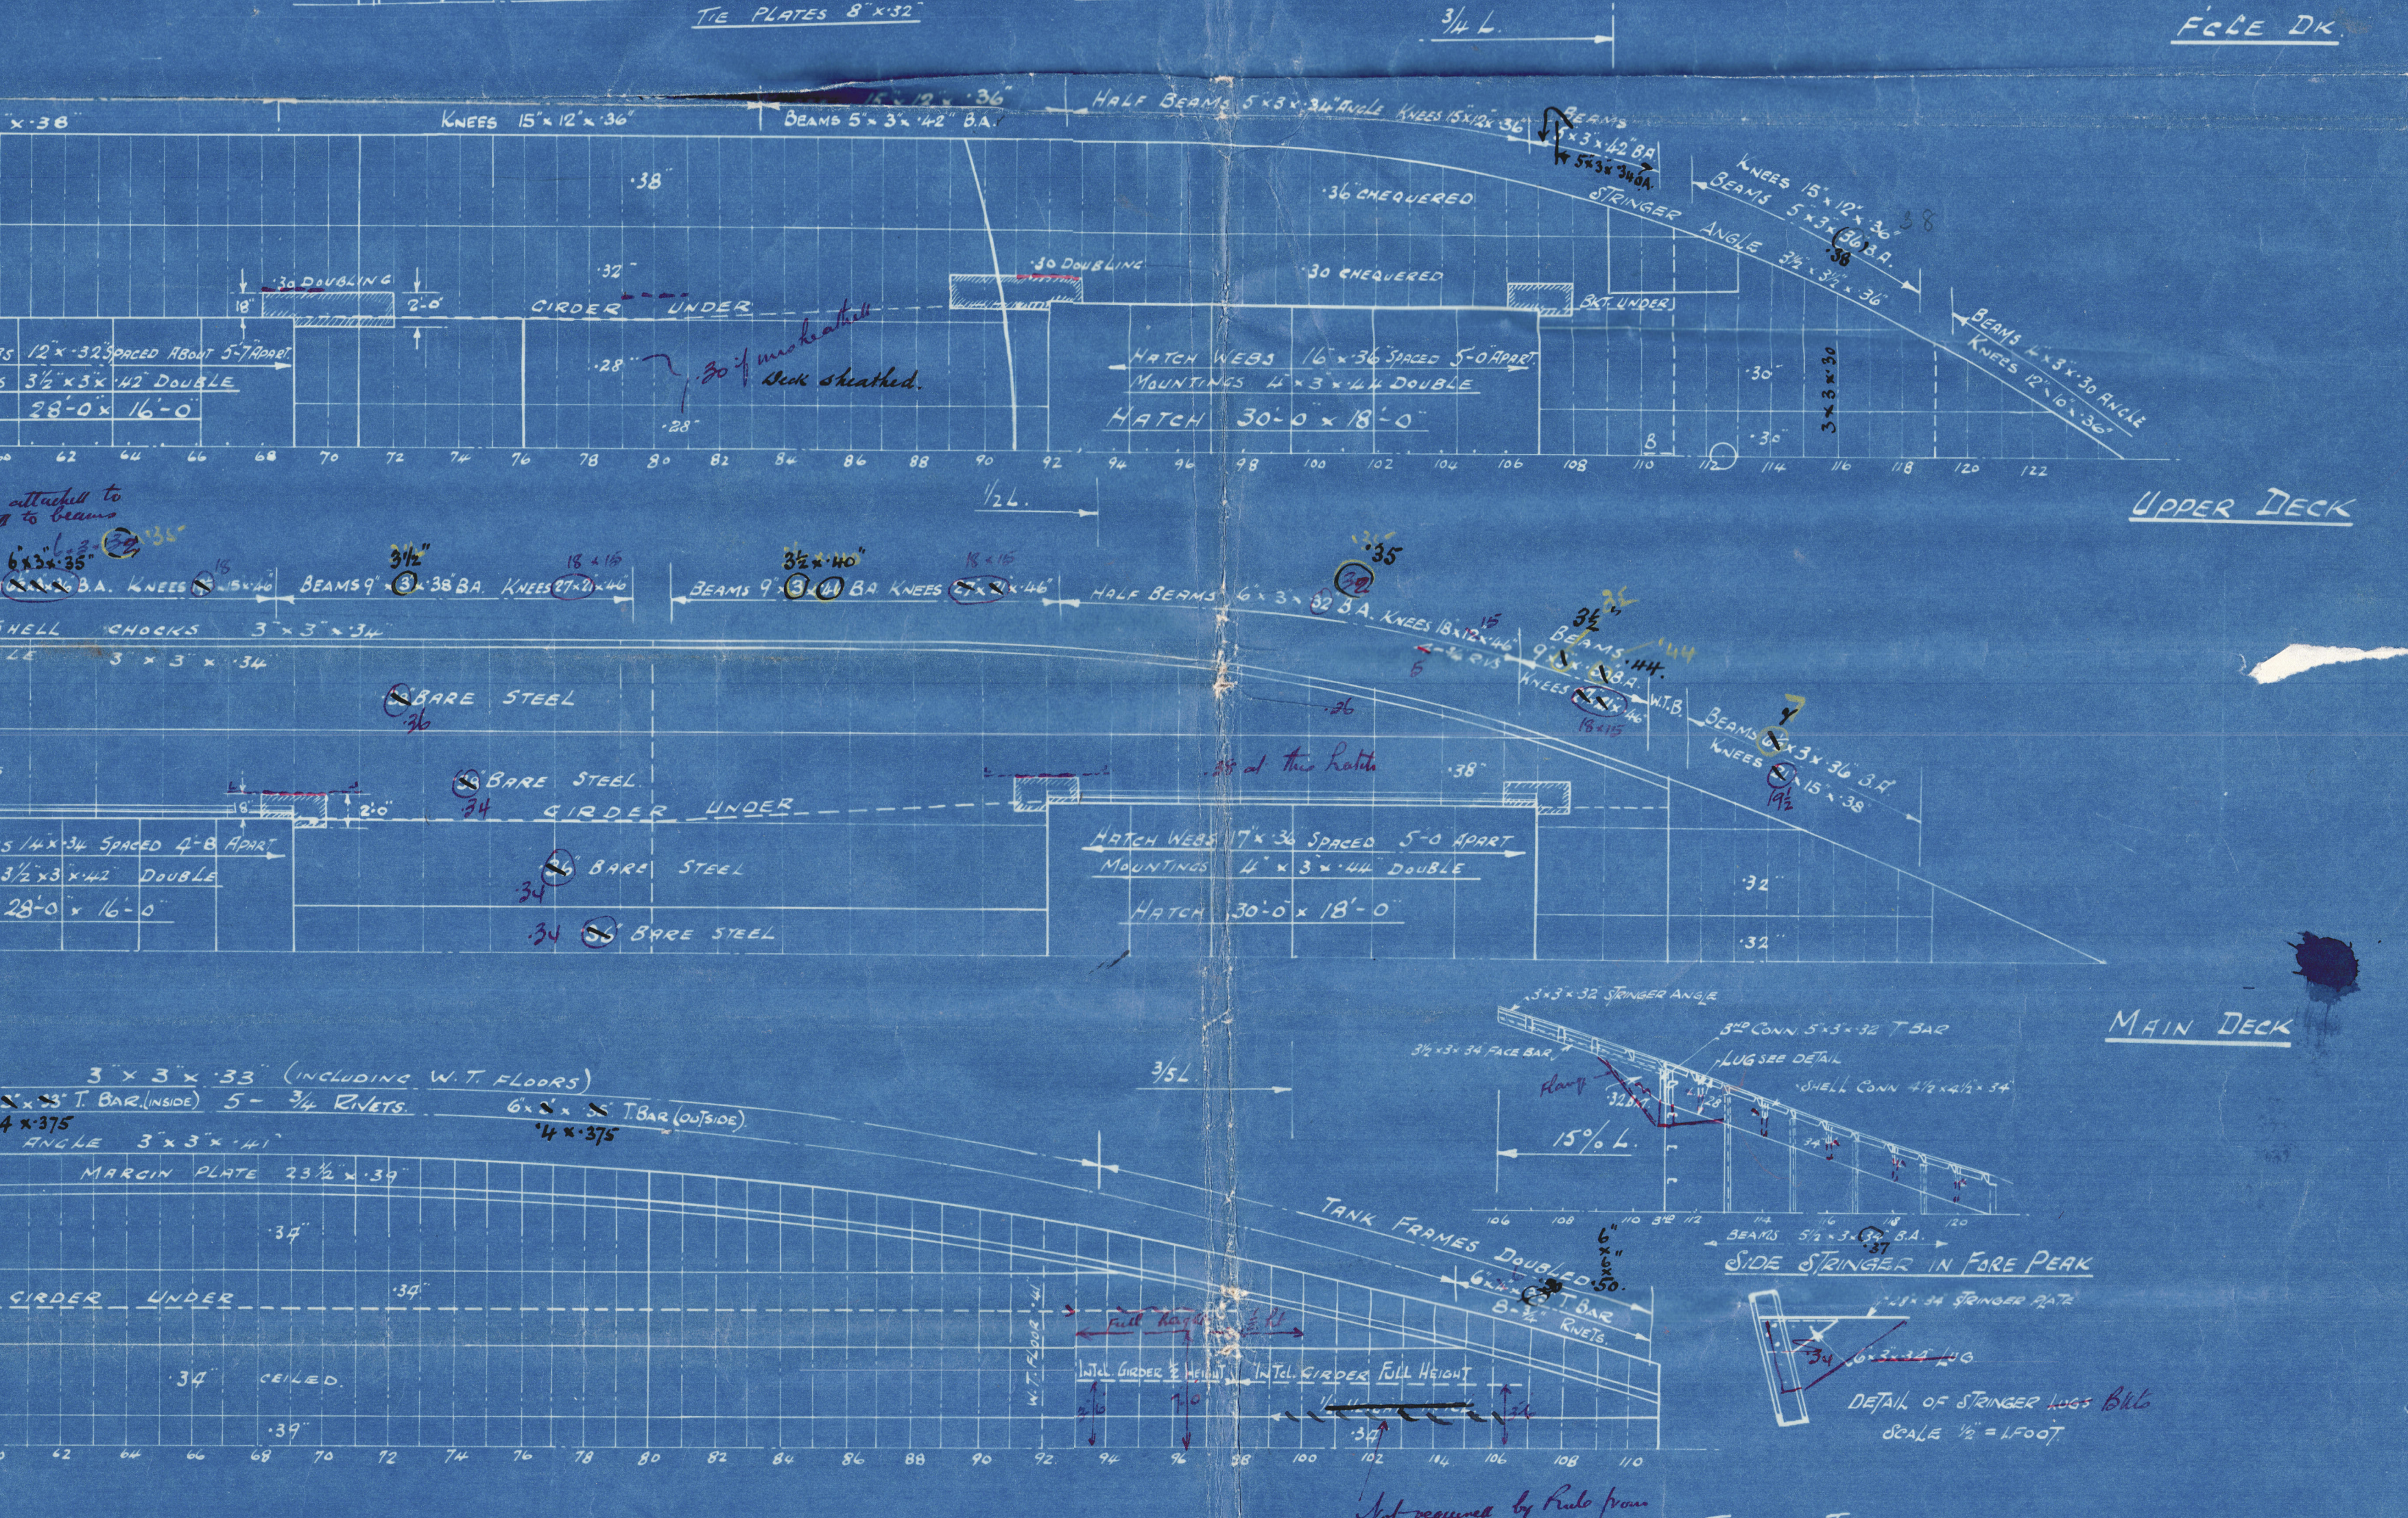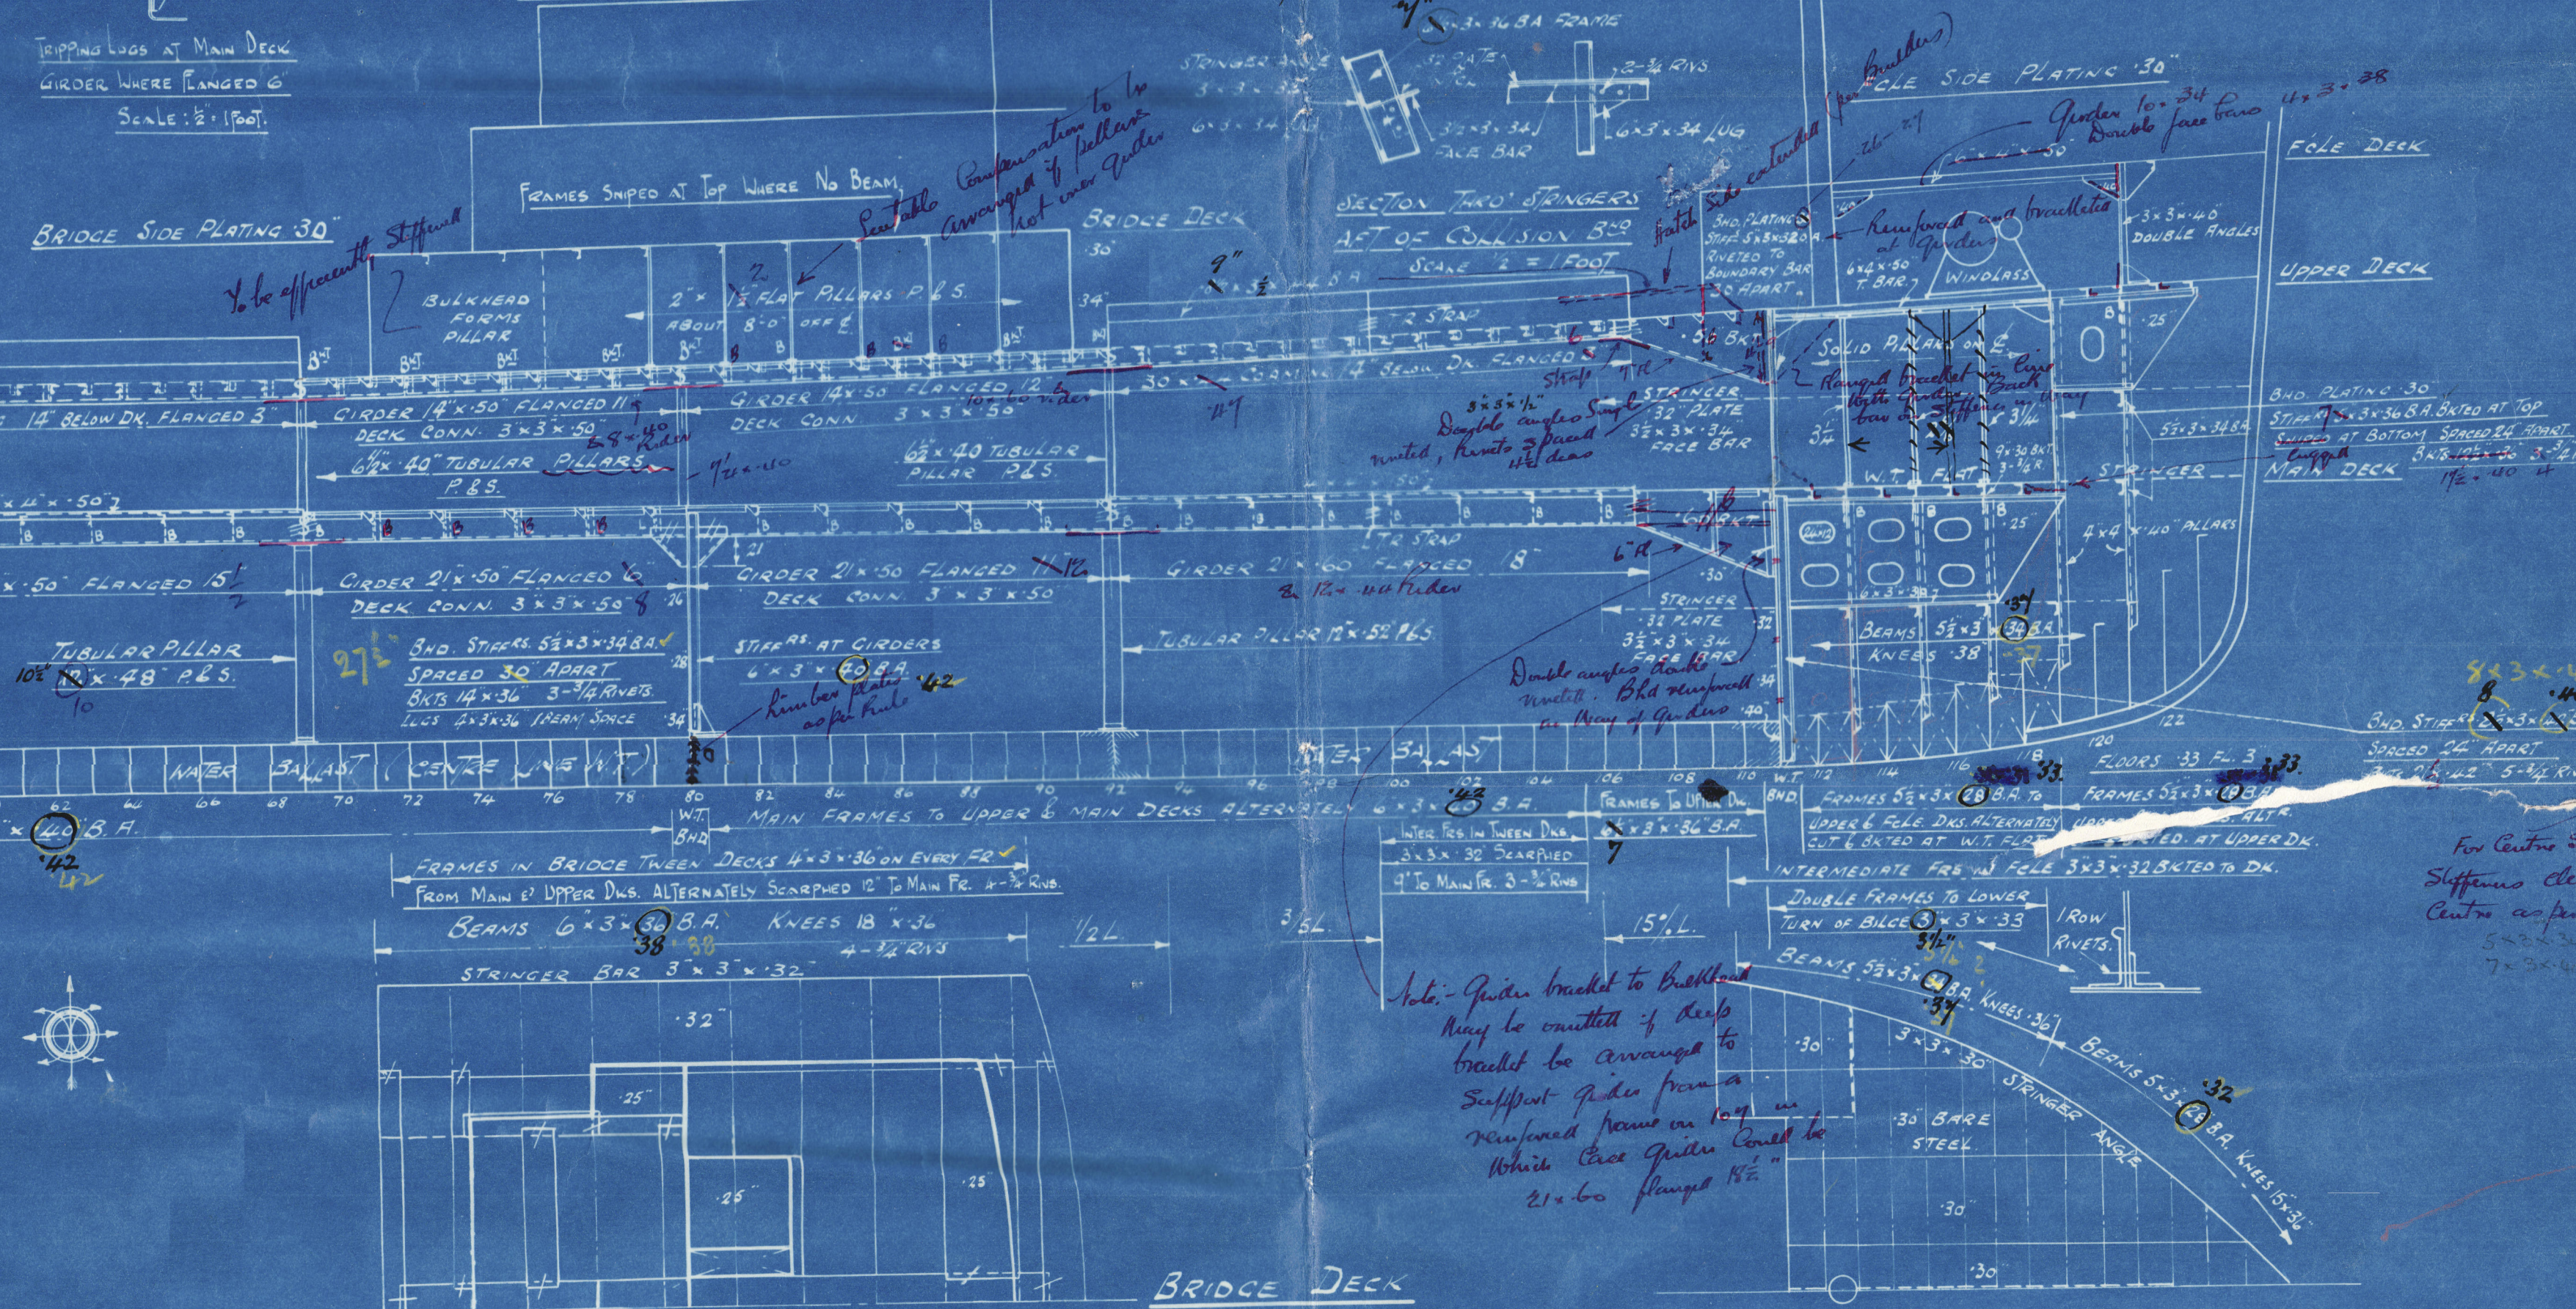

TANK TOP

APPROVED

REGISTER OF SHIPPING

4434 2020

Lloyd's Register

W350-00530000

Mexico, Ararossan Dockyard etc.

(1)

Yard No. 354.

Profile and Deck.

'Pacific Coast'

Pacific Coast ~~Ocean Coast~~

Prelim. Lbl
GLASGOW/REPORT No. 55171

Lbl
GLASGOW/REPORT No. 55763

GLASGOW REPORT No. 55801

W350-0053



© 2020

Lloyd's Register
Foundation

W350-0053