


SCALE $\frac{1}{8}" = 1 \text{ FT}$
DIMENSIONS:- 410' 0" PP. \times 53' 3" MLD \times 31' 1" TO UPPER DE.
TO CLASS 100 A-1 AT LLOYDS. (CARRYING PETROLEUM IN BULK.)
UNDER DECK TONNAGE = 5190.2

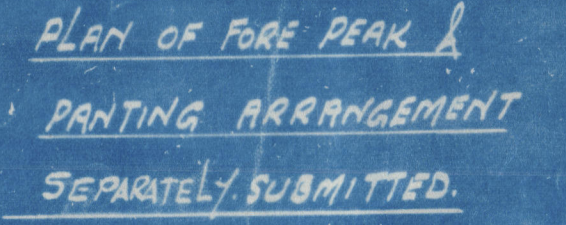

12.4
Swan Hunter's No 1244

S.S. Oiltrader

Profile & Deck as Built

S.S. OILTRADER
NEWCASTLE ON TYNE.

Report No. 821251



© 2008
W350 018

Lloyd's Register
Foundation