

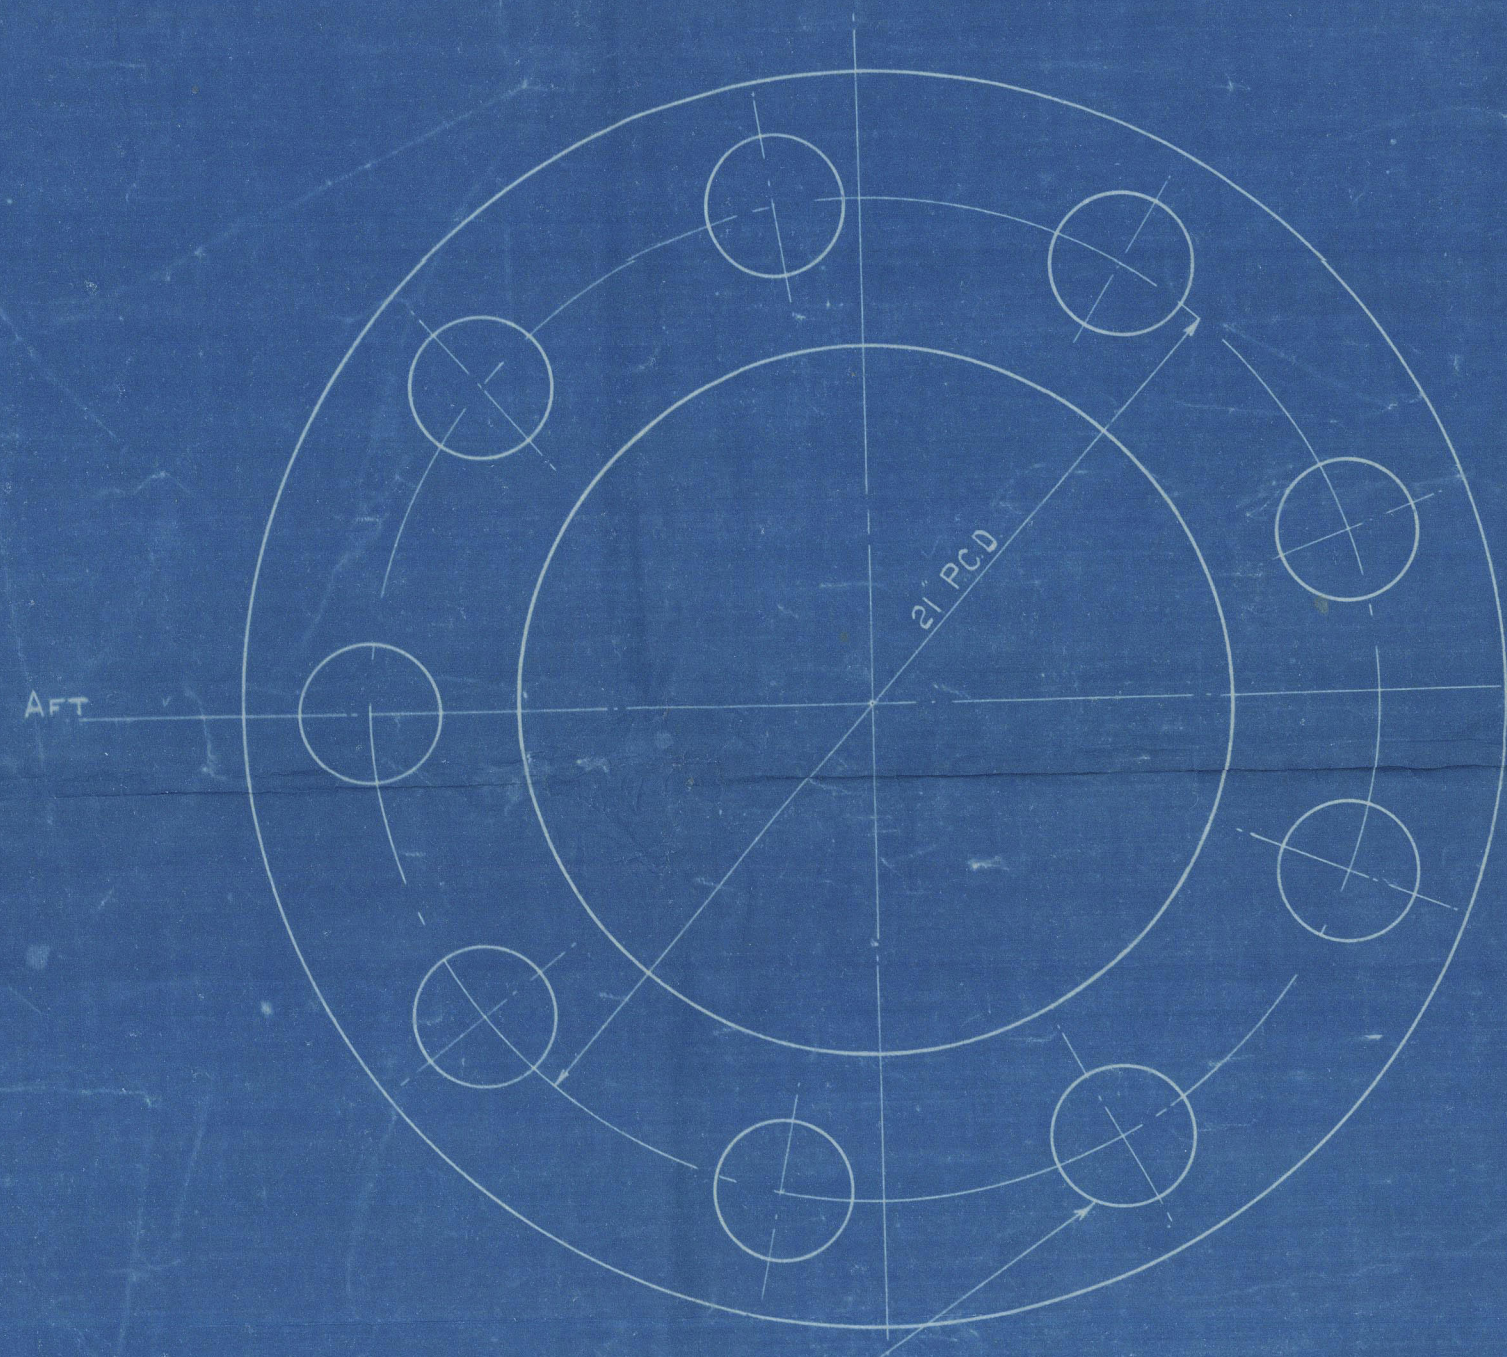
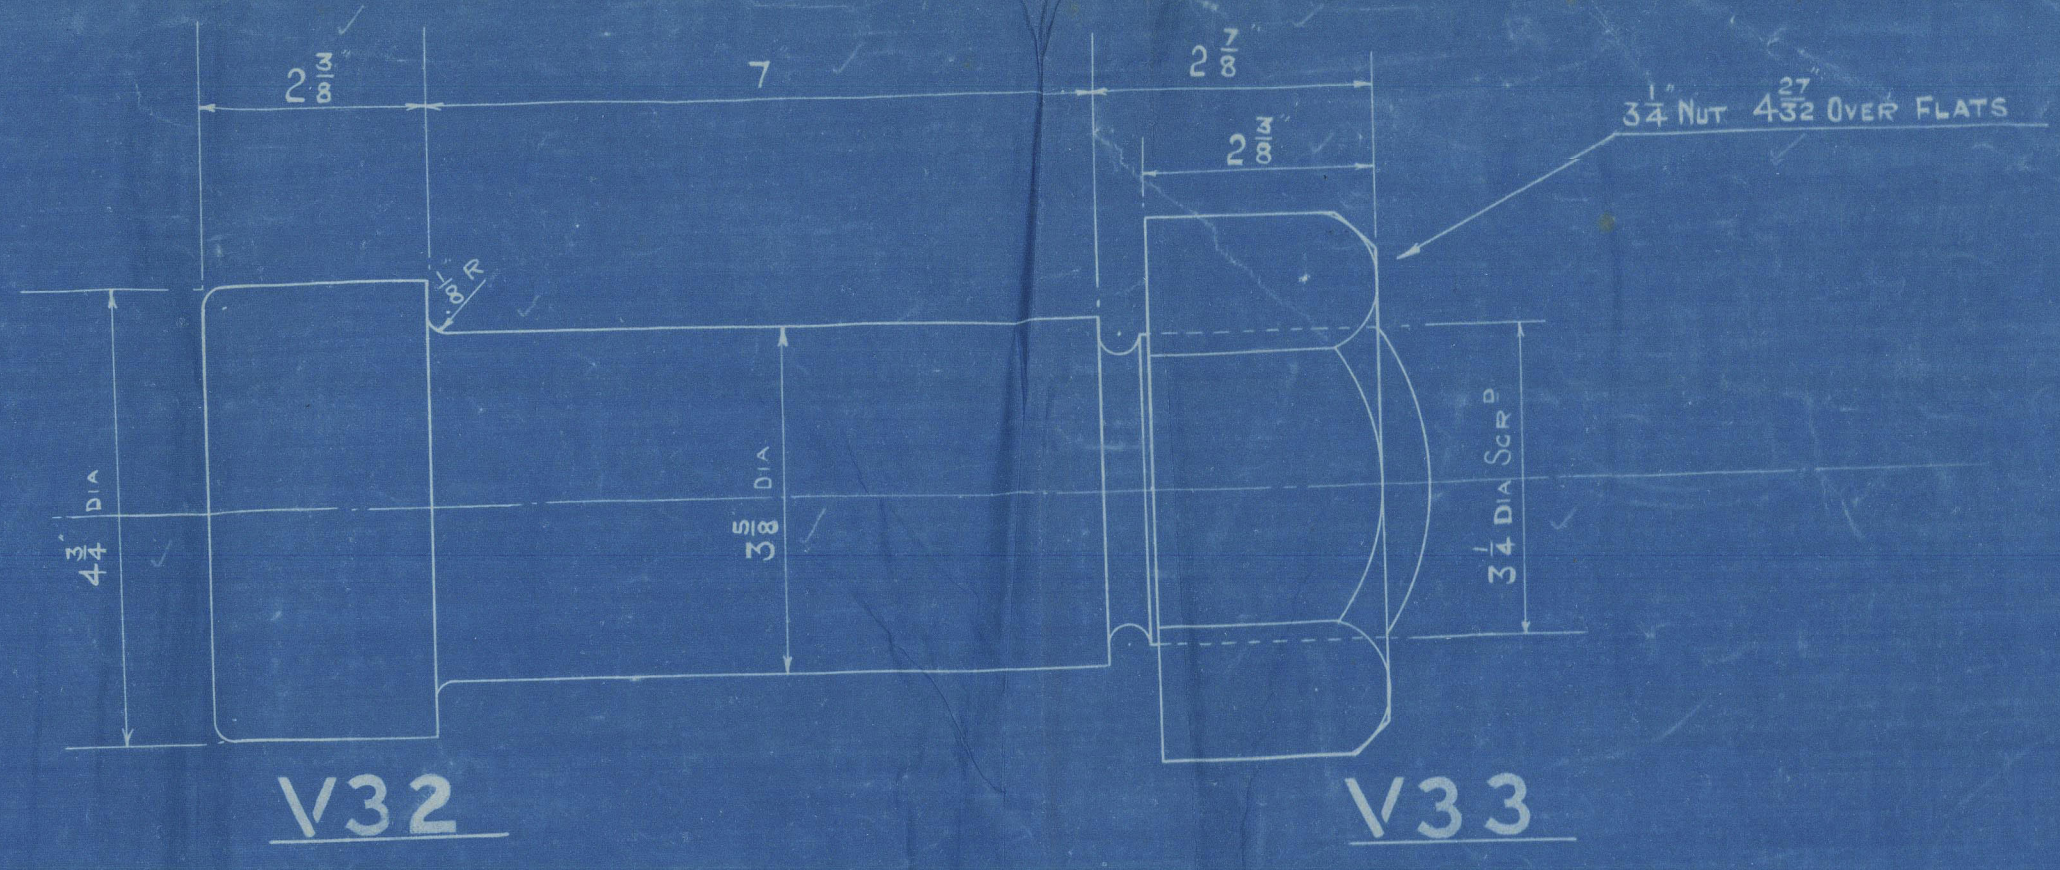


11/9/24

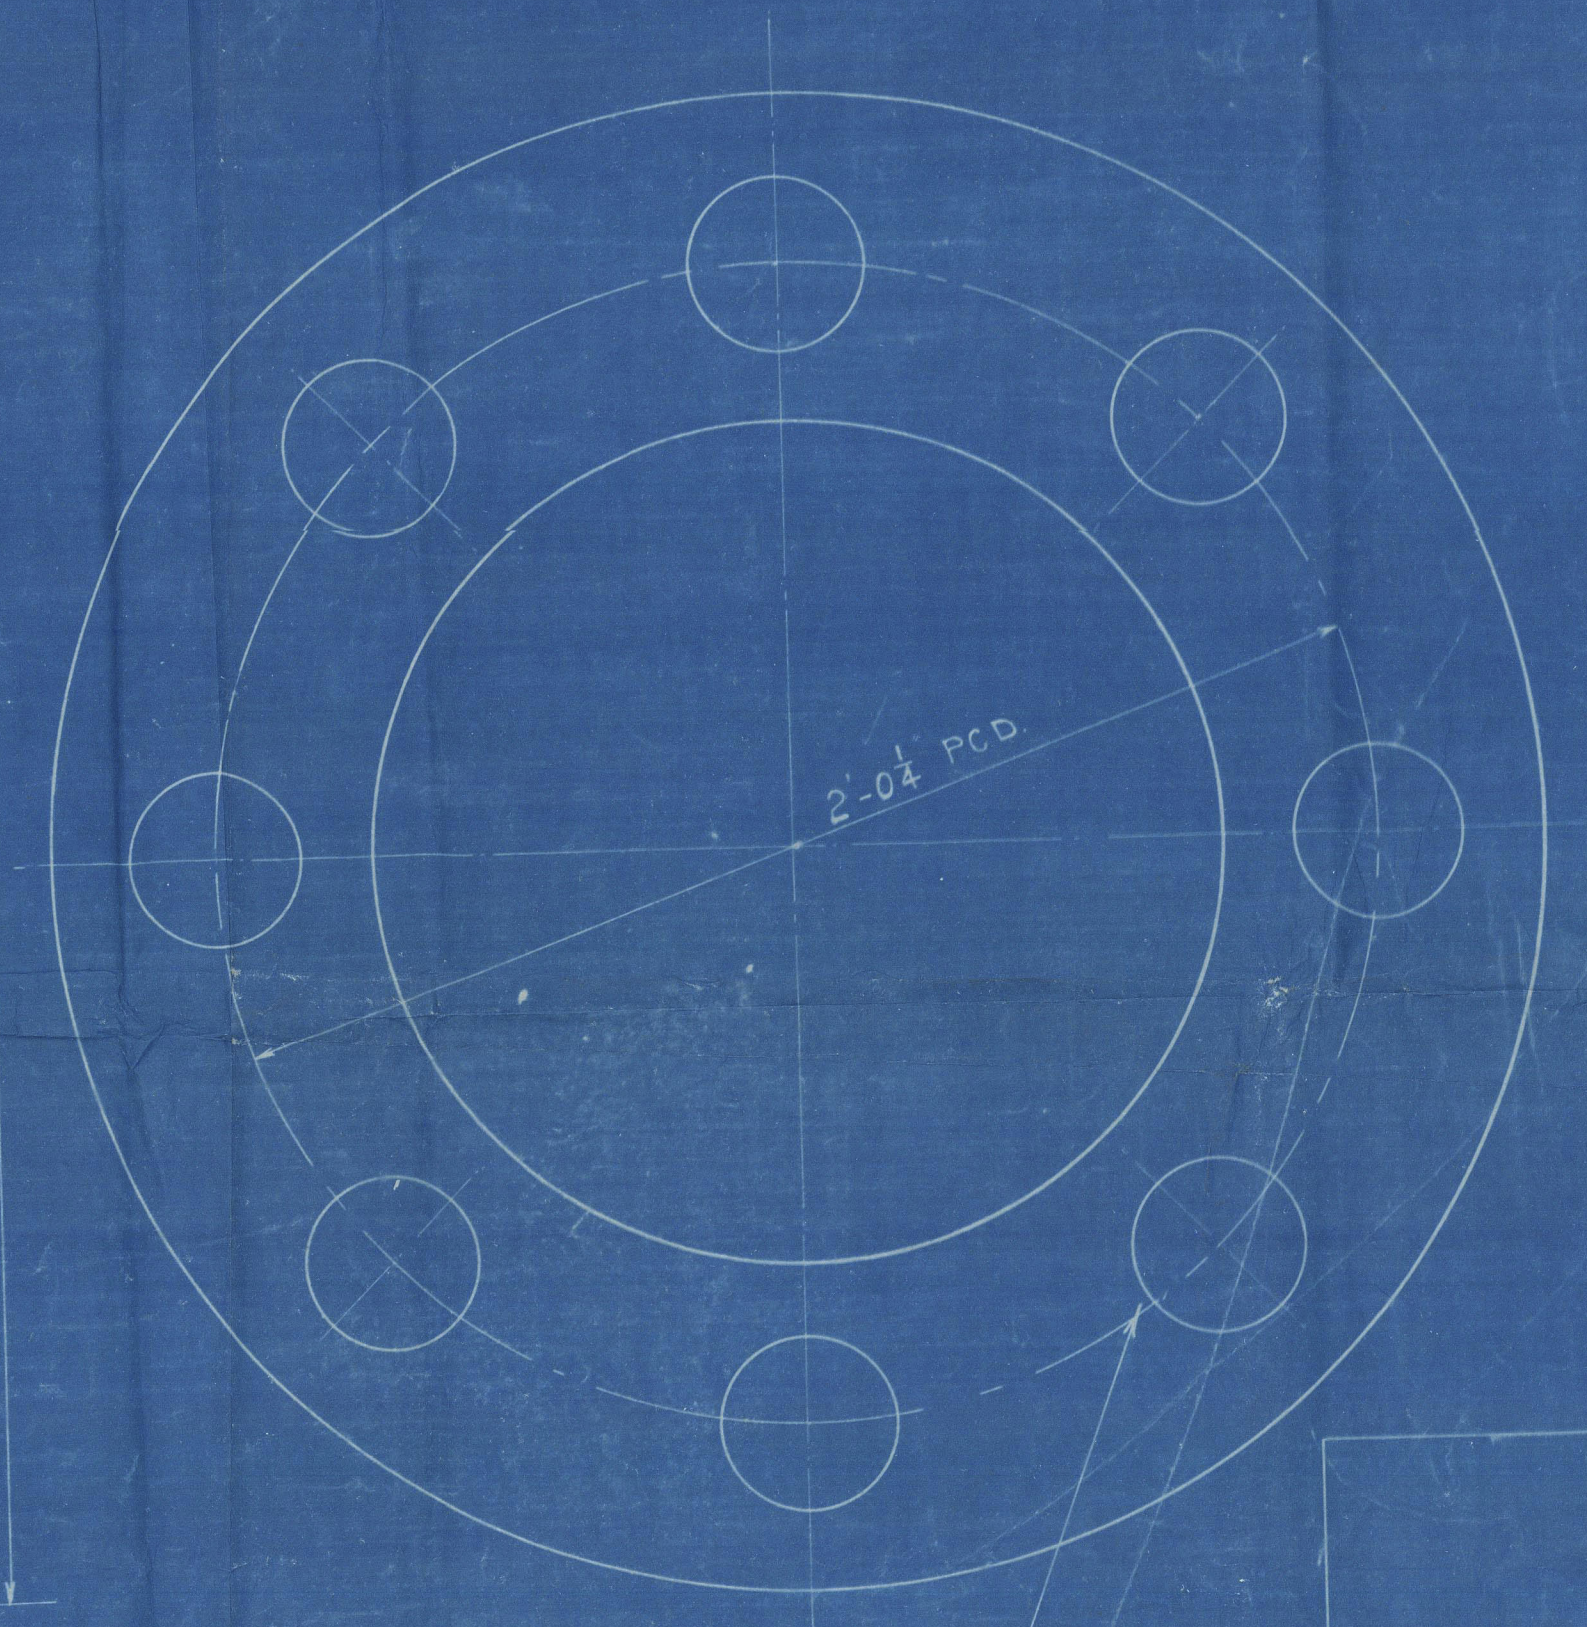

8 HOLES REAMED 3\"/>

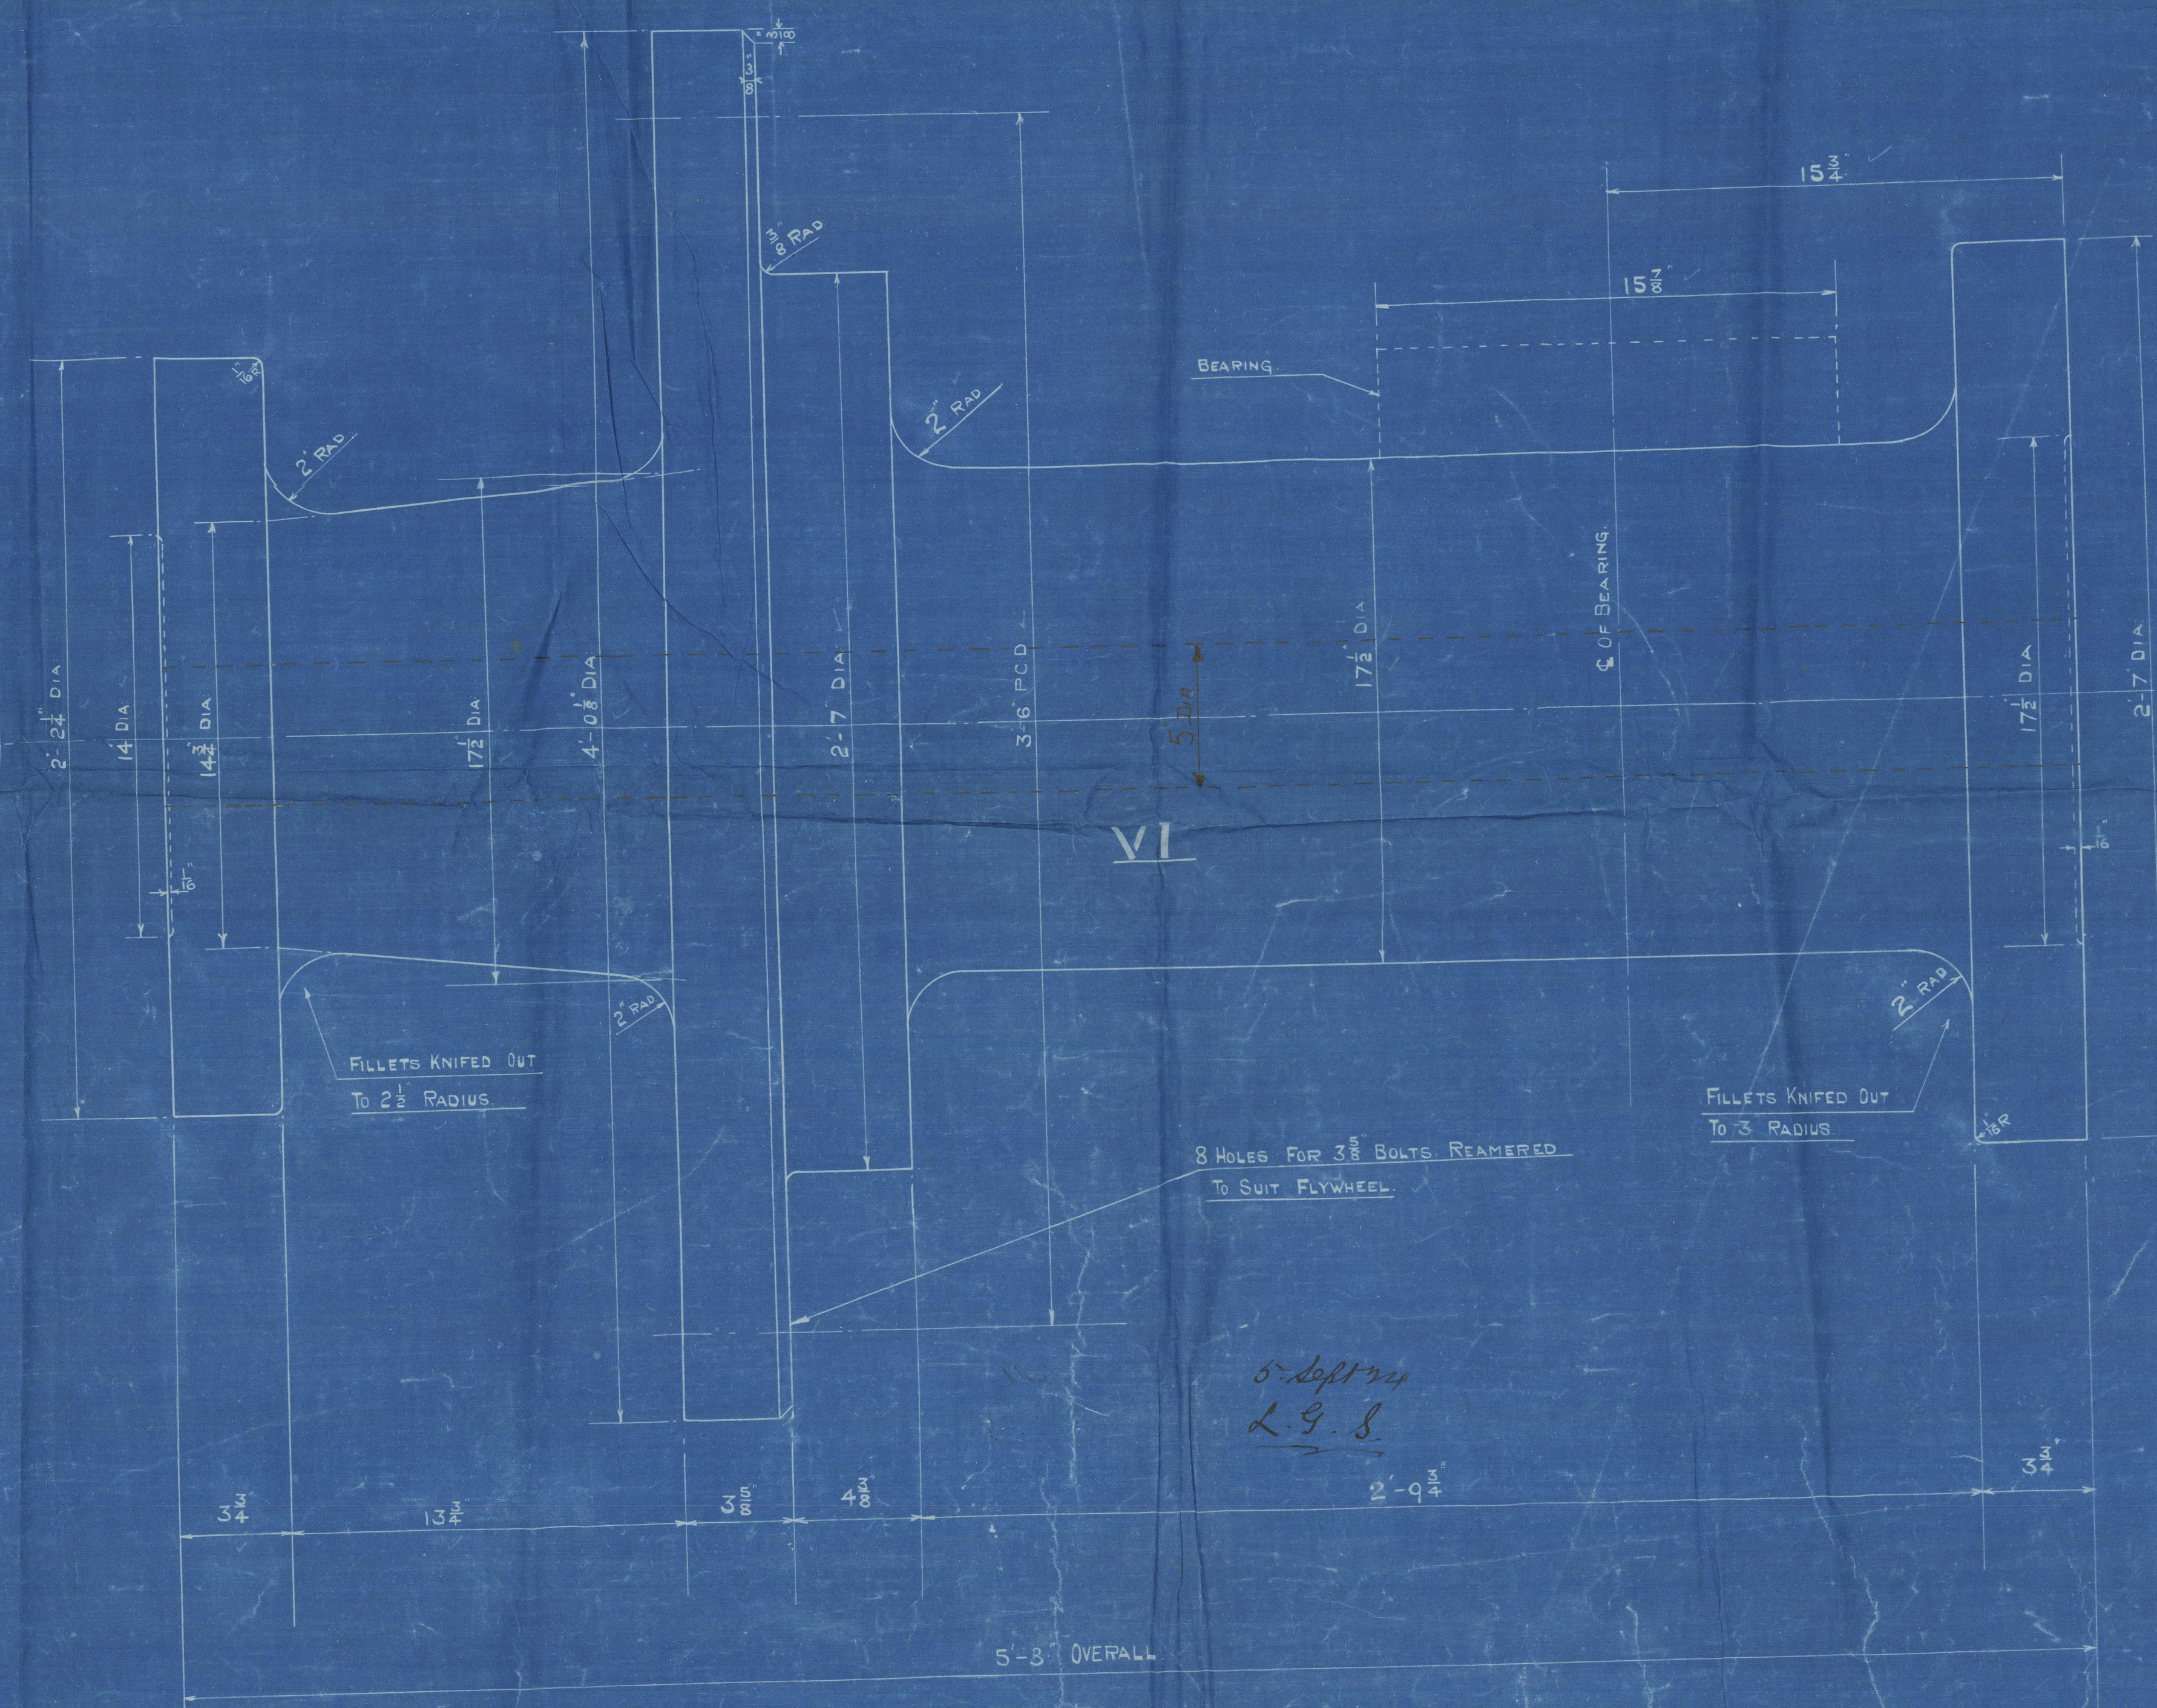

THESE HOLES TO SUIT AFT CRANKSHAFT (COUPLING)

GROUP	DESCRIPTION	MATERIAL	REMARKS	B.S.N.	
				WT OF EACH PART LBS	N° OFF.
VI	SHAFT	S.M.I.S.	ORDERED OUT.		1
V32	COUPLING BOLTS	STEEL	MAT. ORD. OUT.		8
V33	" BOLTS NUTS	WROUGHT IRON	"		8

DRCN°4S5

FLYWHEEL SHAFT

SCALE 3\"/>

SWAN, HUNTER, & WIGHAM RICHARDSON LTD
ENGINEERING DEPARTMENT
NEPTUNE WORKS,
NEWCASTLE-ON-TYNE.
DATE: 11/9/24

	TYPE	ENGINE N°	DATE
SS	BSN	1196	10-12-23
SINGLE	BSN	1196	12-28-24

S. H + WR

1196

Flywheel shaft

Drawing. 485

Submitted to London 5/9/24

2 holes through shaft

approved 11/9/24

SH over advised 12/9/24

RETAIN


M. V. BRITISH PETROL

NEWCASTLE ON TYNE.

Report No. 79675

RETAIN

W3S1-0020

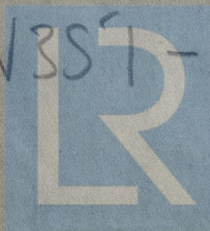

Lloyd's Register
Foundation