


Sent by Bel. Sarracoz
to go with Report No. 645

Yapor Delfin.

ex Opatic

(chute de la reforma)
Before the alterations
Principal openings permanently closed shown
coloured Red - by dark shades resulting ports also closed.
Escala 1/8" = 1' pie.

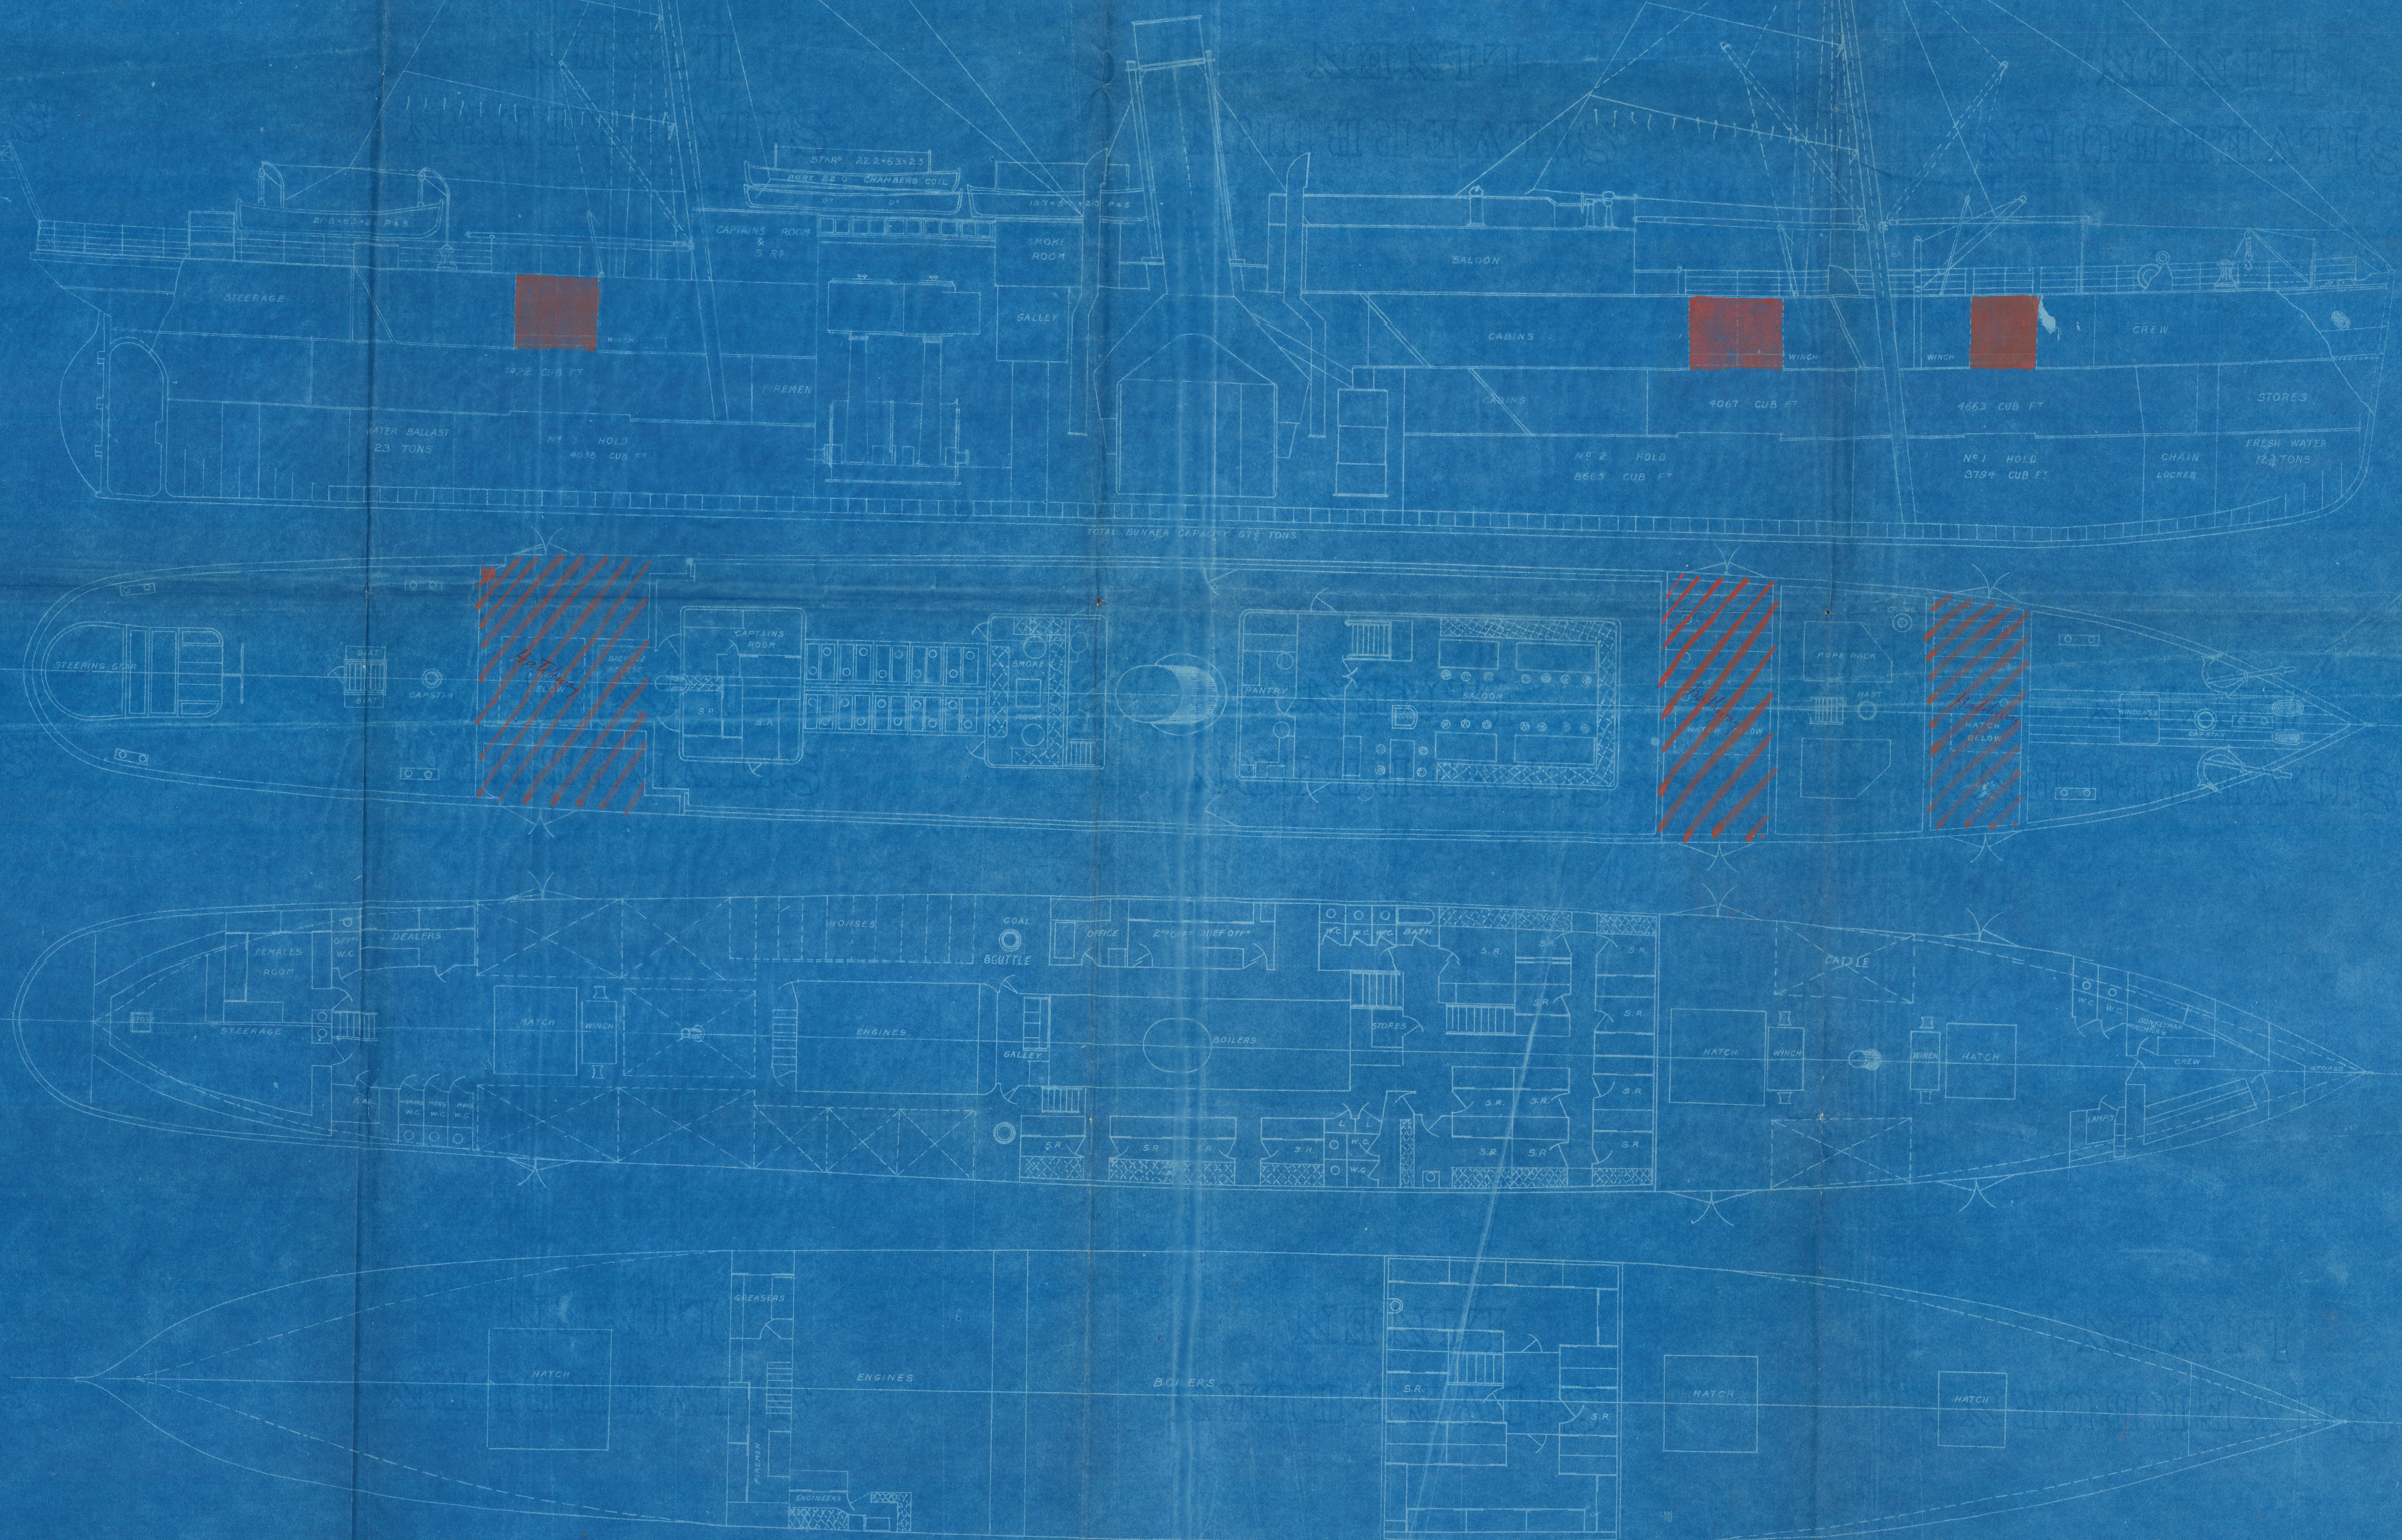

THESE PARTICULARS ARE BELIEVED TO BE CORRECT BUT ARE NOT GUARANTEED

DELPHIN

Guard Book Bot

No 1

Bcl 645

W353B11-0002



© 2021

Lloyd's Register
Foundation



0002



© 2021

Lloyd's Register
Foundation