


Steel Bk "Elisabeth"

Plan of drillings taken 11.7.1916.

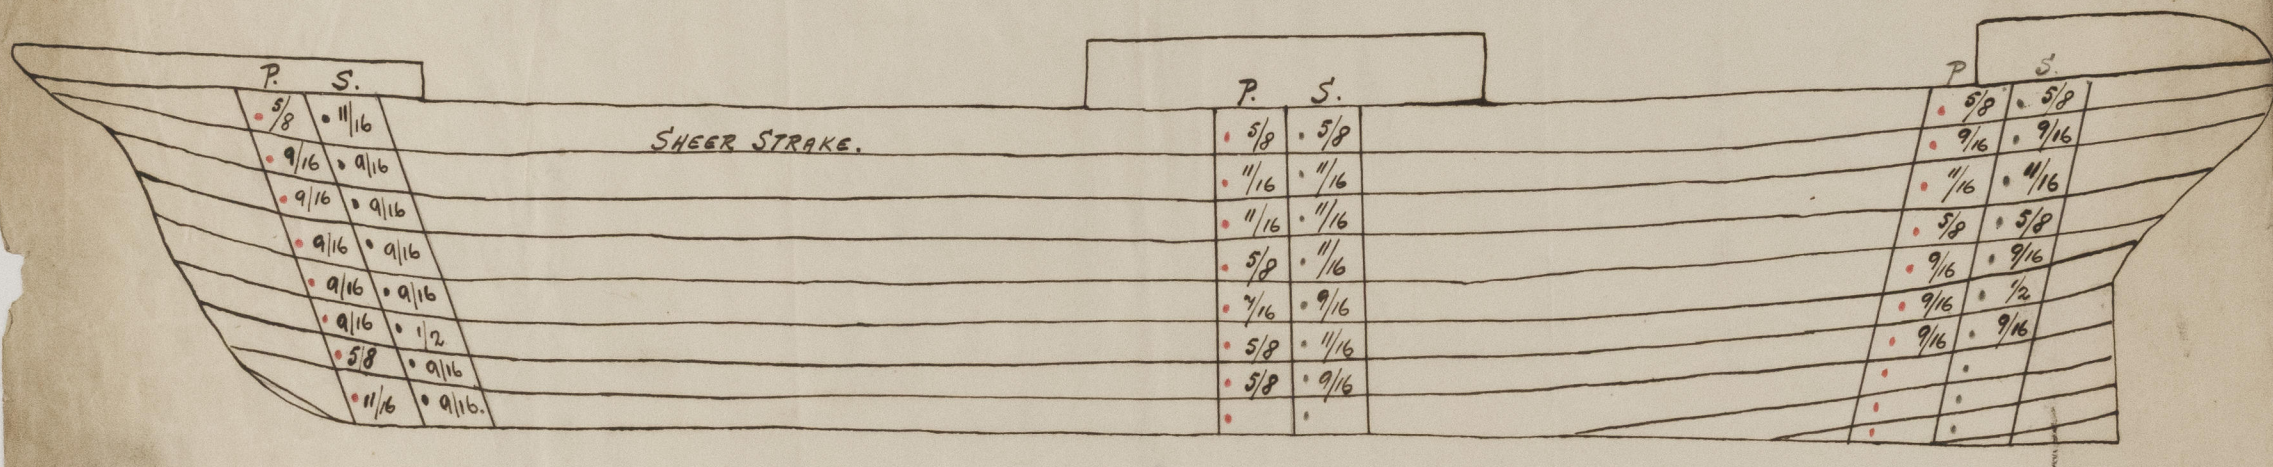

Note: Cement below 7. forward & below 6 midships & aft.

C. F. Smith

Surveyor to Lloyd's Register
Lloyd's Register
Foundation