


— LONGITUDINAL SECTION —



— END VIEW —


— SKETCH SHOWING —  
 — COLLAPSED FURNACE OF DONKEY BOILER —  
 ON  
 — S.S. "FLORIDA" —  
 — Scale 1 1/2 in. = 1 ft. —

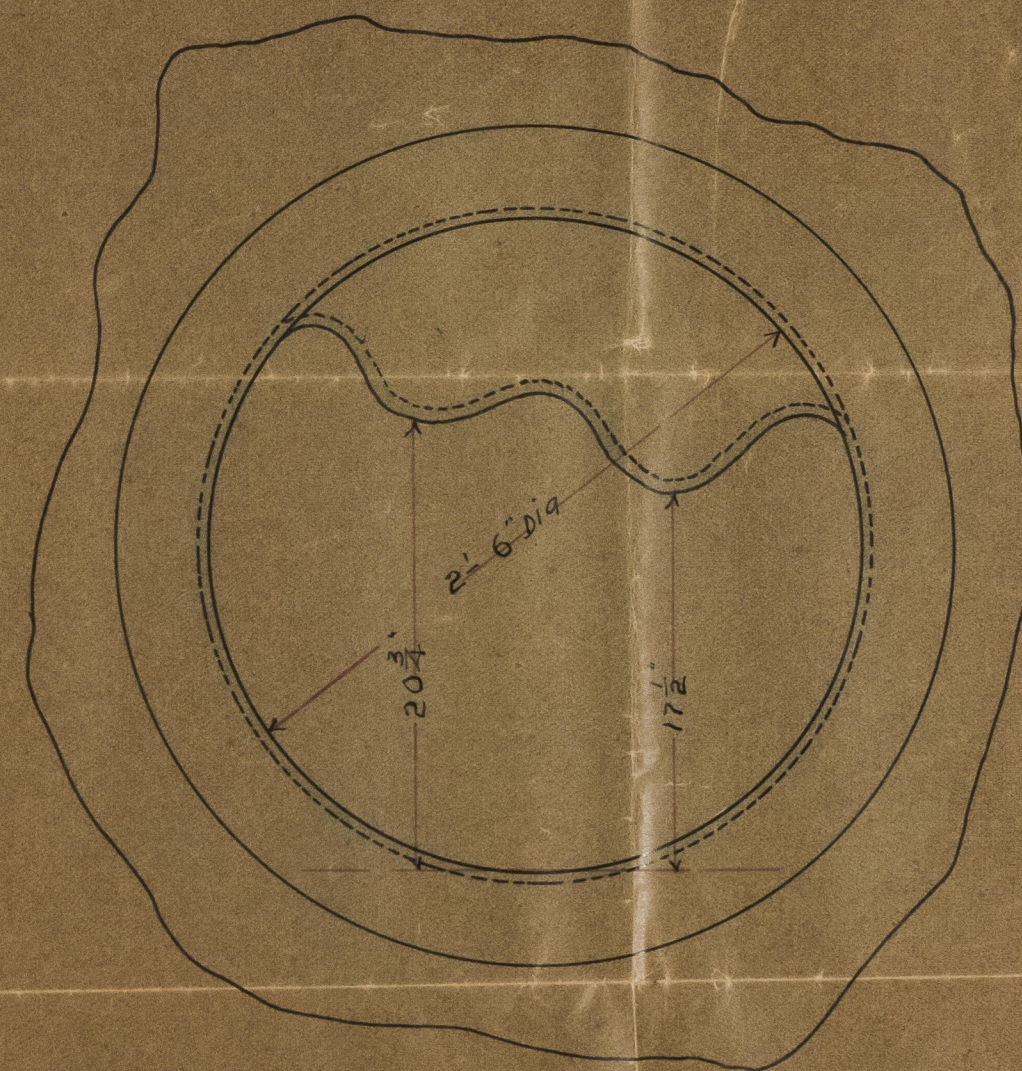

"FLORIDA"

CAL 2384

Guard Book  
Box 4

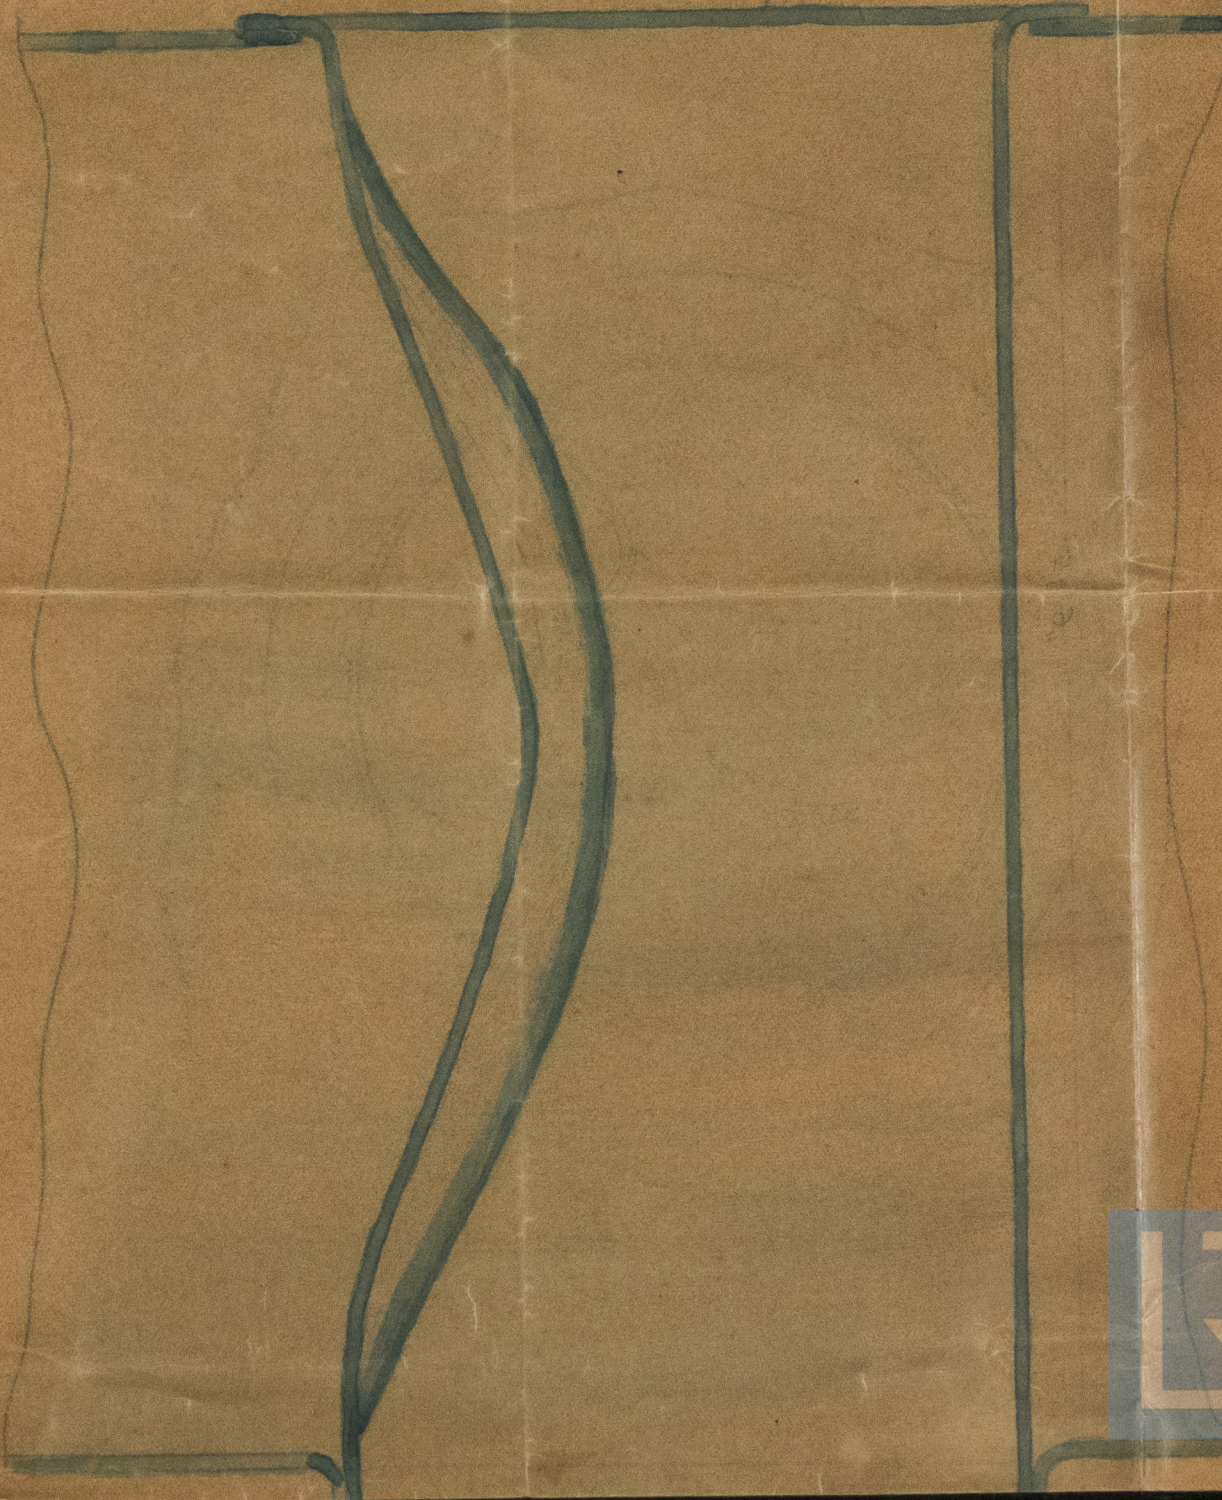

LONGITUDINAL SECTION



© 2021  
Lloyd's Register  
Foundation

W35785-0004