

# ELFLEDA.

OIL TANKS IN ENGINE ROOM.  
FRAMNÆS. MEK. VERKSTED. PR. SANDEFJORD.

10-2-15

19/2/15

6" x 1/4" Tie bars 1/2" rivets








TANKS TO BE BUILT OF 1/4" PLATE;  
BREADTH OF SEAMS AND BUTTS: 3 3/4";  
DOUBLE CHAIN RIVETING, 5/8" DIA. OF RIVETS,  
2" PITCH; END PLATES FLANGED AND  
DOUBLE RIVETED TO SIDES.  
ANGLE STAYS: 2" x 2" x 1/4".  
TANKS TO BE TESTED WITH 12' HEAD OF WATER.

Seams to be caulked

1/4" Tie plates 1/2" rivets

J.P.R.  
19.2.15

J.P.R.  
19.2.15

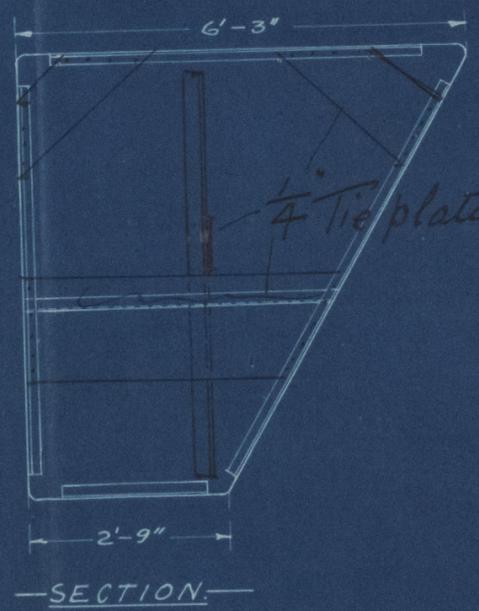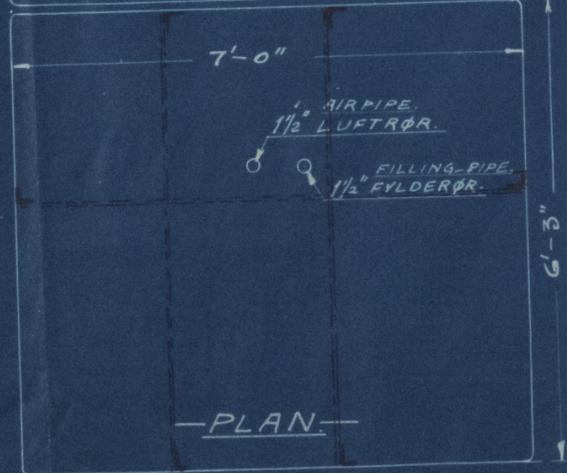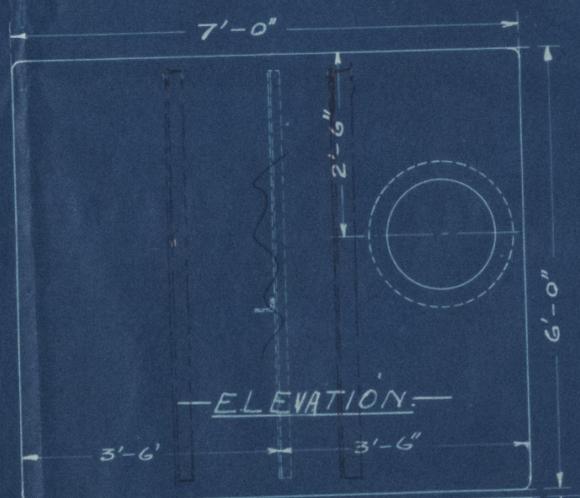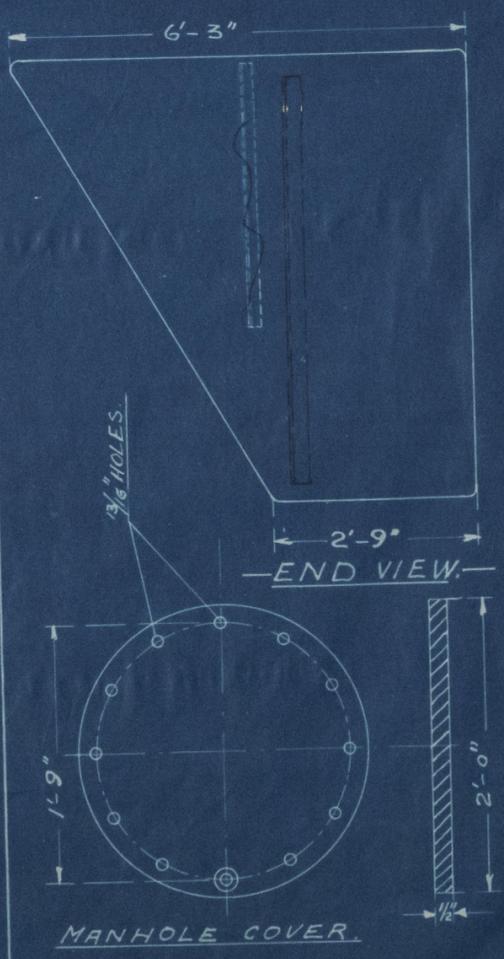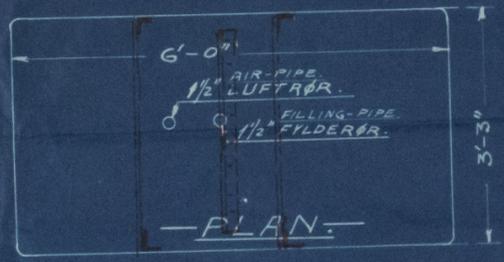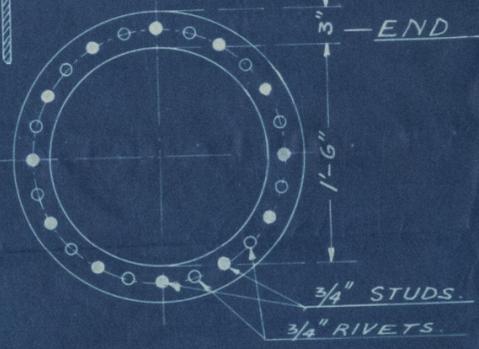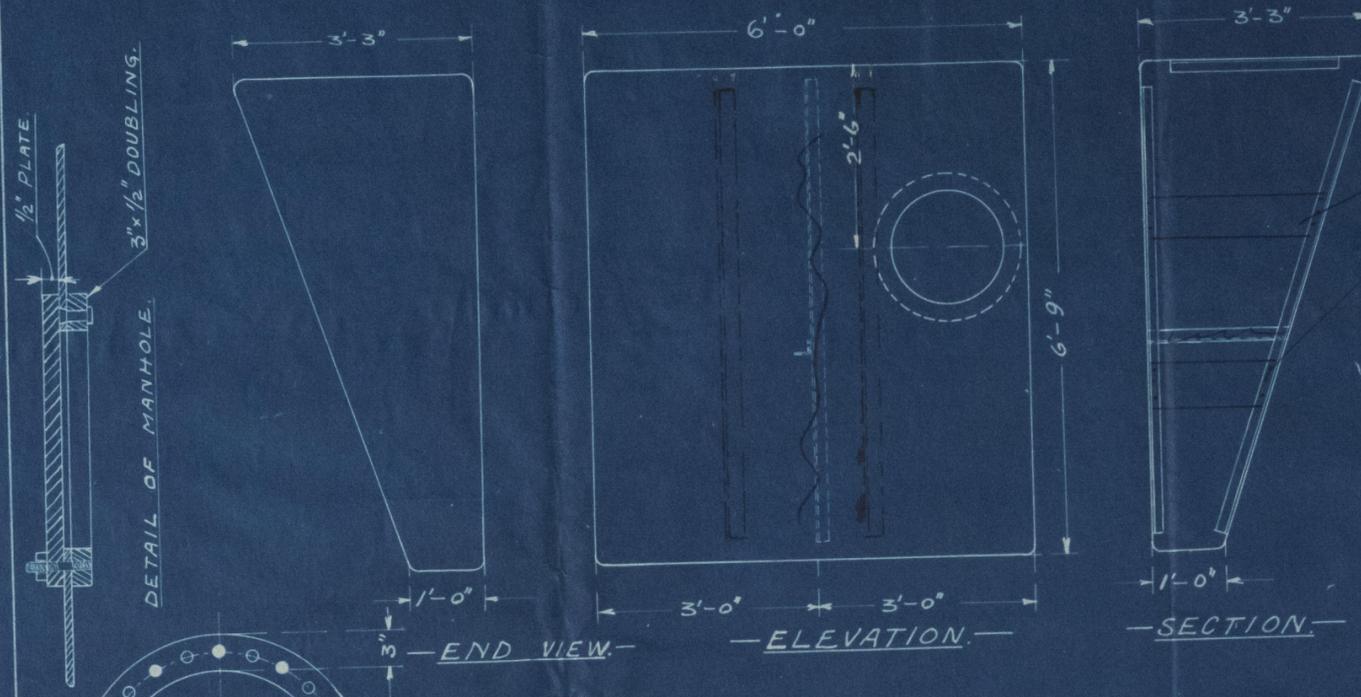

Elfleda  
Tanks

0006

W358139 - 0006

ELFLEDA

Xia 1477

Grand Book Box 5



© 2021

Lloyd's Register  
Foundation